

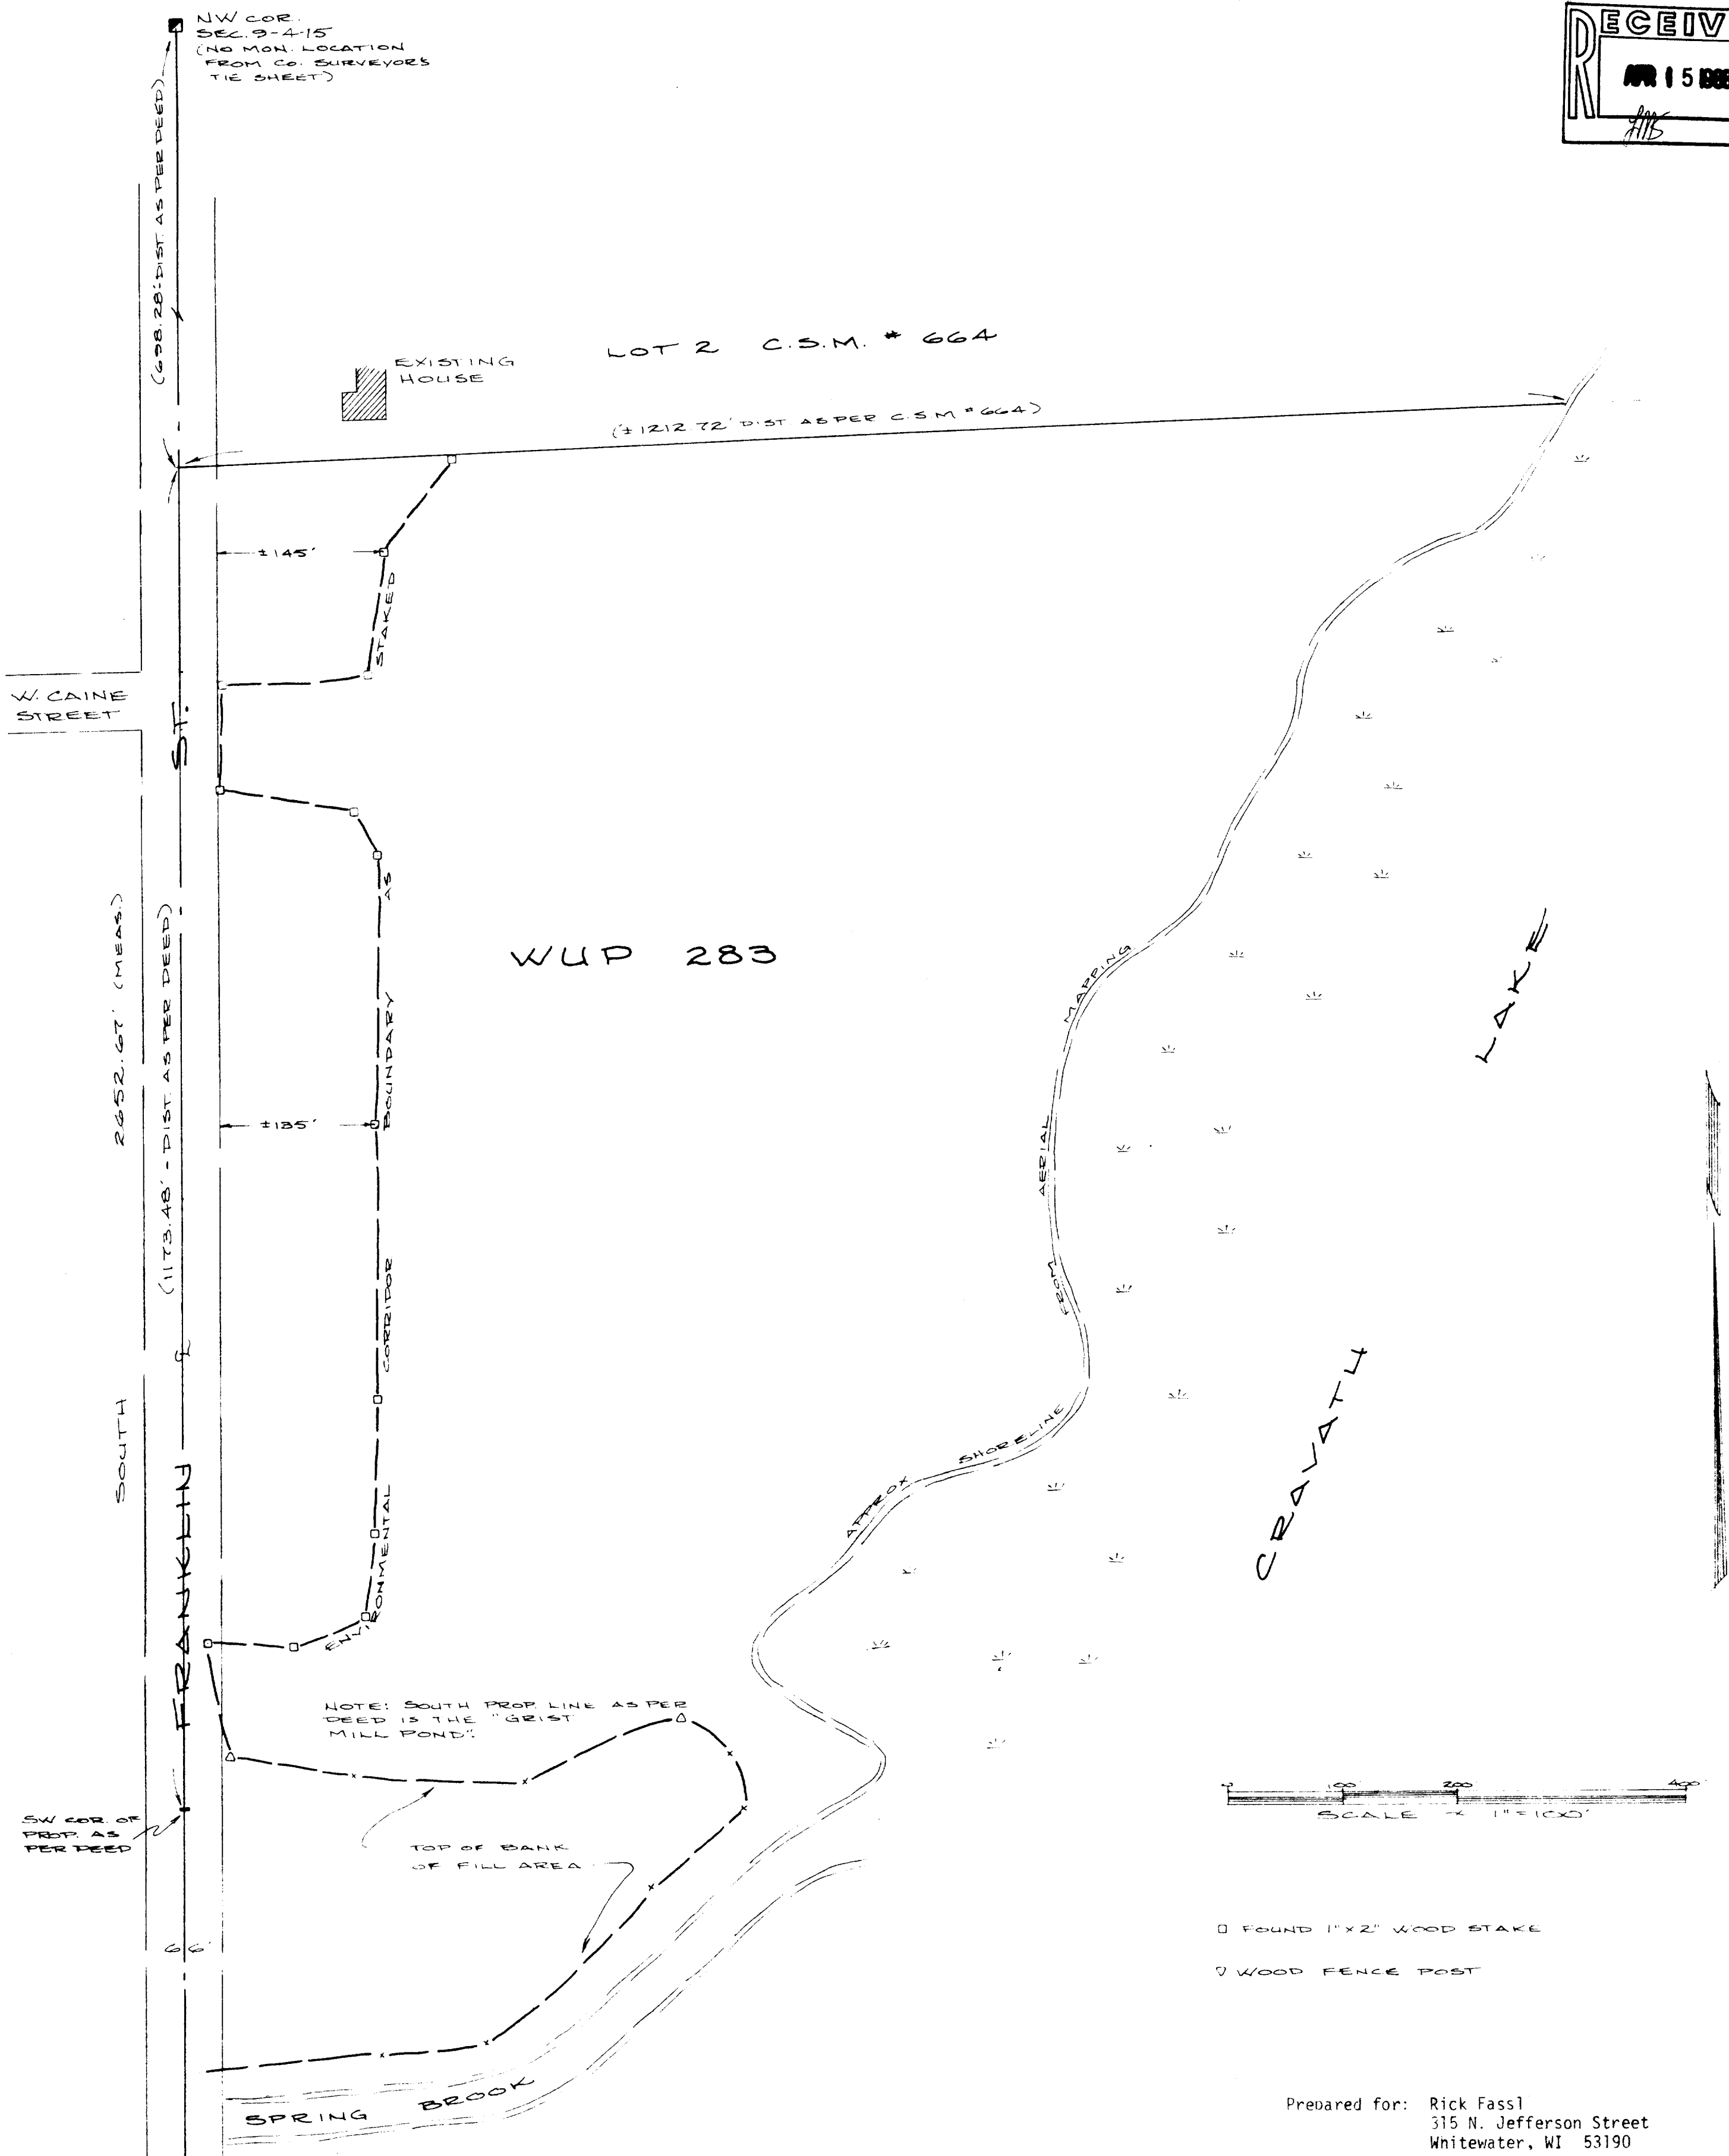


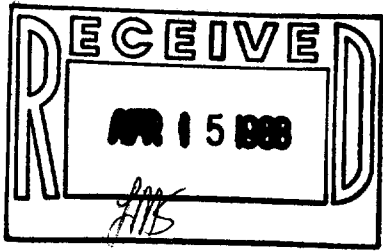

PLAT OF SURVEY
To determine environmental corridor boundary in part of the NW¼ of Section 9, T4N, R15E, City of Whitewater, Walworth County, Wisconsin.
I hereby certify that I have surveyed the environmental corridor shown above and that this map is an accurate representation to scale of same.

Date 4

James B. Woodman
Registered Land Surveyor, S-1234

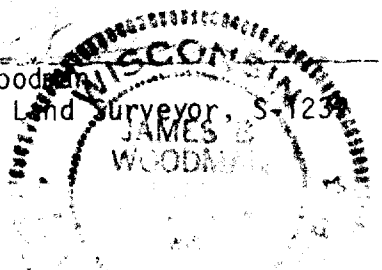

WOODMAN, ANDERSON & ASSOCIATES
land surveyors
210 Madison Avenue (414) 563-8162
Fort Atkinson, Wisconsin 53538

PLAT OF SURVEY
IN THE NW¼ OF SECTION 9, T4N,
R15E, CITY OF WHITEWATER

DATE		DATE		SCALE	
DSN.		REV.		1"=100'	
DRN.	JBW	REV.		JOB NO.	885-32
APPR.	JBW	REV.		SHEET 1 OF 1	

WUP 283