


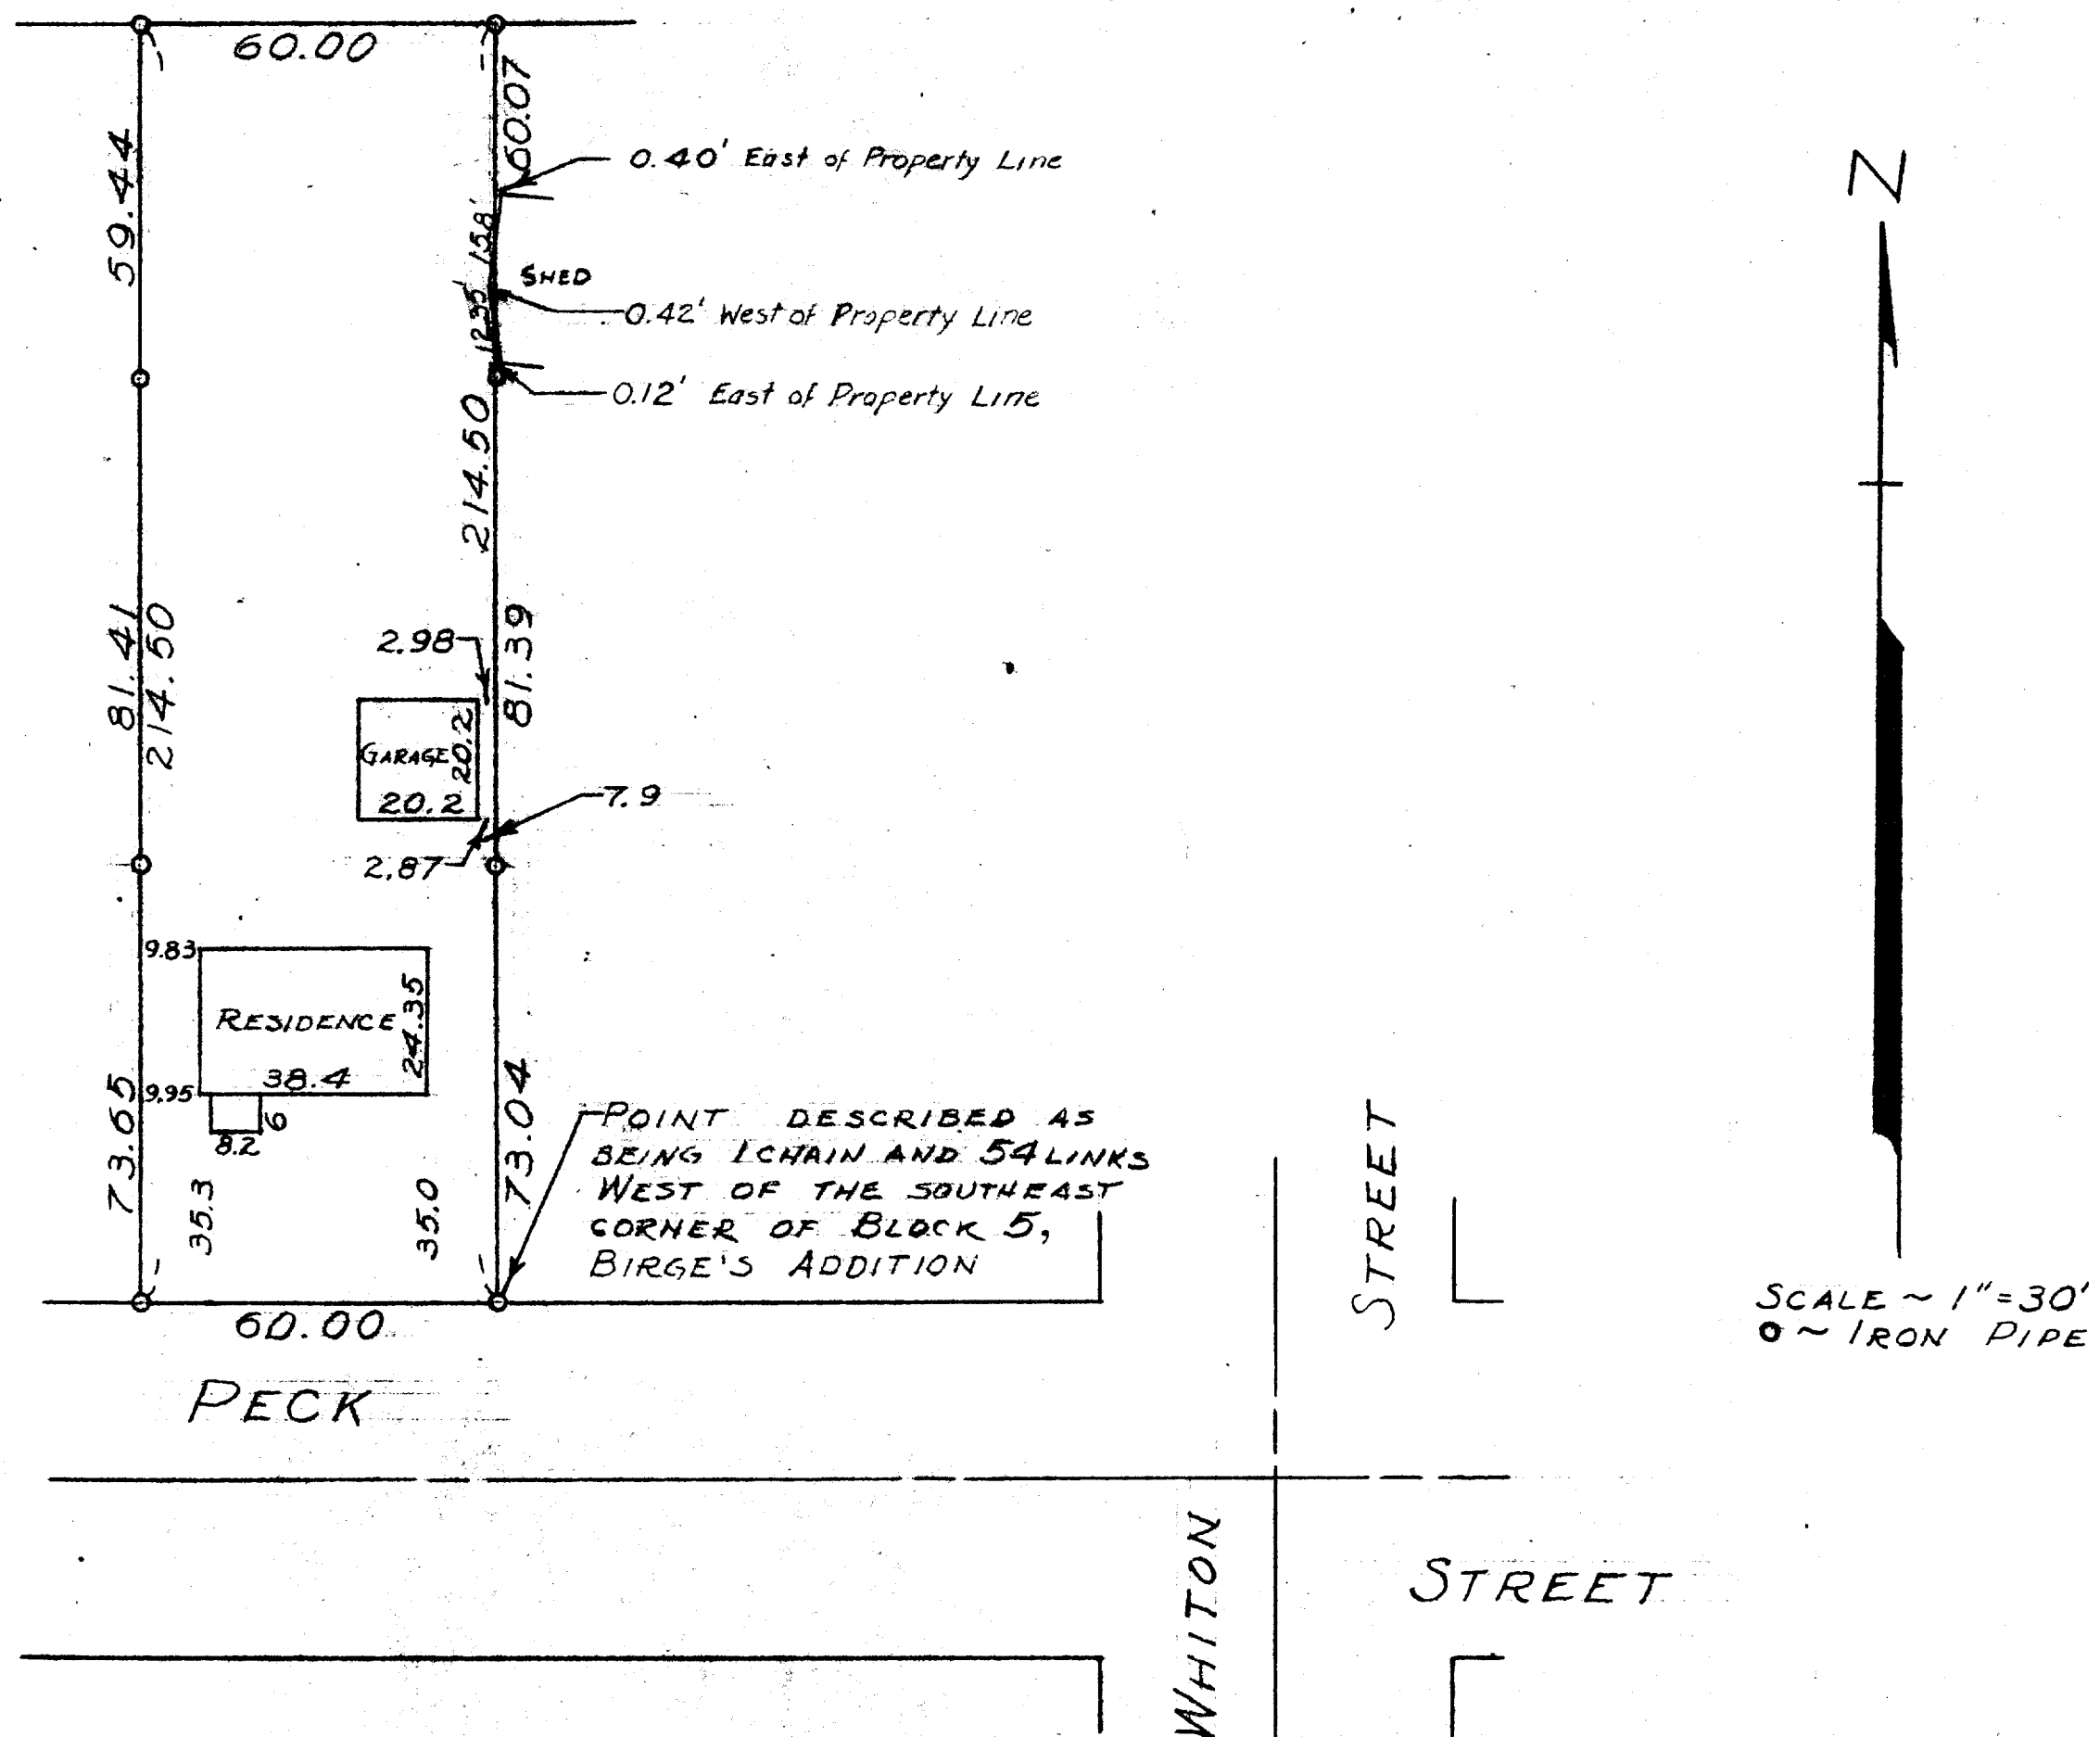

STATE OF WISCONSIN } ss.
COUNTY OF WALWORTH }

I, GEORGE T. DUNHAM, DO HEREBY CERTIFY THAT I HAVE SURVEYED THE PROPERTY LOCATED IN WALWORTH COUNTY, WISCONSIN DESCRIBED AS FOLLOWS: THAT PART OF BLOCK 5 IN BIRGE'S ADDITION TO THE VILLAGE, NOW CITY OF WHITEWATER, AS NUMBERED ON THE PLAT RECORDED MAY 21, 1855, BOUNDED AS FOLLOWS: BEGINNING ON THE SOUTH LINE OF THE SAID BLOCK AT A POINT, 1 CHAIN AND 54 LINKS WEST OF THE SOUTHEAST CORNER OF THE SAID BLOCK AND RUNNING THENCE NORTH 3 CHAINS AND 25 LINKS PARALLEL WITH THE EAST LINE OF SAID BLOCK; THENCE WEST AND PARALLEL WITH THE SOUTH LINE OF SAID BLOCK, 60 FEET; THENCE SOUTH AND PARALLEL WITH THE EAST LINE OF SAID BLOCK, 3 CHAINS AND 25 LINKS TO THE SOUTH LINE OF SAID BLOCK; THENCE EAST ON THE SAID SOUTH LINE 60 FEET, TO THE PLACE OF BEGINNING.

AND THAT THE PLAT SHOWN ABOVE IS A CORRECT REPRESENTATION OF THE PROPERTY LINES AND BUILDINGS THEREON.

AUGUST 8, 1957
Revised: April 20, 1960

George T. Dunham
GEORGE T. DUNHAM, SURVEYOR
DELAWARE, WISCONSIN