


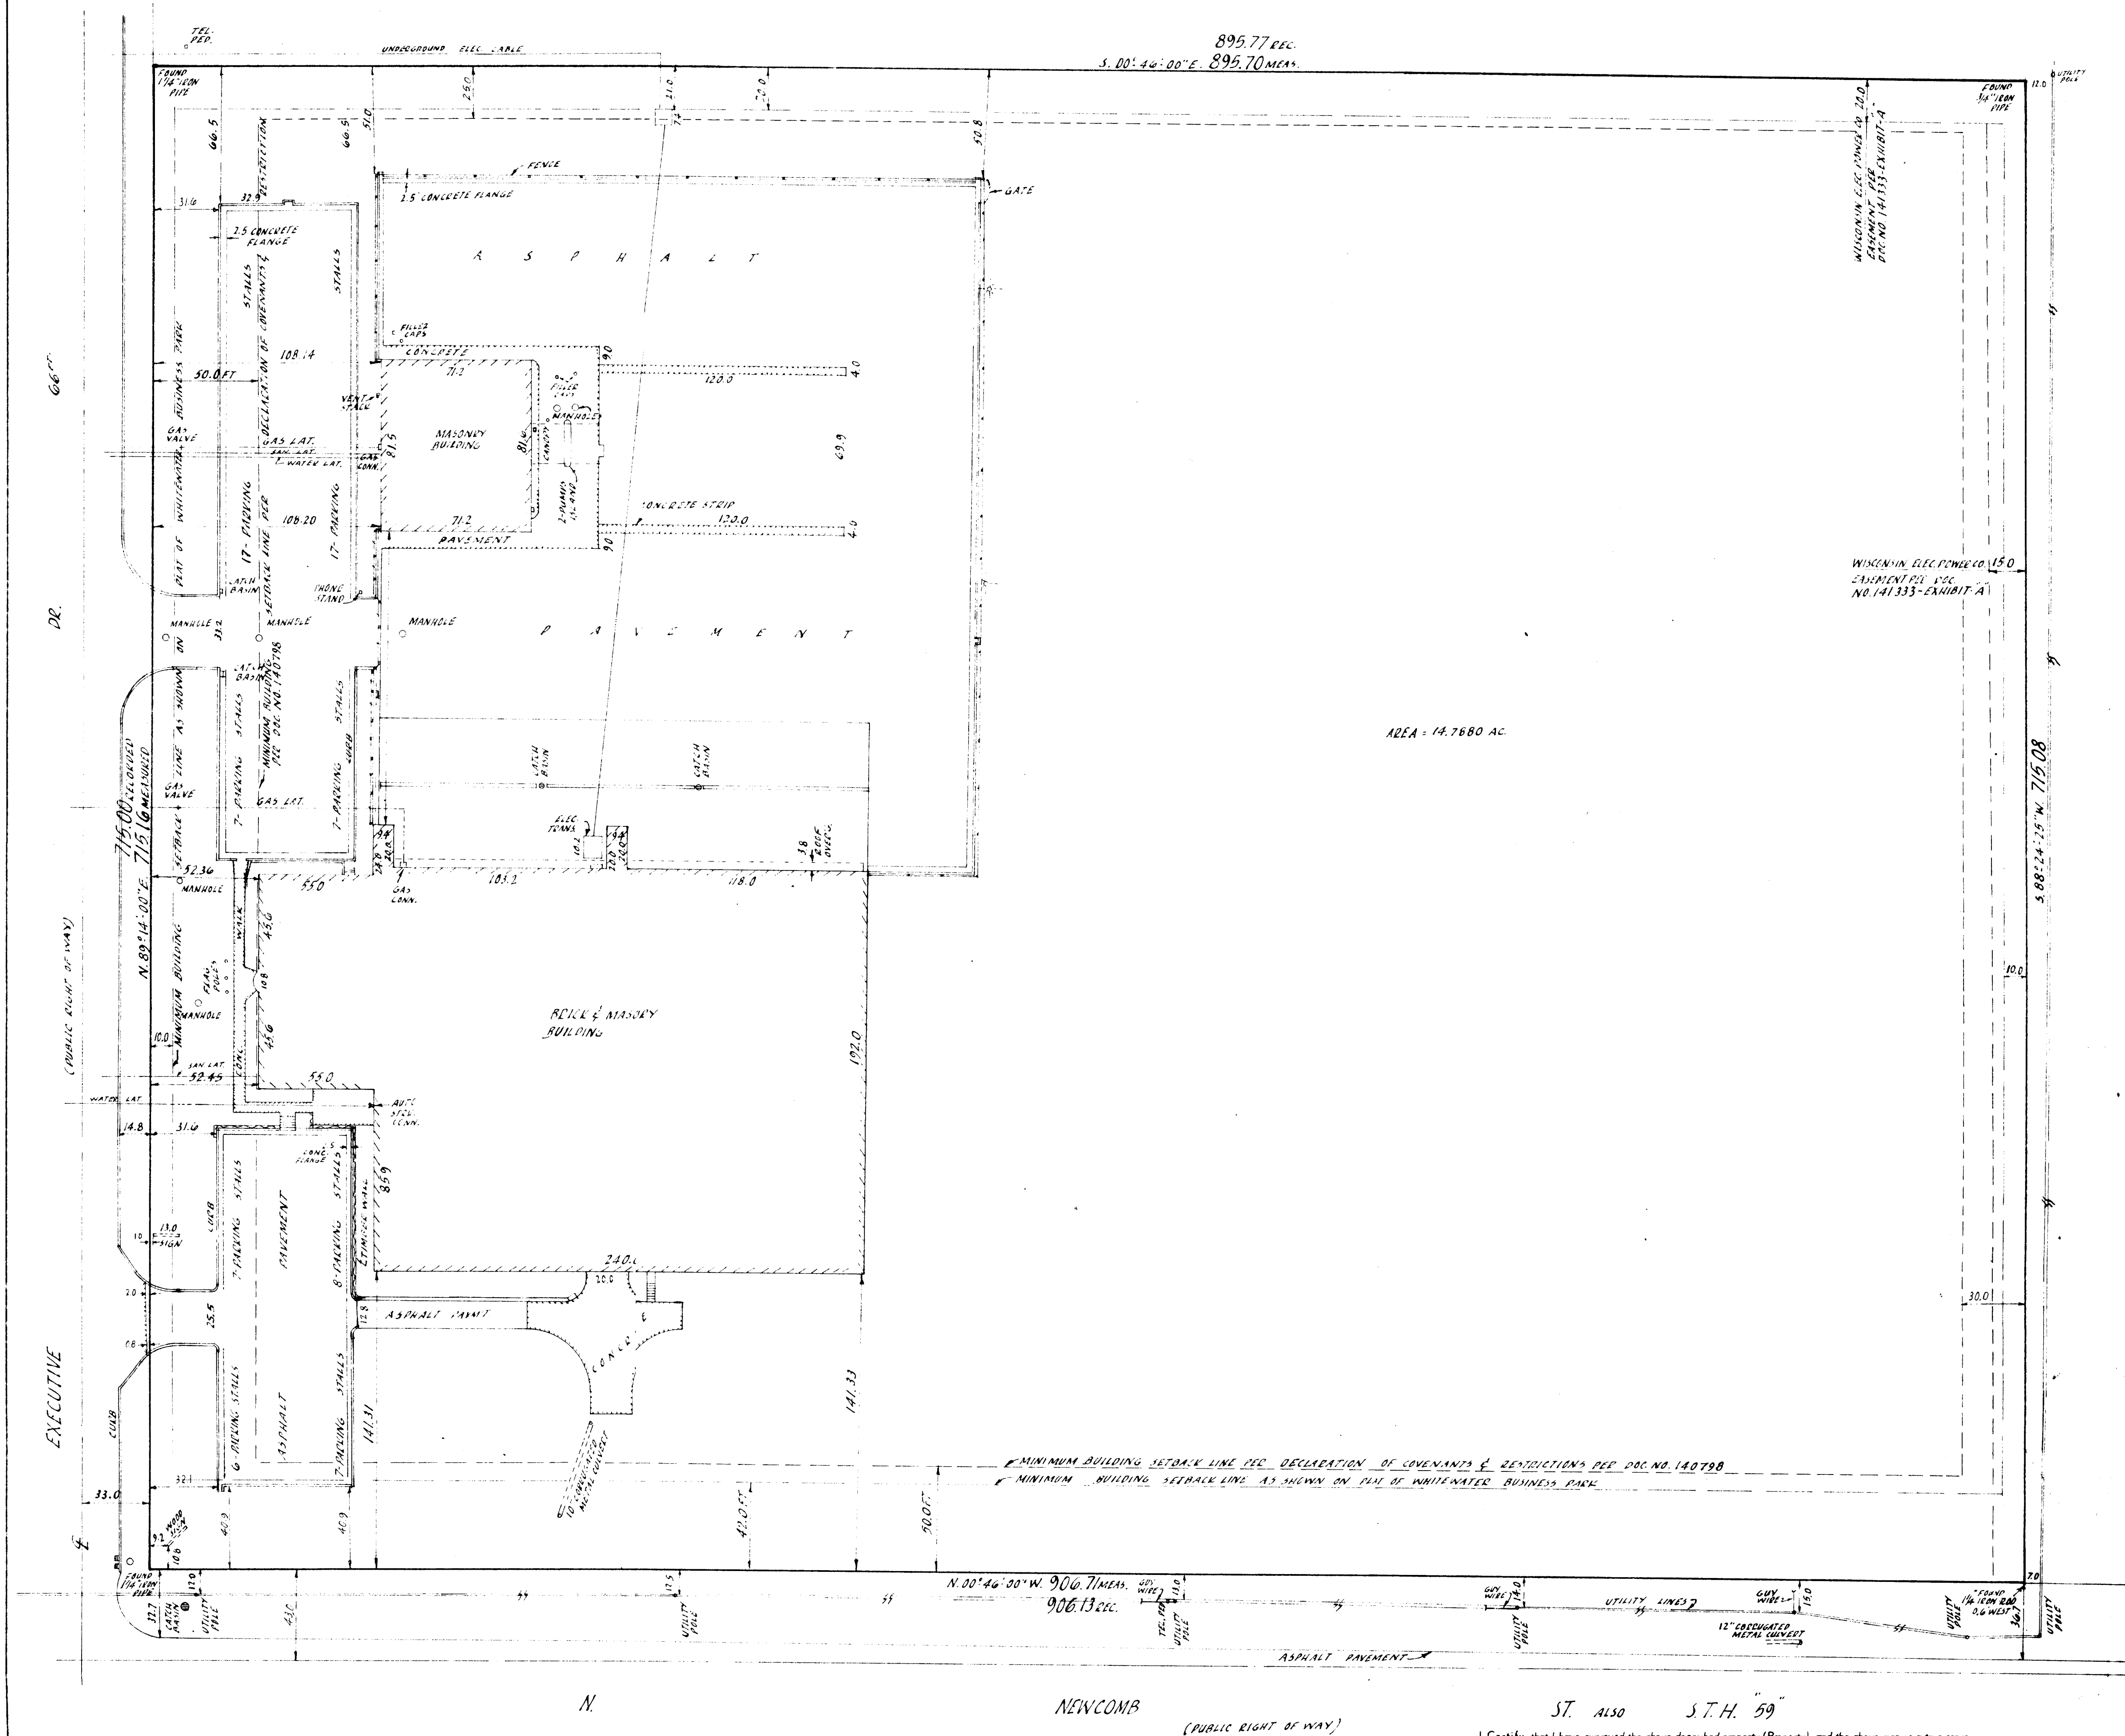

ANTONIO G. GONZALEZ, JR., IN THE CITY OF WASHINGTON, DISTRICT OF COLUMBIA, IN BLOCK 1 IN WASHINGTON EDITIONS PARK, BUILDING 1, OFFICE 1114, N.E. CORNER OF W 1 1/2 OF SECTION 1, T 4 N, R 10 E, IN THE CITY OF WASHINGTON, WASHINGTON, DISTRICT OF COLUMBIA.

1972, 1988      1990      1991      1992      2572     

WISCONSIN ELEC. POWER CO. 150  
EASEMENT REC. DOC.  
NO. 141333-EXHIBIT "A"

AREA = 14.7680 AC

© PAPERBACKS INTERNATIONAL  
JULY 20, 1988

THIS SURVEY IS MADE FOR THE BENEFIT OF: THE FARMERS - RURAL COOPERATION AND TITLE INSURANCE COMPANY, AND ANY OTHERS, AND THEIR RESPECTIVE ASSOCIATES AND ASSIGNS.

I, KENNETH E. BURKE, REGISTERED LAND SURVEYOR DO HEREBY CERTIFY TO THE ABOVE-  
FOOTED, AS OF THE DATE SET FORTH ABOVE THAT I HAVE MADE A CAREFUL SURVEY OF A TRACT  
OF LAND:

LOT 1 IN BLOCK 3 IN WHITEWATER BUSINESS PARK, BEING A PORTION OF A PART  
OF THE NW 1/4 OF SECTION 3, T 4 N, R 15 E, IN THE CITY OF WHITEWATER,  
WALWORTH COUNTY, WISCONSIN.

[illegible]

I FURTHER CERTIFY THAT THIS MAP OR PLAN AND THE SURVEY ON WHICH IT IS BASED WERE MADE IN ACCORDANCE WITH "MINIMUM STANDARD DETAIL REQUIREMENTS FOR ALIENATION LAND TITLE SURVEYS," RECENTLY ESTABLISHED AND ADOPTED BY ALTA AND ASSESSORS IN 1906; AND MEETING THE MINIMUM REQUIREMENTS OF A CLASS A SURVEY, AS DEFINED THEREIN.

I FURTHER CERTIFY THAT SAID PROPERTY IS NOT LOCATED WITHIN AN AREA IDENTIFIED BY THE SECRETARY OF HOUSING AND URBAN DEVELOPMENT, AS AN AREA HAVING A FLOOD OR FLOOD HAZARD, ON FLOOD INSURANCE RATE MAP NO. 1-500-200-004 IN WASHINGTON COUNTY, WISCONSIN, WHICH IS THE CURRENT FLOOD INSURANCE RATE MAP FOR THE COMMUNITY IN WHICH SAID PREMISES ARE LOCATED.

*Kenneth E Berke*  
KENNETH E. BERKE, PROFESSIONAL LAND SURVEYOR  
S-107  
BROOKFIELD  
WIS.

**THIS IS ORIGINAL  
PRINT ONLY IF  
SEAL IS IMPRINTED  
IN RED**

**WISCONSIN  
KENNETH E.  
BERKE  
S-107  
BROOKFIELD  
WIS.  
LAND SURVEYOR**

STATE OF WISCONSIN  
WALKESHA COUNTY

SWORN AND SUBSCRIBED TO BEFORE ME A NOTARY PUBLIC AND FOR THE STATE OF WISCONSIN,  
COUNTY OF WAUKESHA, THIS 29TH DAY OF JULY, 1988.

RECEIVED  
AUG 22 1988

*Frederic Metzger*  
FREDERIC METZGER, 4000 PARKER  
STATE OF WISCONSIN  
MY COMMISSION EXPIRES JULY 23, 1964

1/WBP-5