

CERTIFICATE OF SURVEY


ENGINEER'S CERTIFICATE

I HEREBY CERTIFY THAT I HAVE SURVEYED AND MAPPED THE LANDS DESCRIBED HEREON AND THAT THE MAP IS A CORRECT REPRESENTATION IN ACCORDANCE WITH THE INFORMATION FURNISHED.

John R. Karns

S-1205

JOHN R. KARNS
LAND SURVEYOR
BROOKLYN, WI. 53521
PH. 608-455-3482

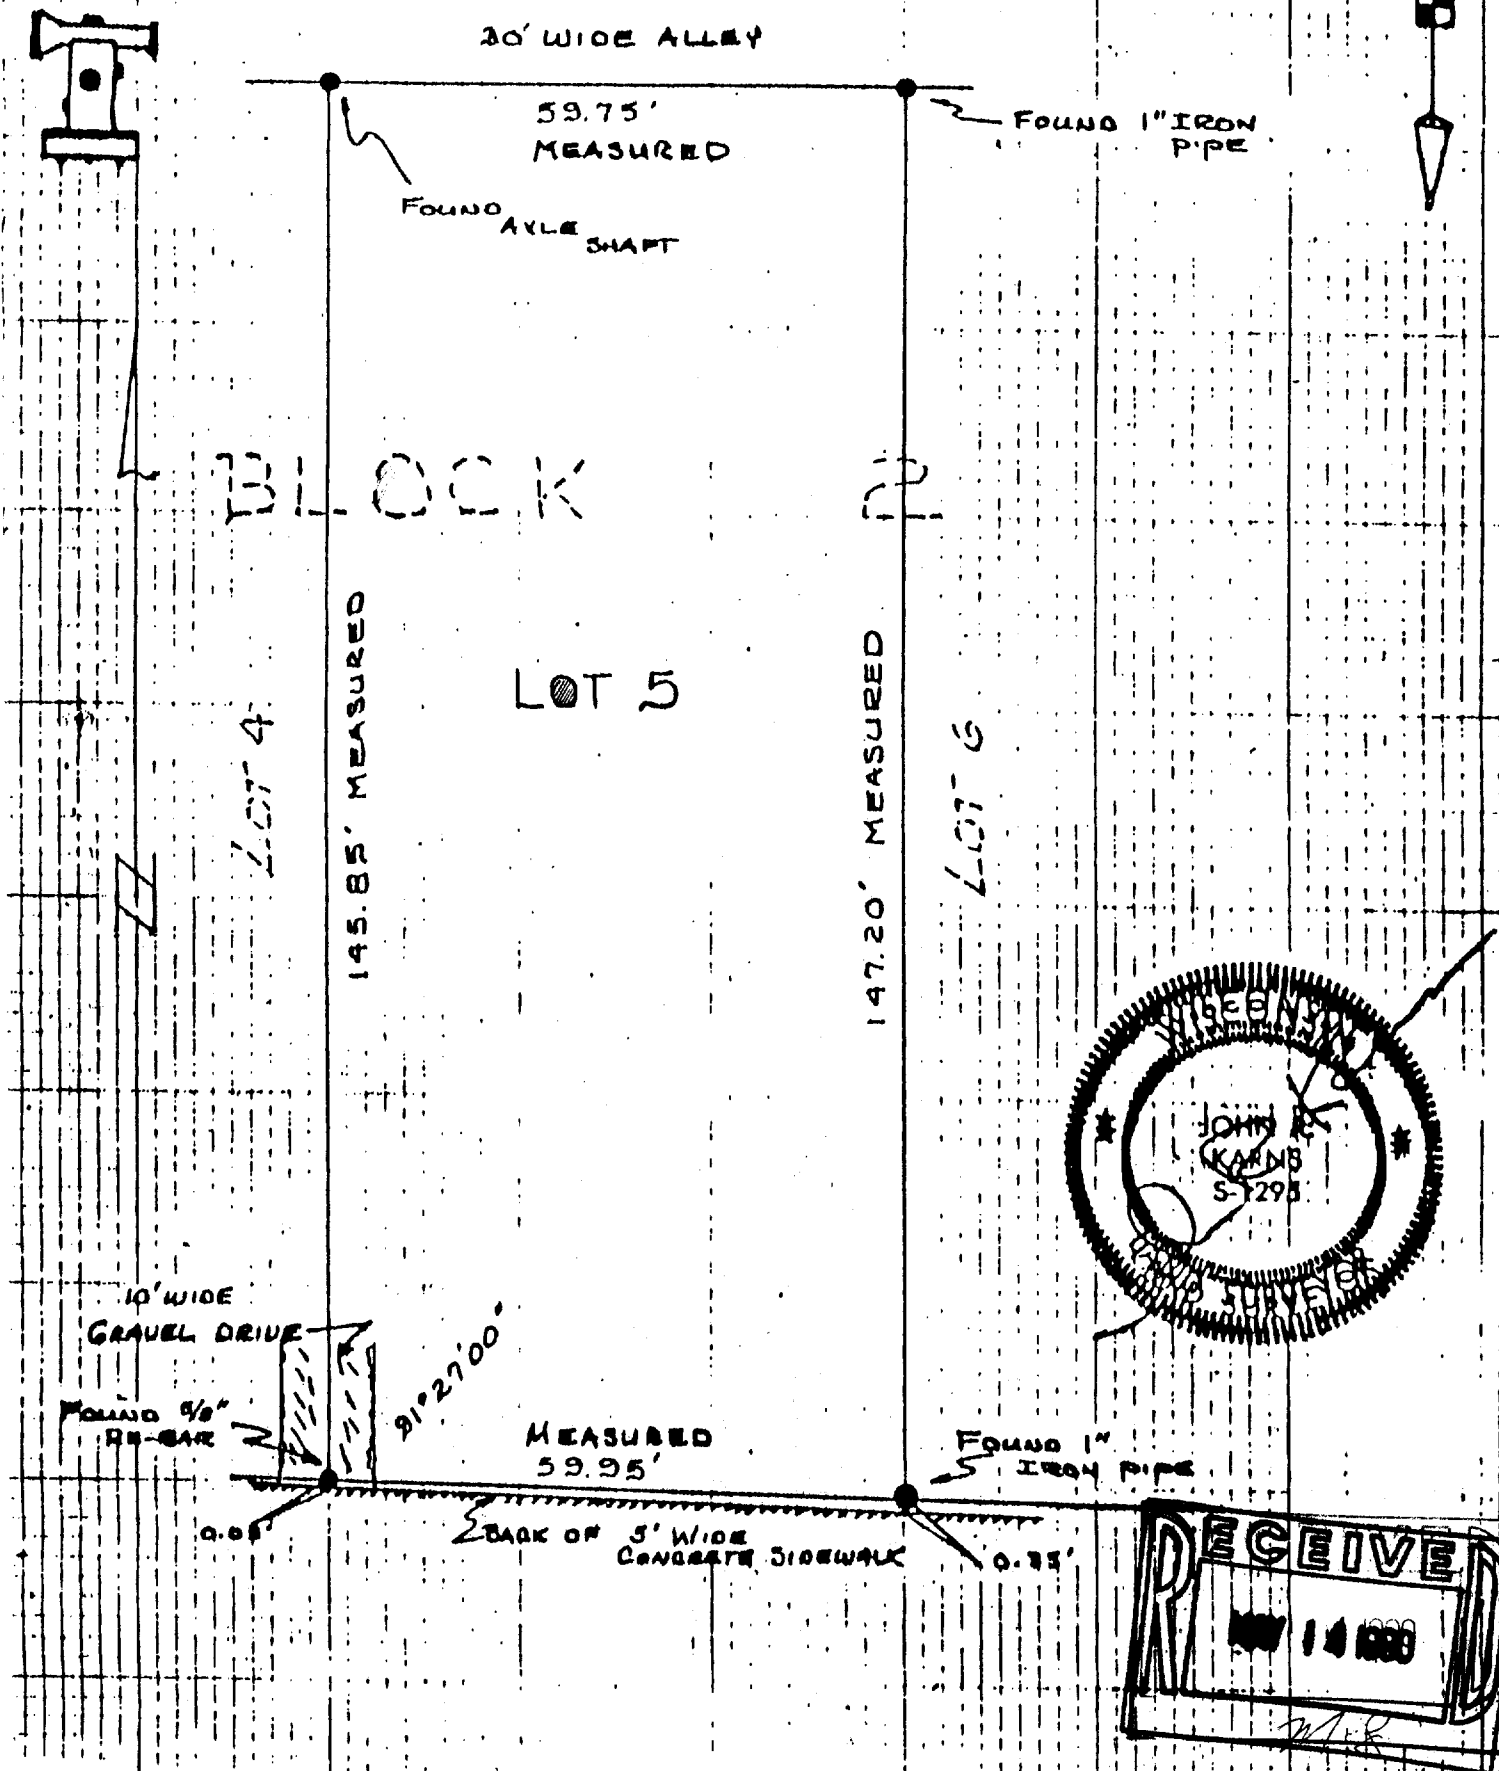

LEGEND

SCALE: 1" = 20 FEET

● IRON STAKE FOUND

○ 1" X 64" IRON STAKE DRIVEN

● 24" X 24" RE-BAR DRIVEN

SURVEYED BY J.R.K.

ELDERSON PAGE

DATE OF SURVEY 10-24-78

SURVEYED FOR Mr. Ernest G. Roberts
459 So. Pleasant, Whitewater, WI. 53190

DESCRIPTION-LOCATION Lot 5, Block 2 Tripp's
2nd Addition to the Village (now City) of
Whitewater, Walworth County, Wisconsin

TAX # /TRA-18B

10-422