


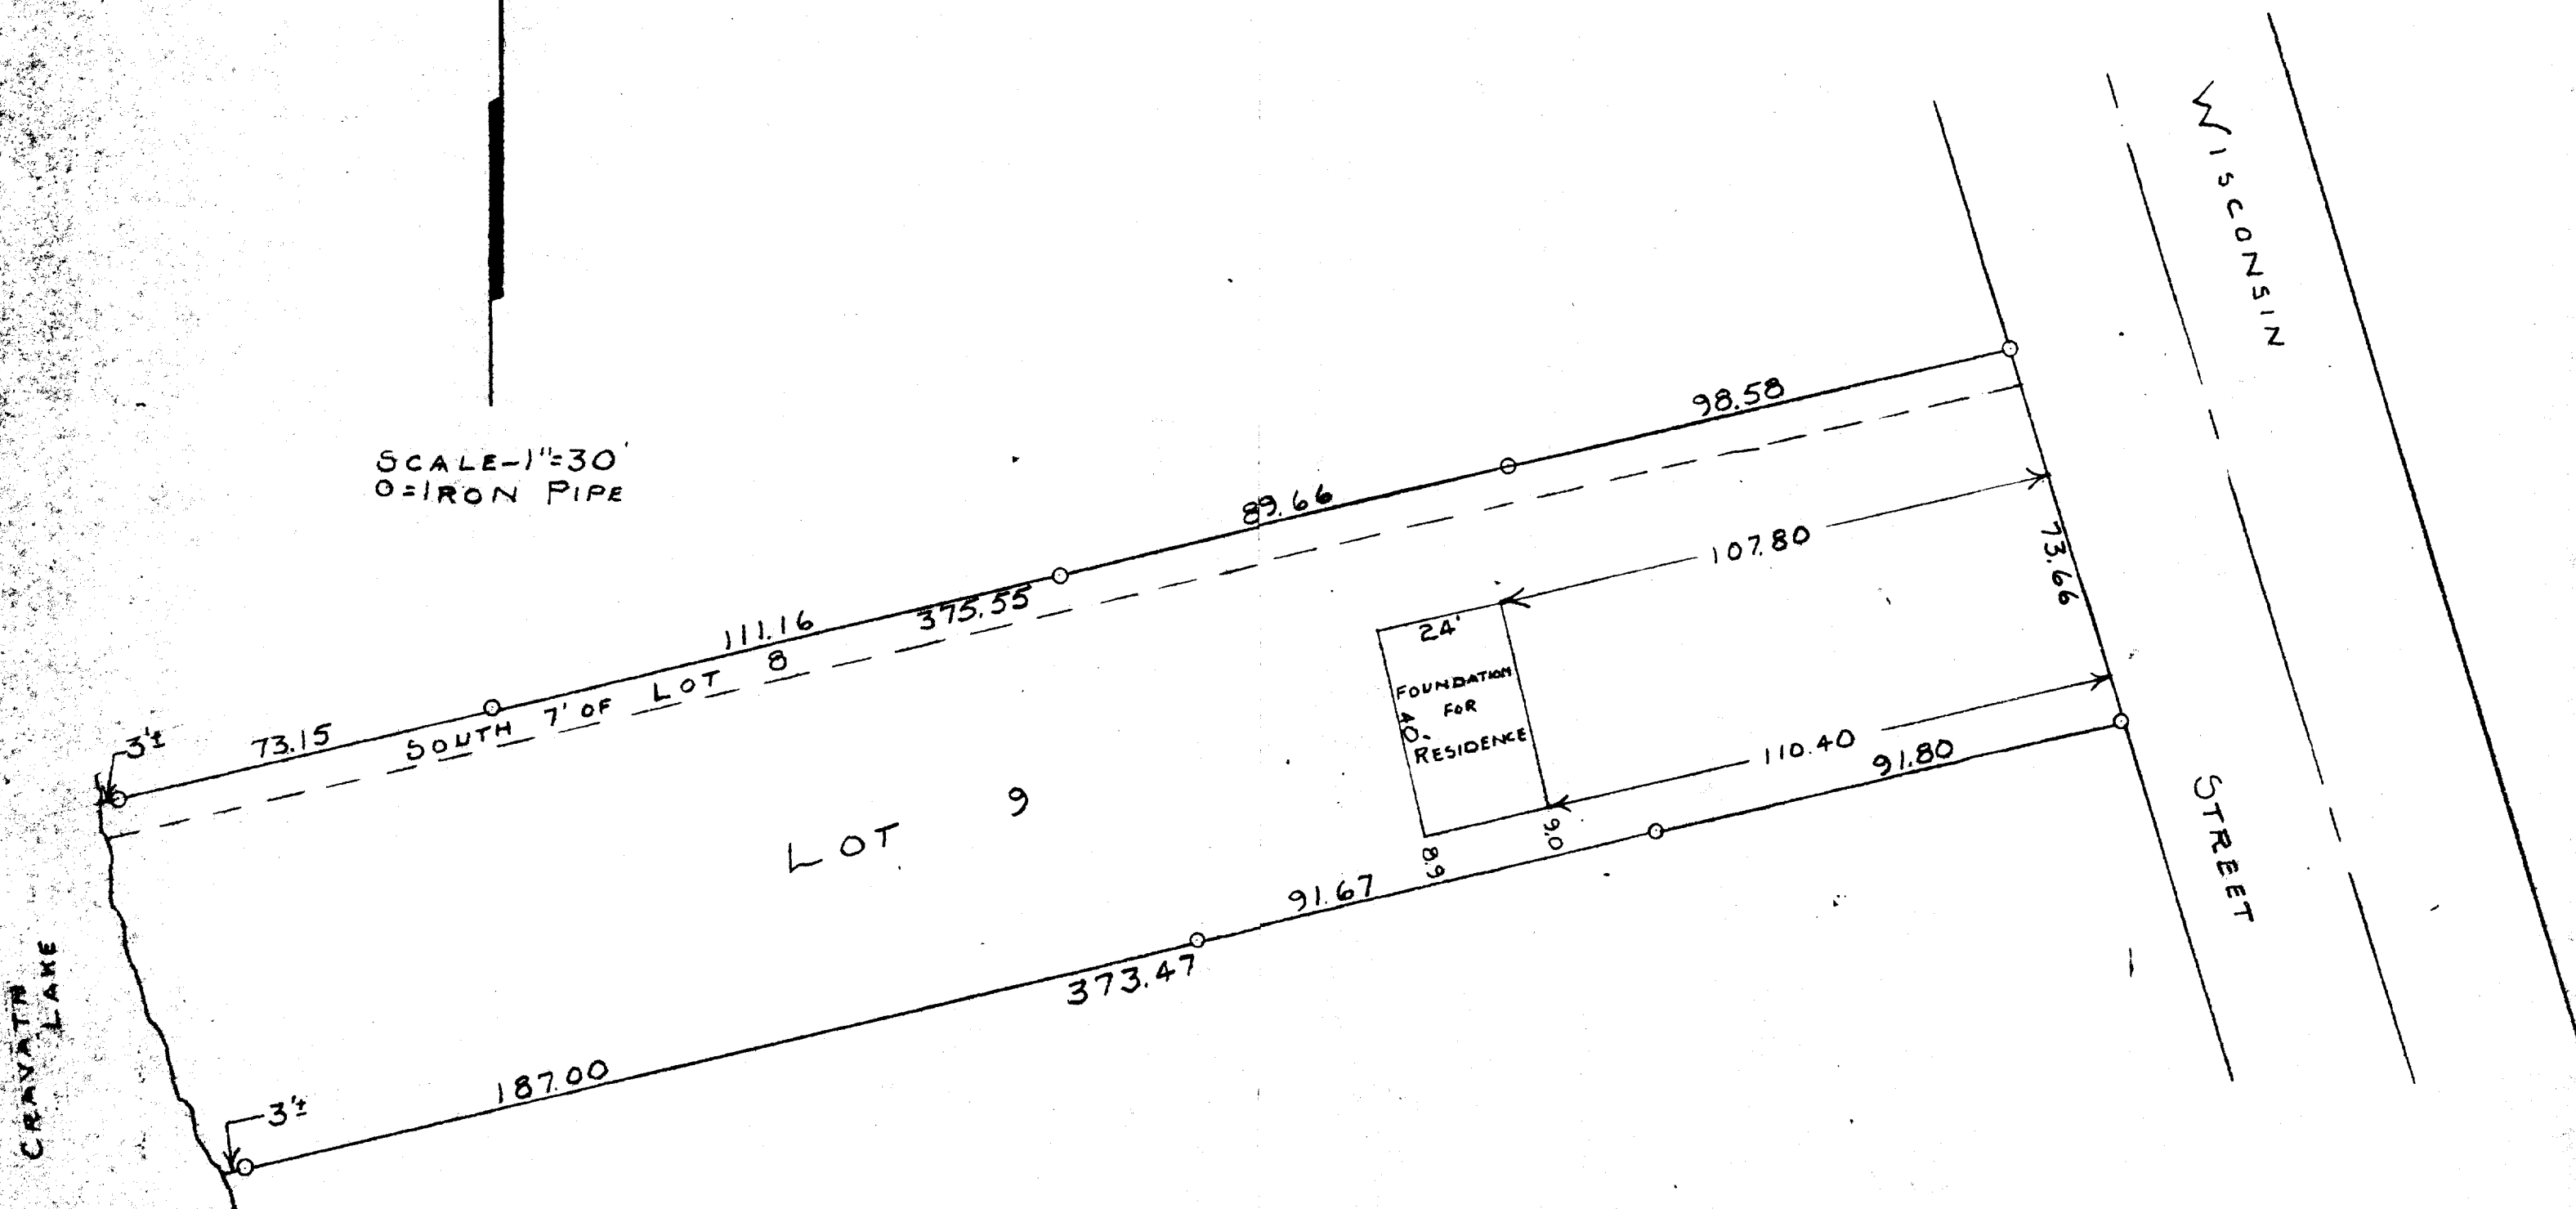

SCALE-1"=30'
O=IRON PIPE



STATE OF WISCONSIN)
WALWORTH COUNTY)

I, GEORGE T. DUNHAM, DO HEREBY CERTIFY THAT I HAVE
SURVEYED THE PROPERTY DESCRIBED AS FOLLOWS:

LOT 9 AND THE SOUTH 7.00 FEET OF LOT 8, BLOCK 4 OF
TRIPPS 2ND ADDITION LOCATED IN THE CITY OF WHITEWATER,
WALWORTH COUNTY, WISCONSIN

AND THAT THE PLAT SHOWN ABOVE IS A CORRECT REPRESENTATION OF
THE PROPERTY LINES AND OF THE IMPROVEMENTS LOCATED THEREON
JAN 20, 1959

George T. Dunham
GEORGE T. DUNHAM, SURVEYOR
DELANE WISCONSIN

10-43