

DESCRIPTION OF RECORD

Plat of Survey of the North 99.4 feet of the East 240 feet of Lot 1, Block 1, Birges Addition to the Village (now City) of Whitewater, Walworth County, Wisconsin; Excepting the North 99.4 feet of the East 88.0 feet of said Lot 1.


Note: The description above describes the property as being a portion of the East 240 feet of said lot 1 and the property as found monumented and occupied as the East 247.90 feet of said lot 1.

D. Cooper & CO., INC.
Rt 4 Box 508B • Elkhorn WI 53121

Survey ordered by Century 21-Whitewater

Survey ordered by Century-21 Whitewater


D. Cooper & CO., INC.

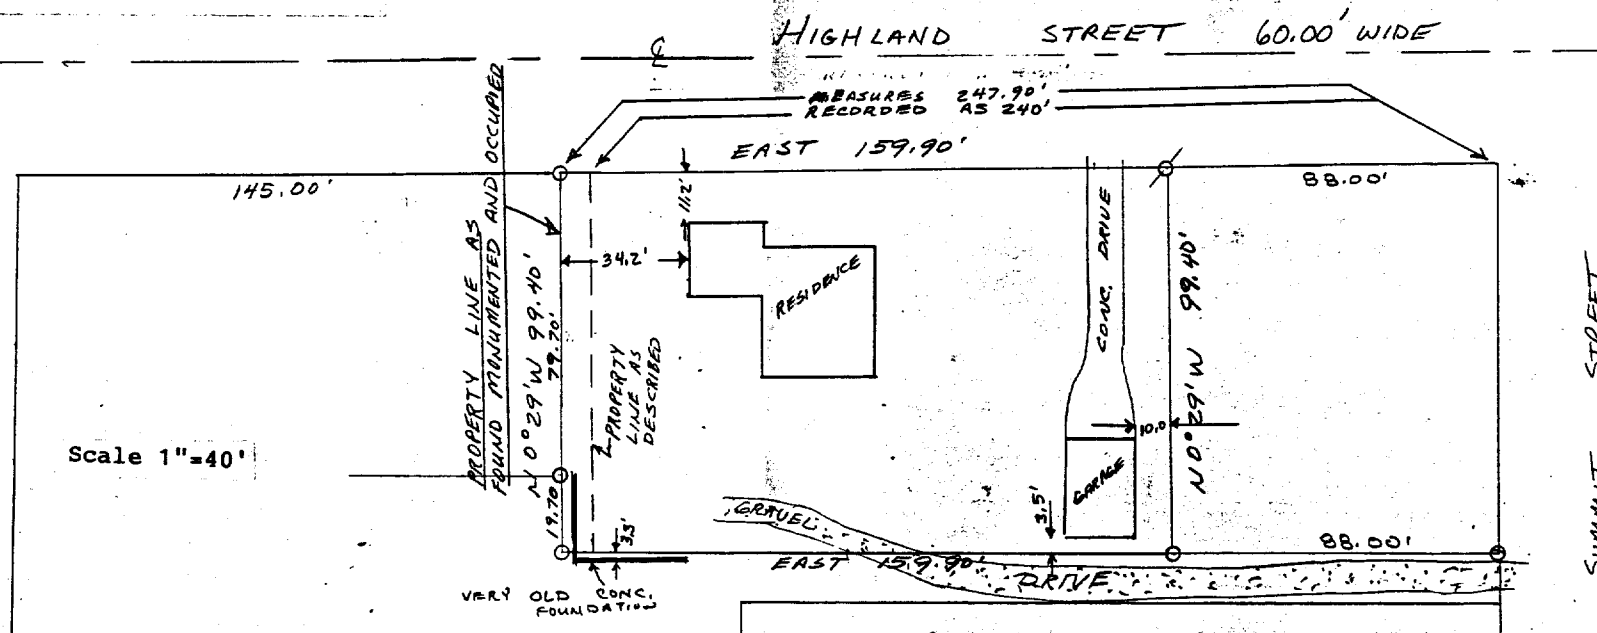

I hereby certify that I have surveyed the property described hereon and that the map shown hereon is a true and accurate representation thereof to the best of my professional knowledge and belief.

Dated this 24 day of July, 1989

Daniel D. Cooper
Daniel D. Cooper, RLS No. S-1464

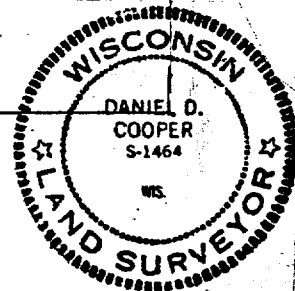


Legend:

- - found iron pipe
- ⊗ - set 3/4"x24" iron rod

DRAWING NO. 3490-18-57

Reduced

TAX KEY # /BIR - I

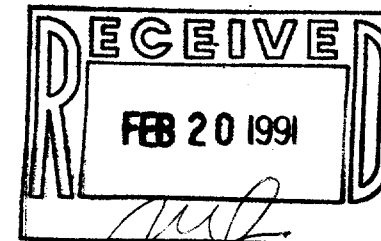

10-430