



PLAT OF SURVEY OF
LOT 1, BLOCK 5,
DANNS ADDITION
TO THE CITY OF
WHITEWATER, WALWORTH
COUNTY, WISCONSIN

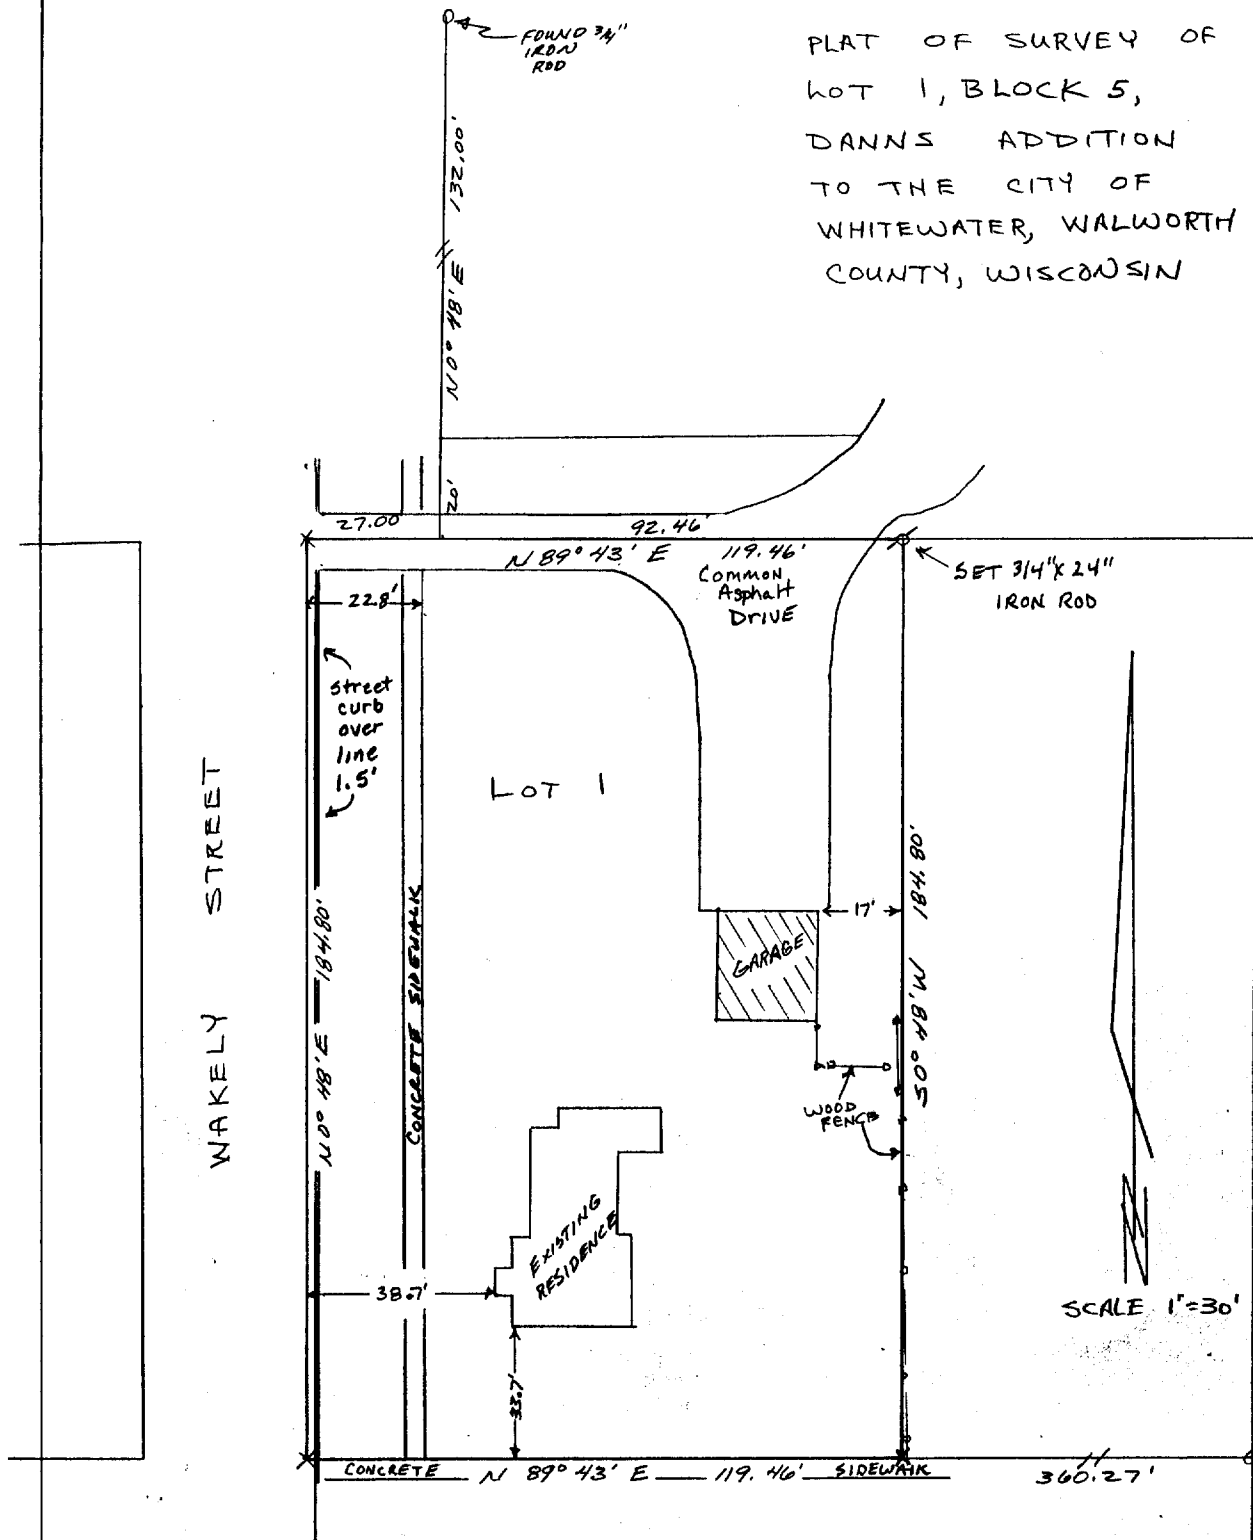

I hereby certify that I have surveyed the property described hereon and that the map shown hereon is a true and accurate representation thereof to the best of my professional knowledge and belief.


Dated this 26 day of July, 1989

Daniel D. Cooper
Daniel D. Cooper, RLS No. S-1464

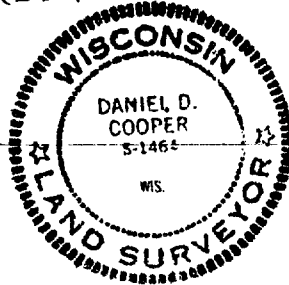

DRAWING NO. 3507

Reduced

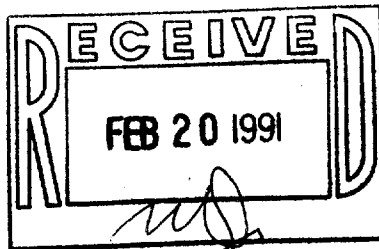

TAX KEY # /DA 00027