


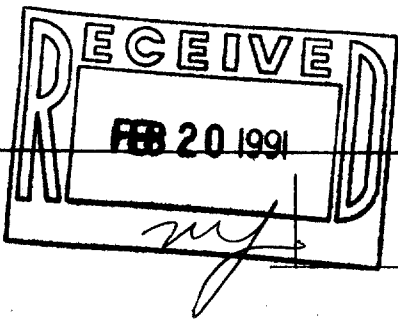

D. Cooper & CO., INC
Rt 4 Box 508B • Elkhorn WI 53121

Plat of Survey of the Southerly
33 feet of Lots 1 & 2 and all of
Lot 3 of Block 12, of the Original
Plat of the Village (now city) of
Whitewater, Walworth County, Wisconsin.

CENTER STREET

STREET

STREET

CHURCH

Survey ordered by
Century-21 Whitewater


Bearing reference: Easterly
line of Franklin assumed to
bear North-South

Scale 1"=30'


I hereby certify that I have surveyed the
property described hereon and that the
map shown hereon is a true and accurate
representation thereof to the best of my
professional knowledge and belief.

Dated this 28 day of Feb. 1990

Daniel D. Cooper
Daniel D. Cooper, RLS No. S-1464

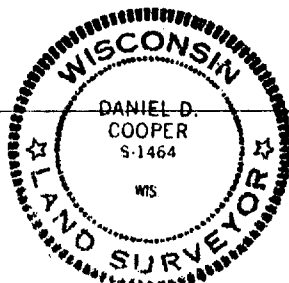

Reduced

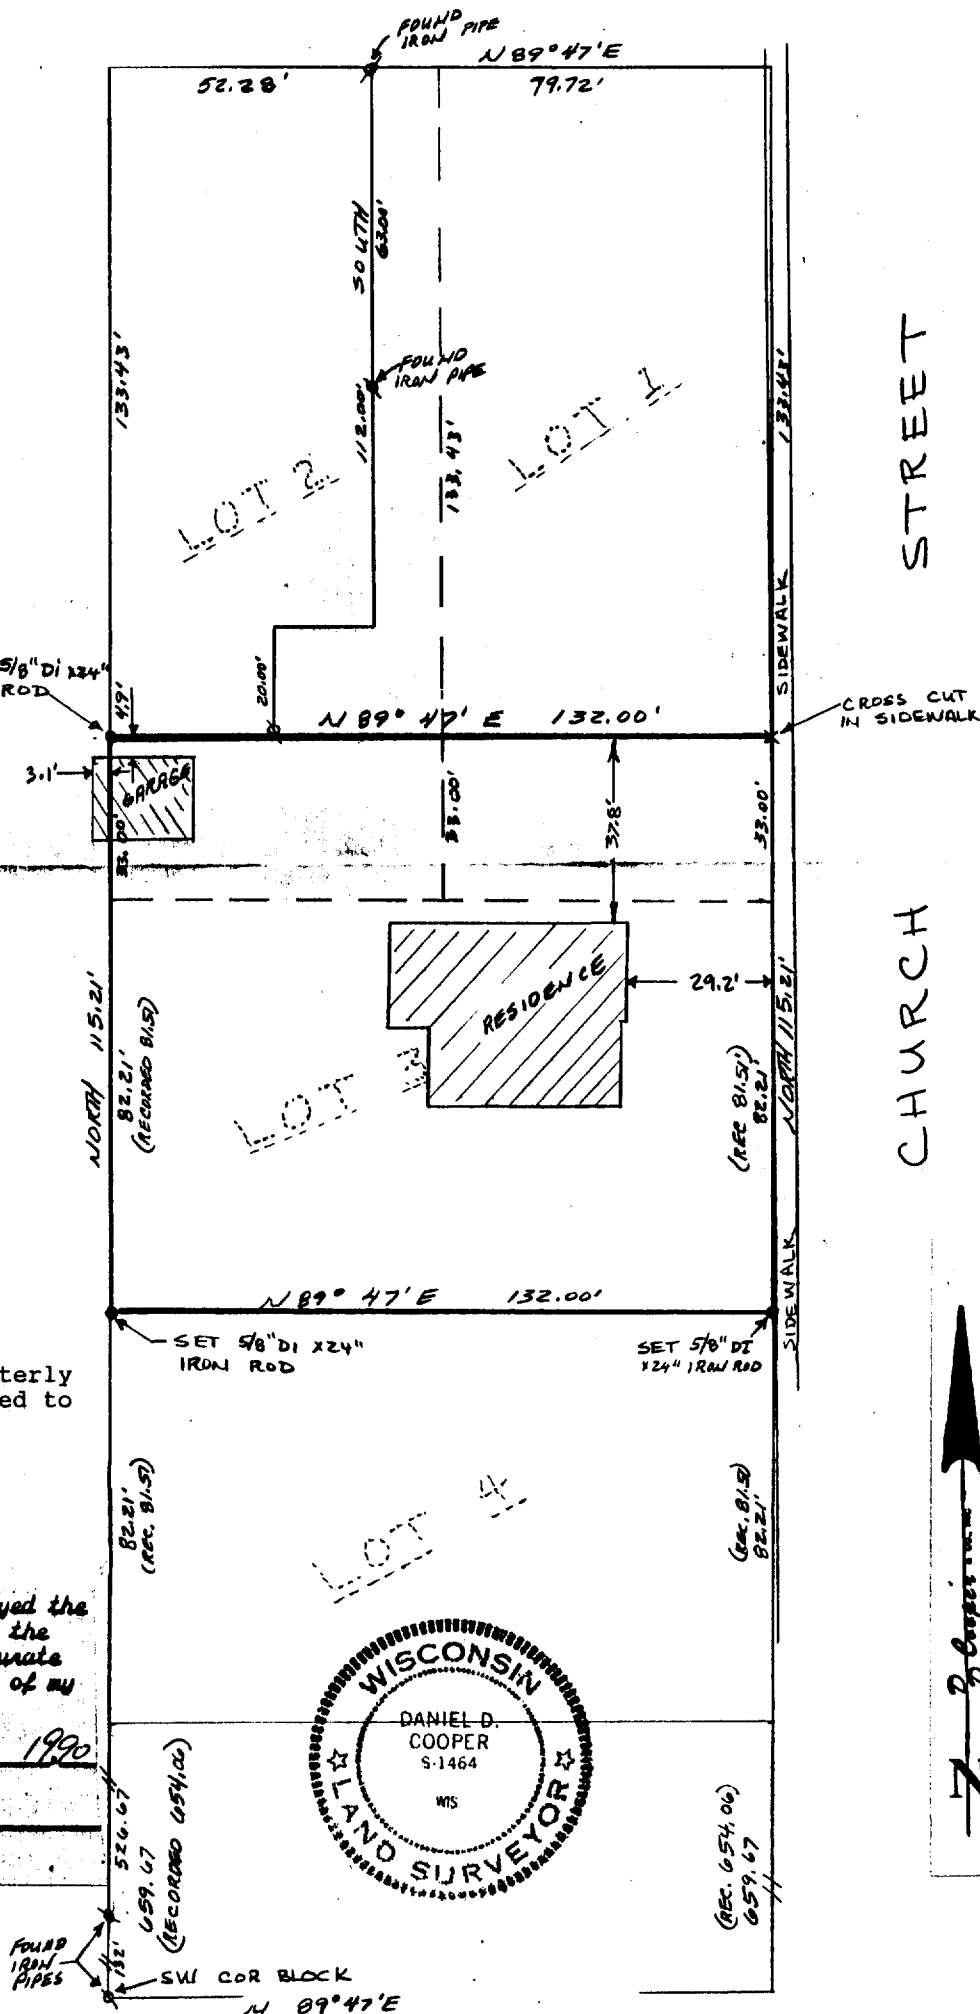

TAX KEY # 10T 00115

10-436