


D Cooper & CO., INC
Rt 4 Box 508B • Elkhorn WI 53121

BLK "1"
PLAT OF SURVEY OF LOT 11, TRATT'S
ADDITION TO THE CITY OF WHITEWATER,
WALWORTH COUNTY, WISCONSIN.

WEST WALWORTH

66' WIDE

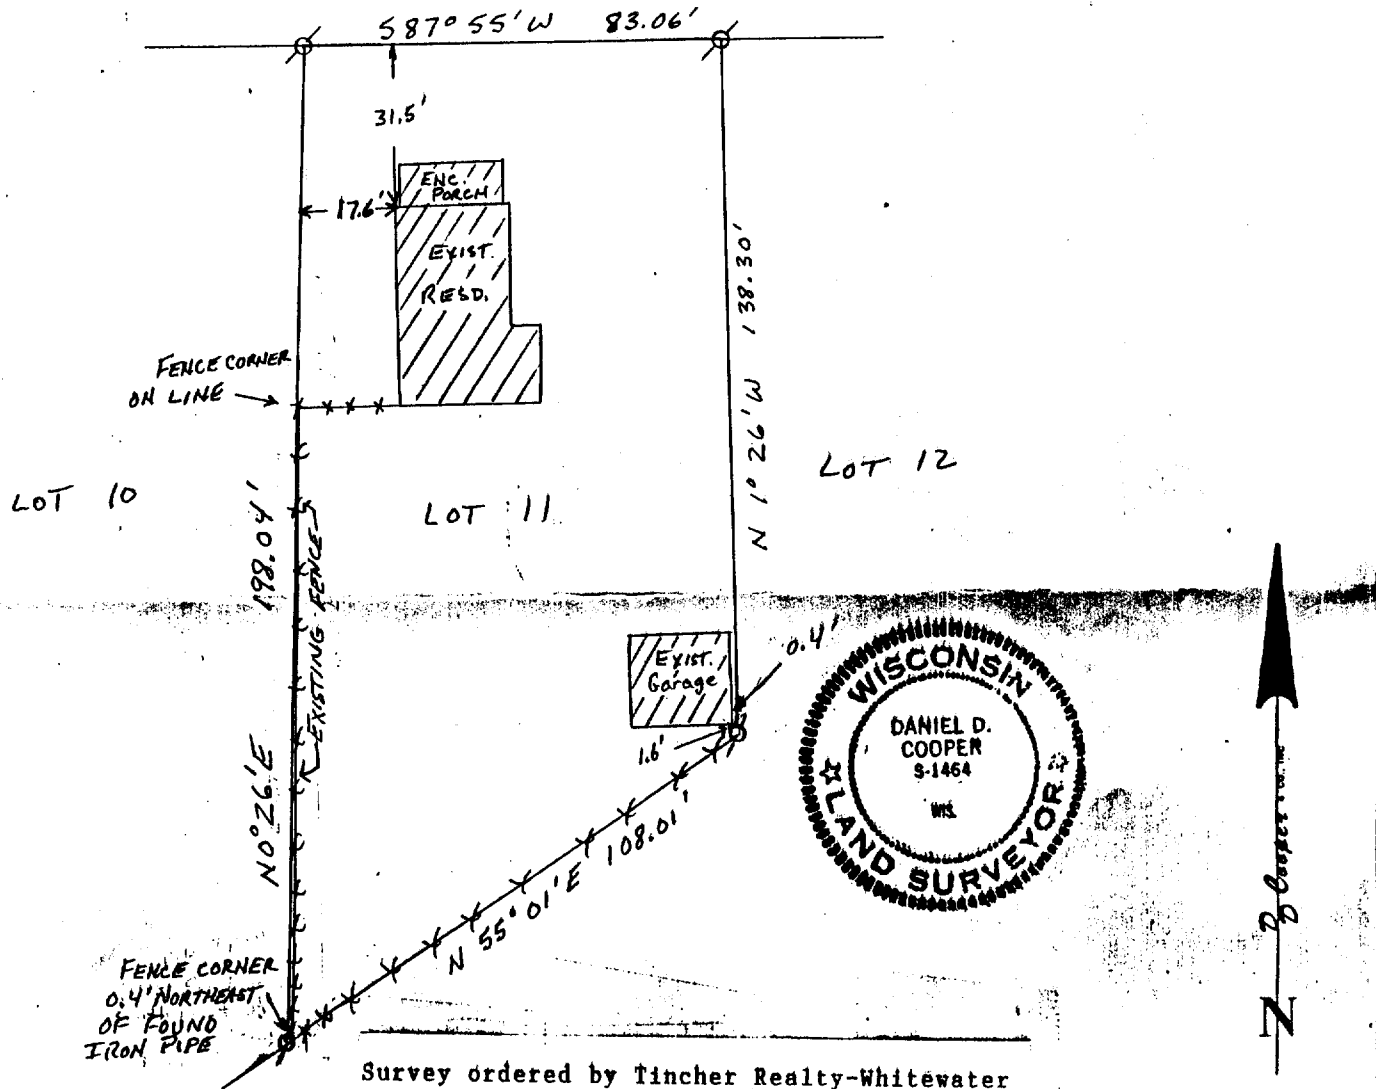

Bearing Reference: Northerly line of lot assumed to bear S 87° 55' W as shown on other survey records.

I hereby certify that I have surveyed the property described hereon and that the map shown hereon is a true and accurate representation thereof to the best of my professional knowledge and beliefs.

Dated this 24 day of May, 1990

Daniel D. Cooper

Daniel D. Cooper, RLS No. 8-1464


Legend

- Indicates county monument
- ⊗ Indicates iron pipe found
- Indicates 5/8" di. x 24" iron rod set
- Indicates iron rod found

Scale: 1" = 30'

Date: 5-24-90

Drawing No: 3617

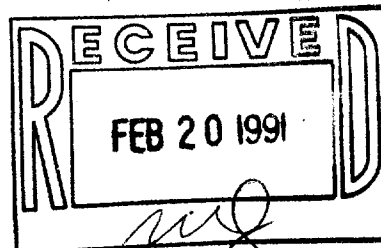

Reduced

TAX KEY #

1/T 00008

10-438