


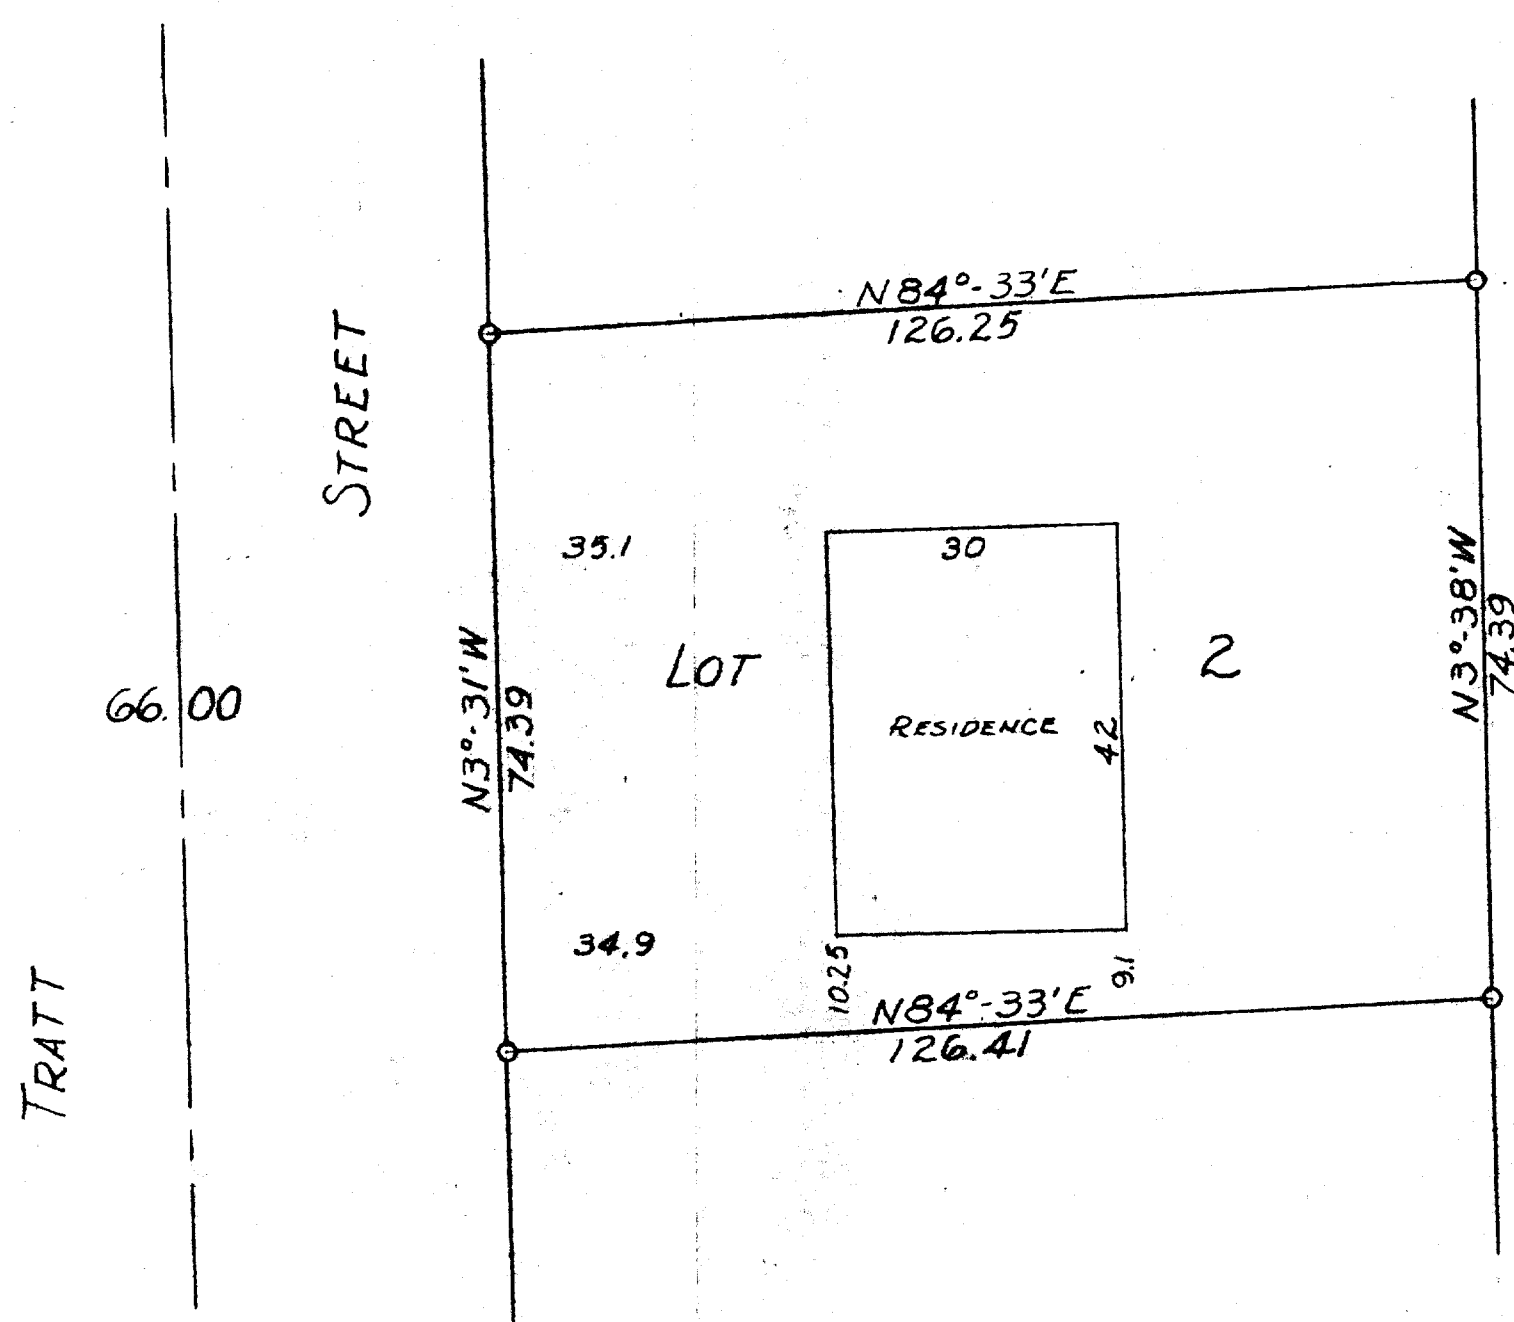

STATE OF WISCONSIN }
WALWORTH COUNTY } S.S.

LOT 2 OF BELL-AIRE HEIGHTS A SUBDIVISION LOCATED IN THE CITY OF WHITEWATER,
WALWORTH COUNTY, WISCONSIN

JULY 30, 1958

10-49