


PLAT OF SURVEY

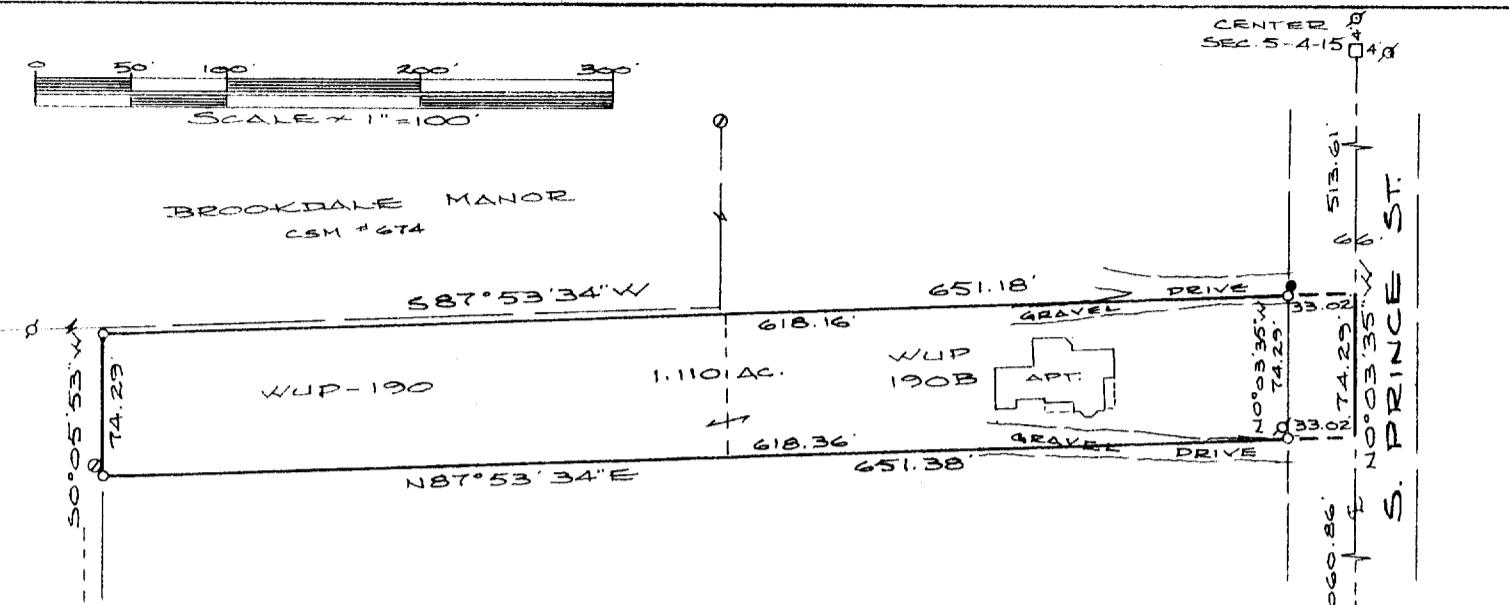

- Location from County Surveyor's ties (on Manhole Cover)
- Set 3/8"x12" Iron Rod From County Surveyor's Ties
- Found 1 1/4" Pinched Iron Pipe
- Found 1" Iron Pipe
- Found 3/4" Iron Pipe
- Set 1"x24" Iron Pipe

DESCRIPTION


The North 1/2 of the South 9 rods of the NE $\frac{1}{4}$ of the NE $\frac{1}{4}$ of the SW $\frac{1}{4}$ of Section 5, T4N, R15E, City of Whitewater, Walworth County, Wisconsin, to-wit:

Commencing at the S $\frac{1}{4}$ corner of said Section 5; thence N0° 03' 35"W, along the east line of said SW $\frac{1}{4}$, also being the centerline of S. Prince Street, 2060.86 feet to the point of beginning; thence continue N0° 03' 35"W, along said east line and centerline, 74.29 feet; thence S87° 53' 34"W, 651.18 feet to a 1" iron pipe on the west line of said NE $\frac{1}{4}$ of the NE $\frac{1}{4}$ of the SW $\frac{1}{4}$; thence S0° 05' 53"W, along said west line, 74.29 feet to a 1" iron pipe; thence N87° 53' 34"E, 651.38 feet to the point of beginning, containing 1.110 acres and subject to a road right of way across the easterly 33 feet.

CERTIFICATION

I hereby certify that the property described above has been surveyed under my responsible direction and supervision and that this map is an accurate representation of the lot lines and dimensions and the principle lines of the permanent structures thereon.

Date 3-5-91

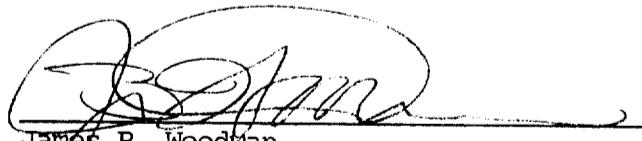
James B. Woodman
Registered Land Surveyor, S-1239

Prepared for: Dave Kachel
DLK ENTERPRISES
127 Harmony Lane
Whitewater, WI 53190

