

KOLB LAND CONSULTING, INC.
LAND SURVEYING • SUBDIVIDING • LAND PLANNING

929 WILLIAMS STREET


LAKE GENEVA, WISCONSIN 53147

414-248-3697

SCALE: 1" = 50'

GRAVATH LAKE

WISCONSIN STREET
66' WIDE

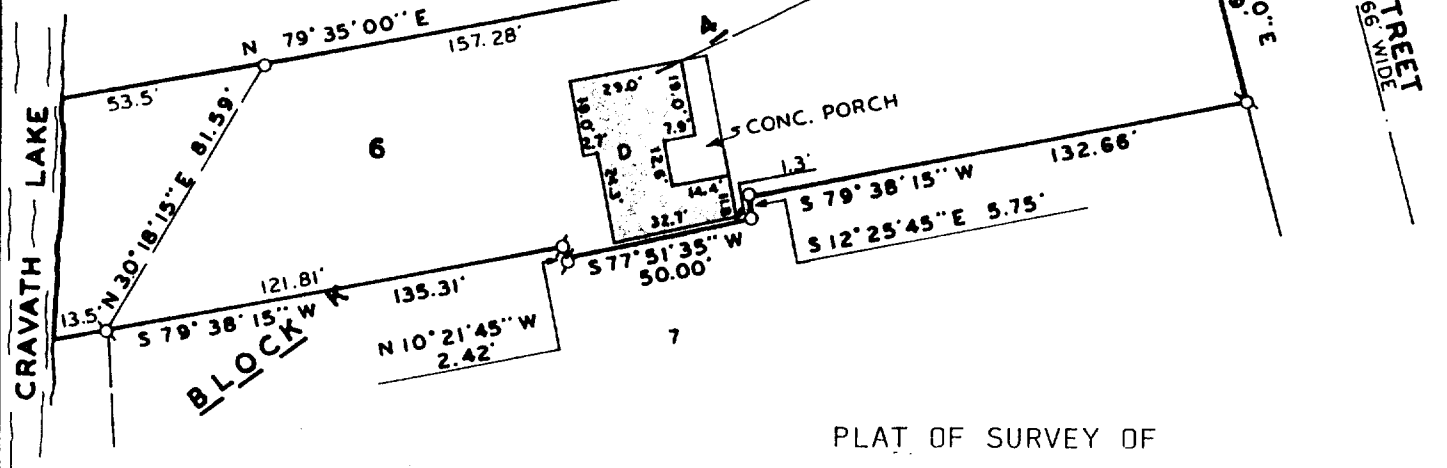

PLAT OF SURVEY OF


PART OF LOTS 6 AND 7, BLOCK 4, TRIPP'S
SECOND ADDITION TO THE CITY OF WHITE-
WATER, WALWORTH COUNTY, WISCONSIN.

LEGEND

- O - IRON PIPE SET
- Ø - IRON PIPE FOUND
- Δ - UTILITY POLE
- - OVERHEAD UTILITY LINE
- D - DUPLEX

ORDERED BY: GERALD NOWAK
HCR 3 BOX 925
PHILLIPS, WI. 54555

I HEREBY CERTIFY THAT I HAVE SURVEYED THE
ABOVE DESCRIBED PROPERTY AND THAT THE ABOVE
MAP IS A TRUE REPRESENTATION THEREOF AND
SHOWS THE SIZE AND LOCATION OF THE PROPERTY,
ITS EXTERIOR BOUNDARIES, THE LOCATION OF ALL
VISIBLE STRUCTURES AND DIMENSIONS OF ALL
PRINCIPAL BUILDINGS THEREON, BOUNDARY FENCES,
APPARENT EASEMENTS, ROADWAYS AND VISIBLE
ENCROACHMENTS, IF ANY, TO THE BEST OF MY
KNOWLEDGE AND BELIEF.
THIS SURVEY IS MADE FOR THE USE OF THE
PRESENT OWNERS OF THE PROPERTY, AND ALSO
THOSE WHO PURCHASE, MORTGAGE, OR GUARANTEE
THE TITLE THERETO WITHIN ONE (1) YEAR FROM
DATE HEREOF. SURVEY NOT VALID UNLESS
SURVEYOR'S SIGNATURE IS IN RED.

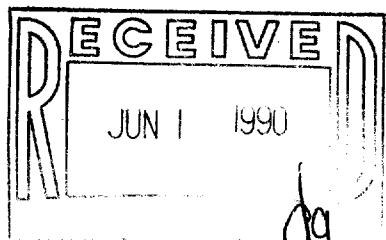

HAROLD H. KOLB

WISCONSIN REGISTERED LAND SURVEYOR, S-187

DATE FEBRUARY 6, 1989

REVISED

REVISED

010-445

WH-1

1TRAD0640