

AS BUILT SURVEY

A PART OF THE EAST 1/2 OF THE SE.1/4 OF SECTION 5, T.4N., R.15E. AND ROUNDED AS FOLLOWS: Commencing in the center of the highway at the 1/4 post between Sections 4 and 5 running thence South on the Section line 14 rods to a stake; thence West 14 rods to a stake; thence South 2 rods to a stake; thence West 2 rods; thence North 16 rods to the center of the highway; thence East along the center of the highway to the place of beginning; excepting therefrom the West 8 rods thereof heretofore sold and conveyed to Jessie L. Halverson by deed recorded October 7, 1921 in Volume 164 of Deeds on Page 567 of Walworth County Records.

ALSO:

A PARCEL OF LAND LOCATED IN THE CITY OF WHITEWATER, BEING A PART OF THE SE.1/4 OF SECTION 5, T.4N., R.15E., DESCRIBED AS FOLLOWS, TO-WIT: Commencing in the center of the highway known as Main Street at a point which is 16 rods West of the East 1/4 post of said Section 5; thence South 264 feet to a point; thence East 33 feet to a stake; thence South 33 feet to a point; thence East 20 feet to a point; thence North 66 feet to a point; thence East 79 feet to a point; thence North 231 feet to the center of the highway known as Main Street; thence West along the center of said highway 132 feet to the place of beginning.

ALL BEING LOCATED IN THE CITY OF WHITEWATER, WALWORTH COUNTY, WISCONSIN.


NOTE: The above description is subject to any and all easements or agreements, recorded or unrecorded.

State of Wisconsin SS.
County of Rock

I have supervised the survey of the above described property and to the best of my knowledge and belief the map hereon is a true representation thereof and shows the size and location of the property, its exterior boundaries, the location and dimensions of all visible buildings thereon, boundary fences, apparent easements, roadways and visible encroachments, if any.

This survey is made for the exclusive use of the present owners of the property, and also those who purchase, mortgage, or guarantee the title thereto, within one (1) year from the date hereof; and as to them I certify the accuracy of said survey and map.

Given under my hand and seal this 8th day of March, 1991 at Janesville, Wisconsin.

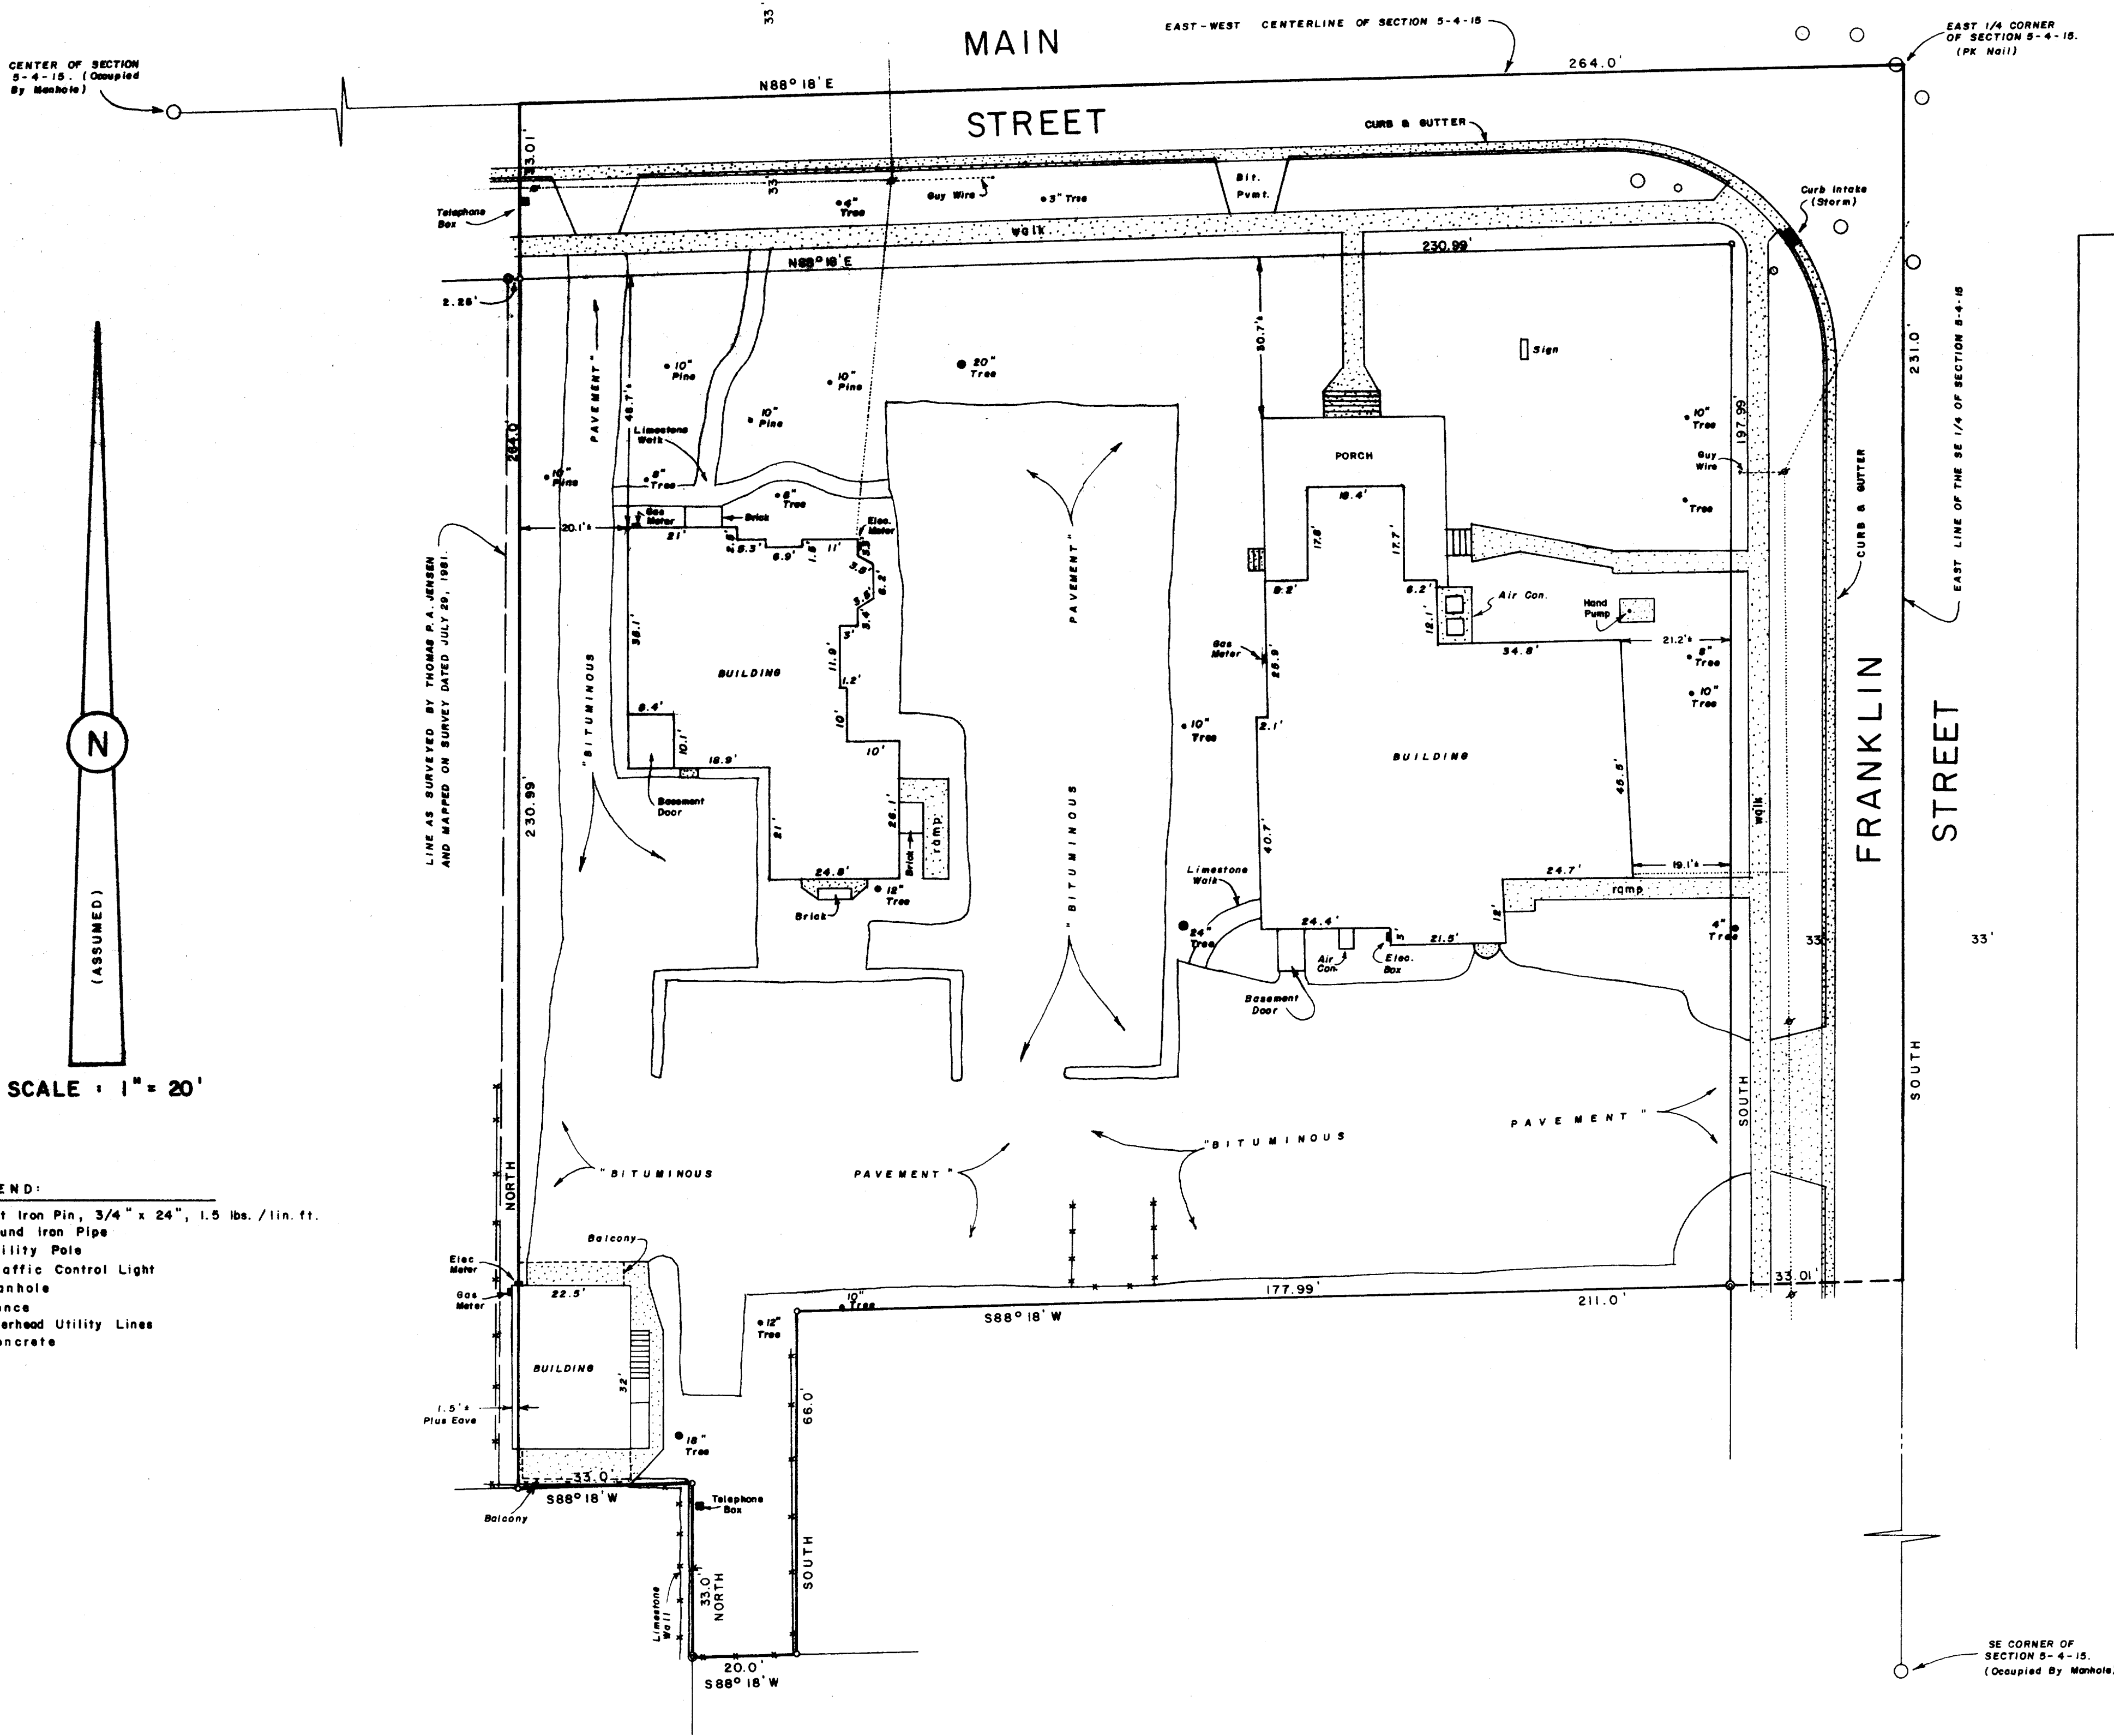

HAROLD L. COMBS AND ASSOCIATES
LAND SURVEYING - MAPPING - PLANNING
JANESVILLE, WISCONSIN