


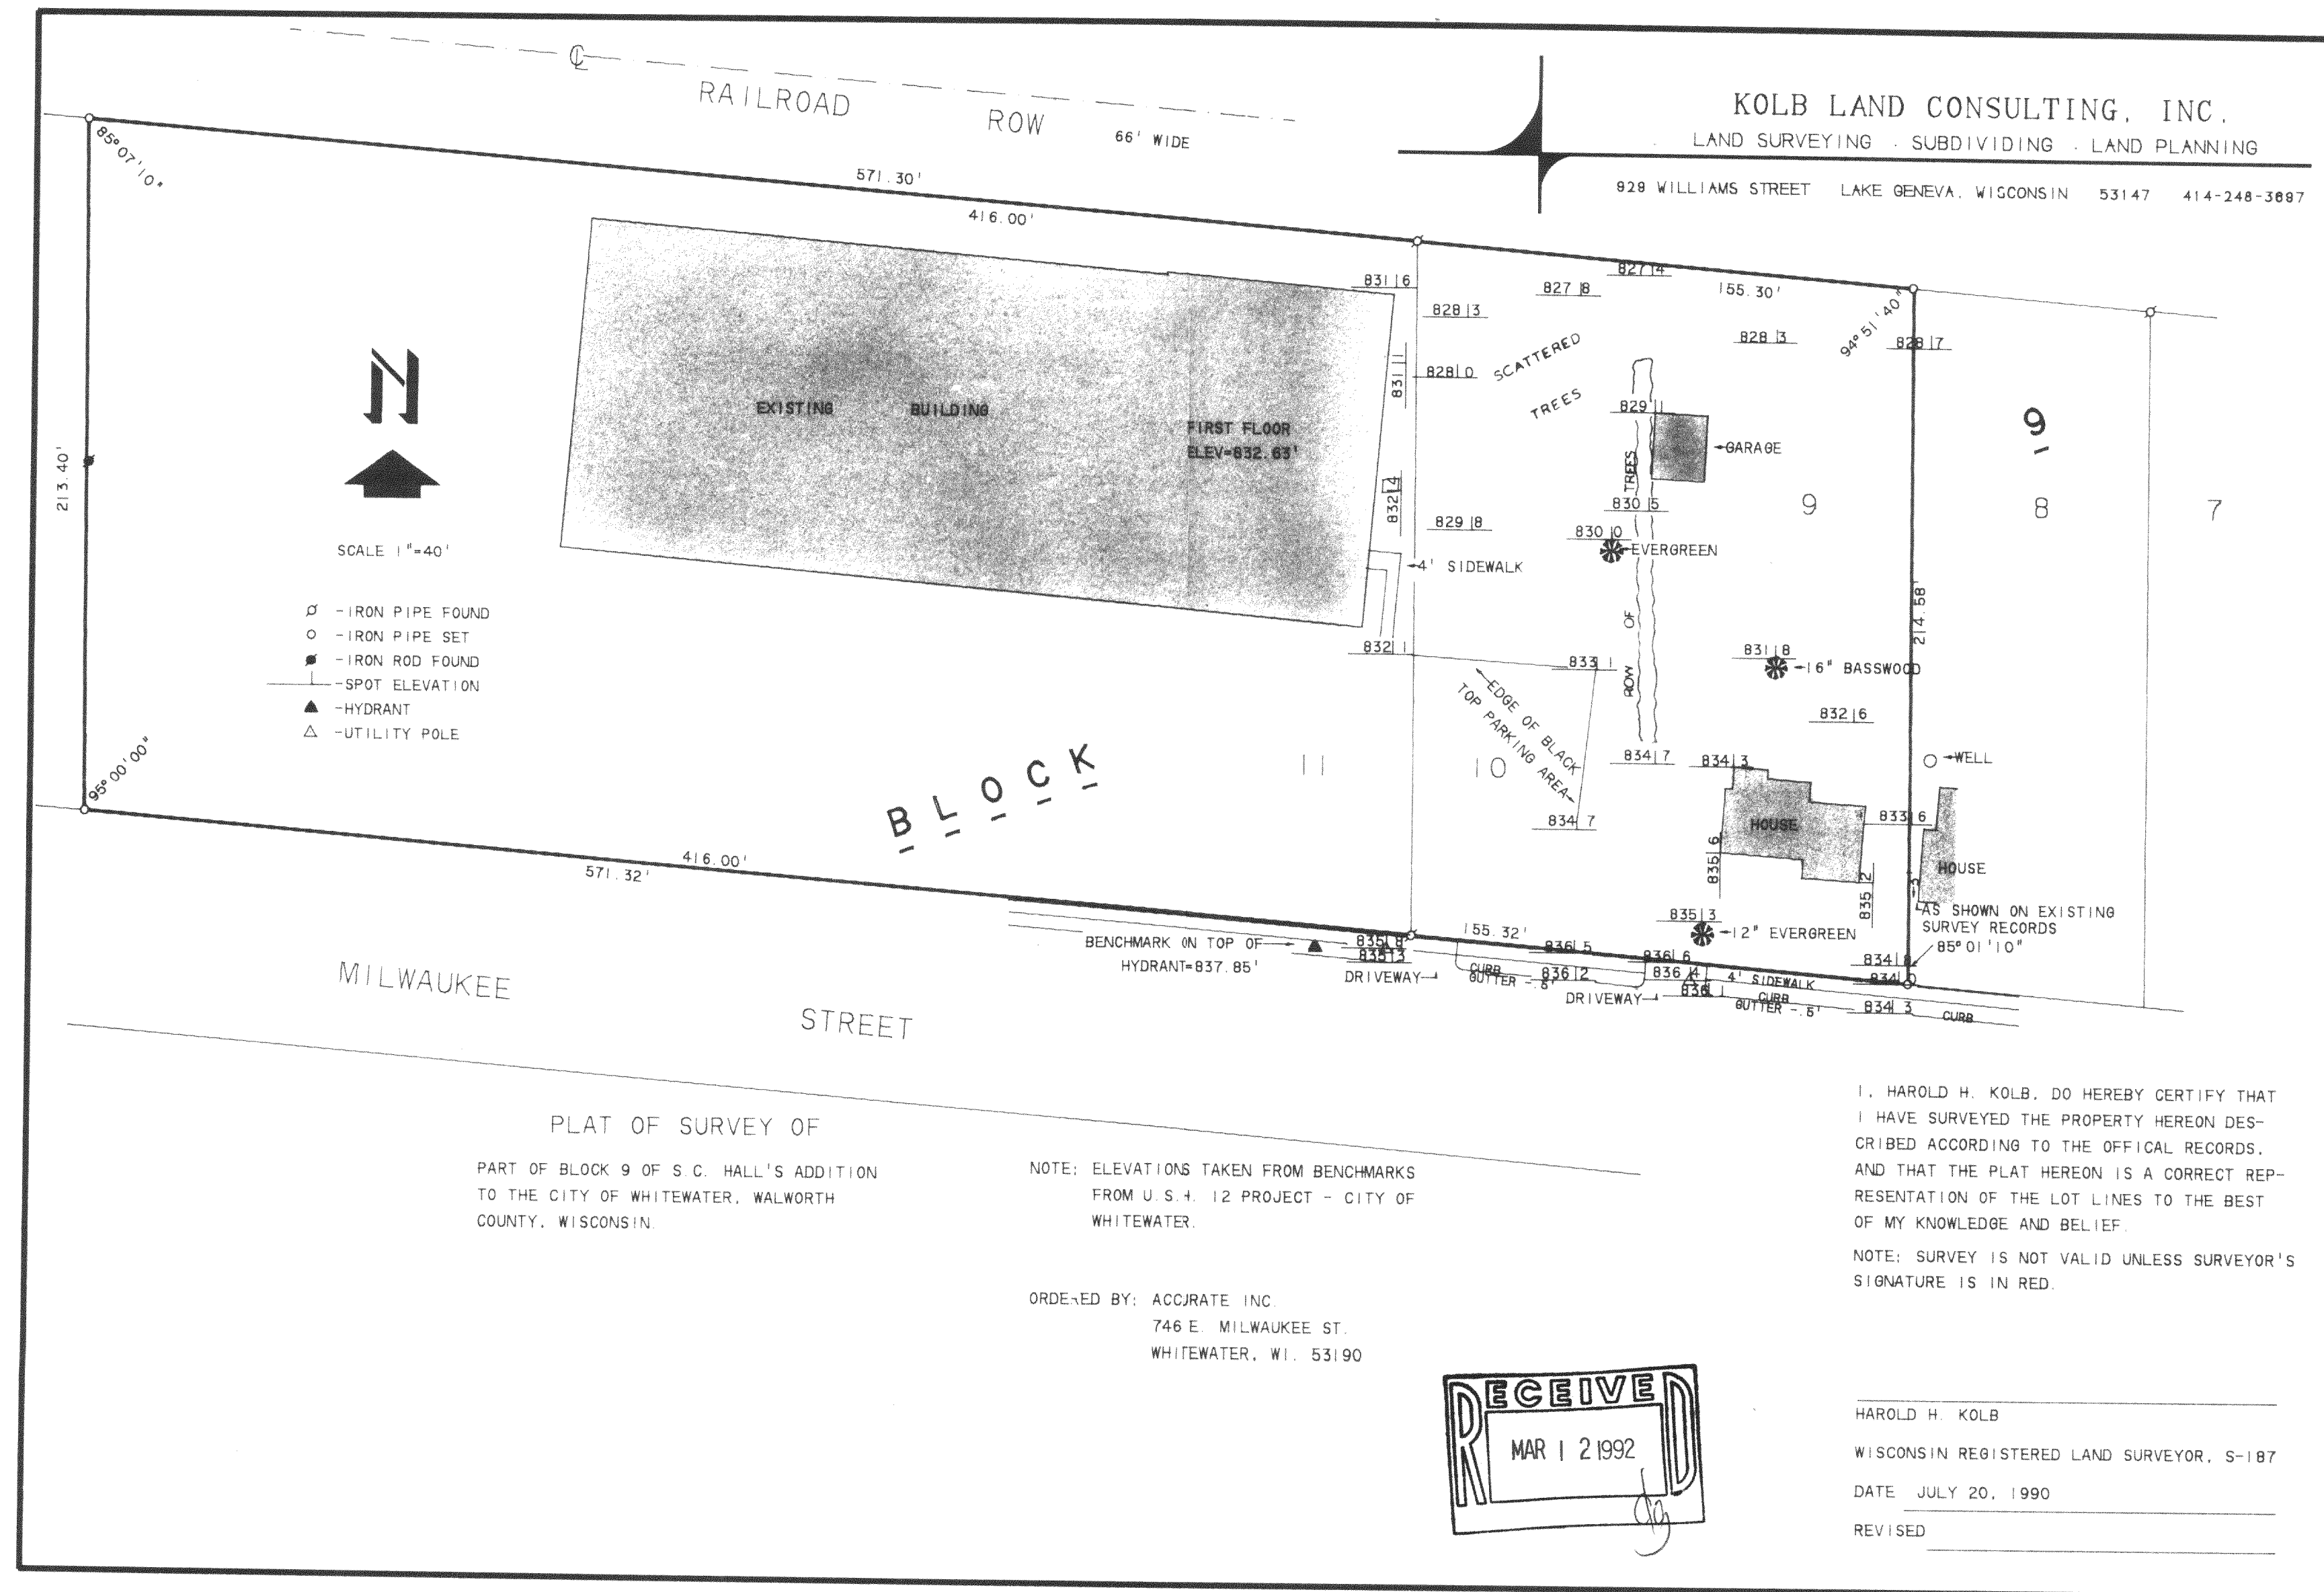

010-451

/HAS-53
/HAS-54