


PLAT OF SURVEY

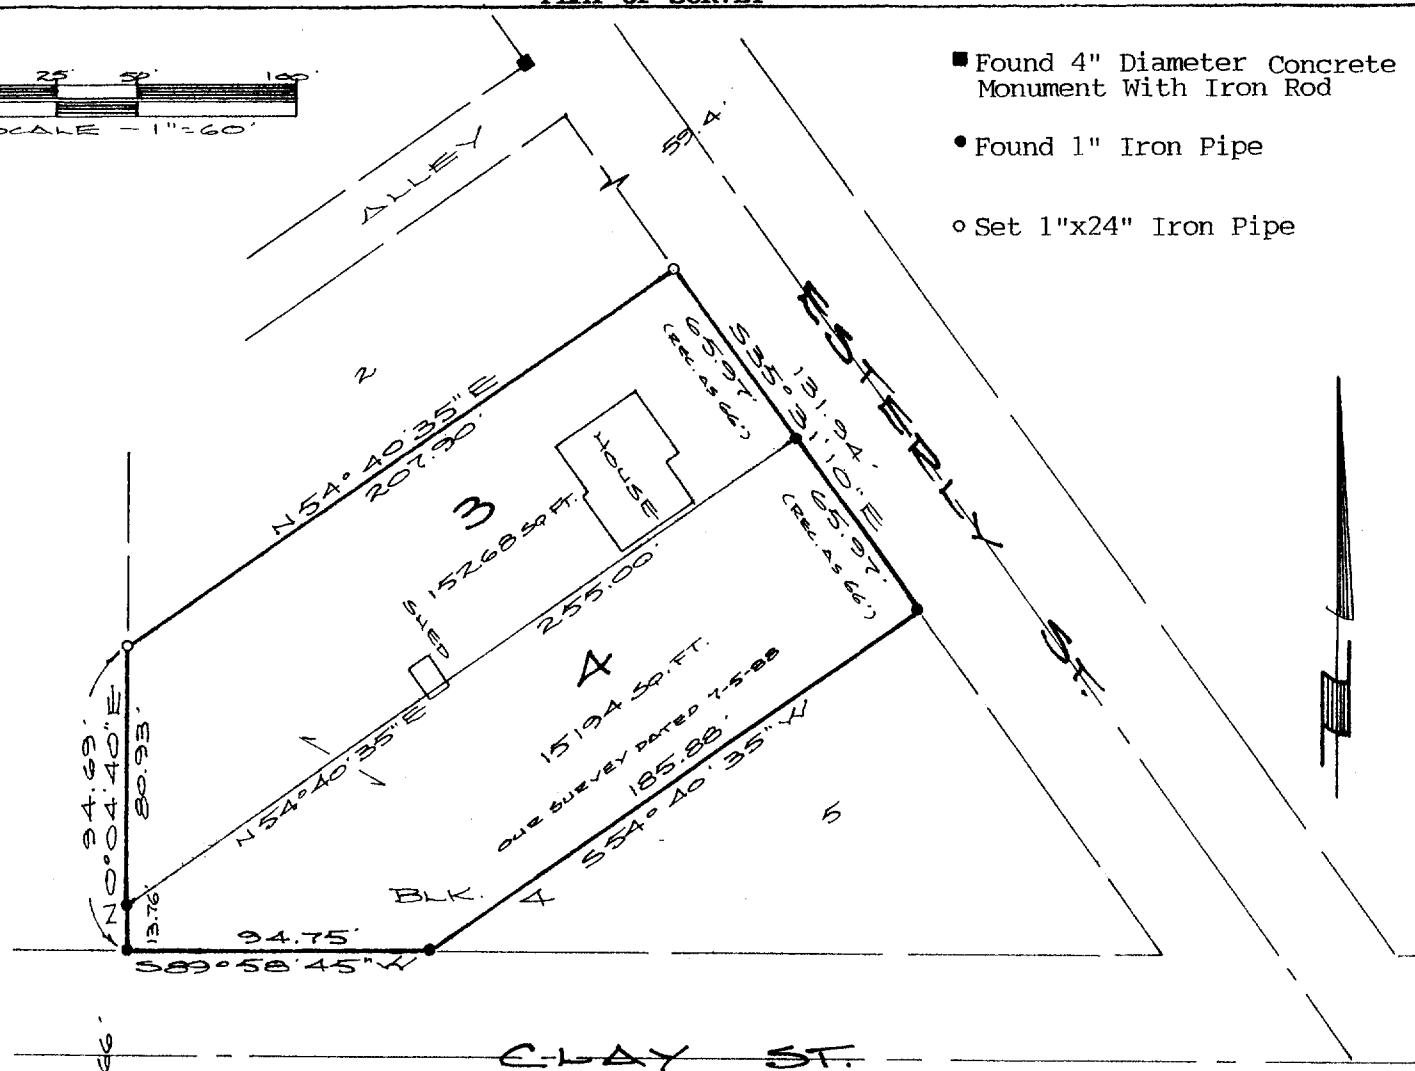

- Found 4" Diameter Concrete Monument With Iron Rod
- Found 1" Iron Pipe
- Set 1"x24" Iron Pipe



DESCRIPTION

Lots 3 and 4, Block 4, ESTERLY ADDITION in the E $\frac{1}{2}$ of the SE $\frac{1}{4}$ of Section 4, T4N, R15E, City of Whitewater, Walworth County, Wisconsin.

CERTIFICATION

I hereby certify that the property described above has been surveyed under my responsible direction and supervision and that this map is a correct representation of the lot lines and dimensions and the principle lines of the permanent structures thereon.

Date 4-9-92

James B. Woodman
James B. Woodman
Registered Land Surveyor, S-1239

Prepared for: Sandra Asbury
238 S. Esterly
Whitewater, WI 53190

