


PLAT OF SURVEY

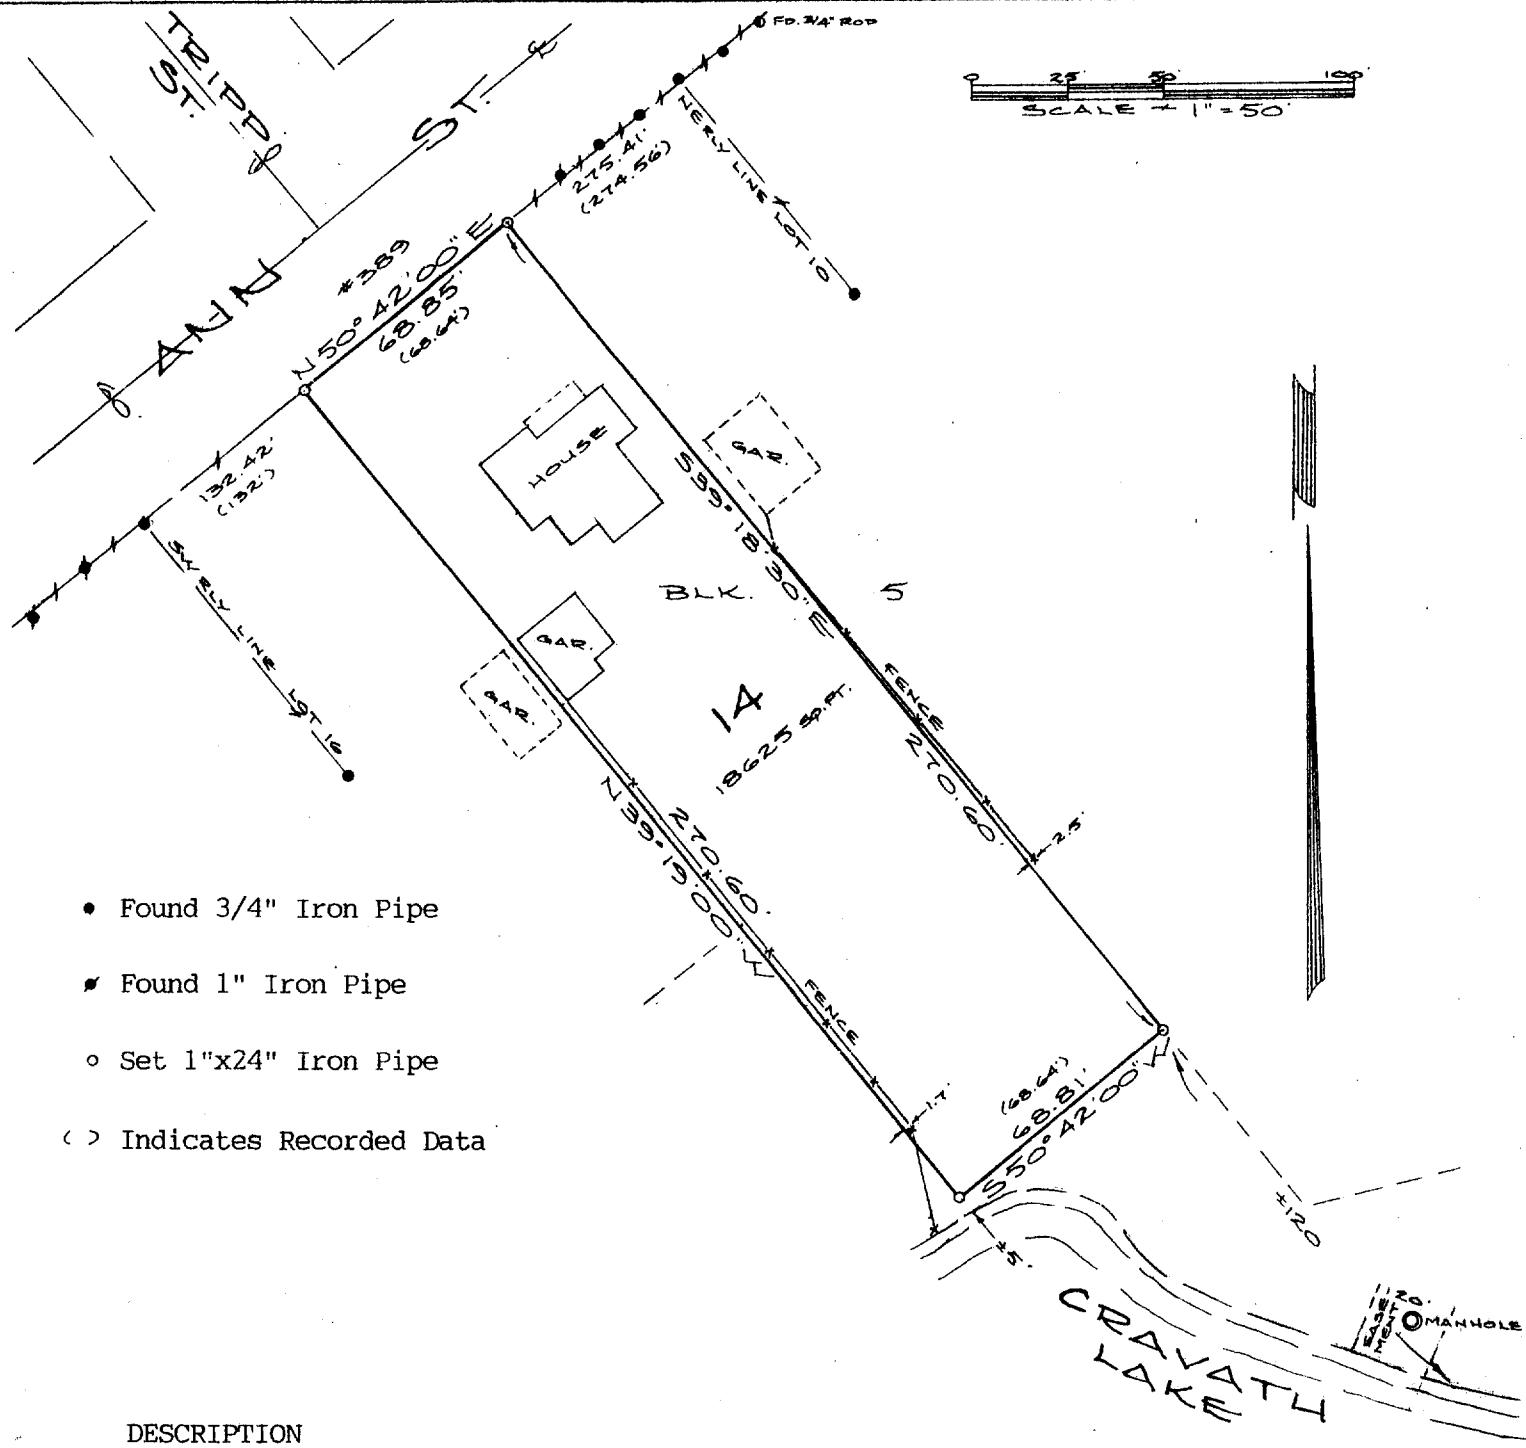

DESCRIPTION

Lot 14, Block 5, TRIPPS ADDITION in the SW $\frac{1}{4}$ of the SW $\frac{1}{4}$ of Section 4, T4N, R15E,
City of Whitewater, Walworth County, Wisconsin.


CERTIFICATION

I hereby certify that the property described above has been surveyed under
my responsible direction and supervision and that this map is a correct
representation of the lot lines and dimensions and the principle lines of
the permanent structures thereon.


Date 9-25-90


James B. Woodman
Registered Land Surveyor, S-1239

Prepared for: Minnie Falk Estate
c/o Attorney Mitch Simon
304 W. Main Street
Whitewater, WI 53190

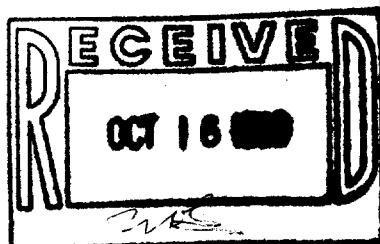

Sheet 1 of 1

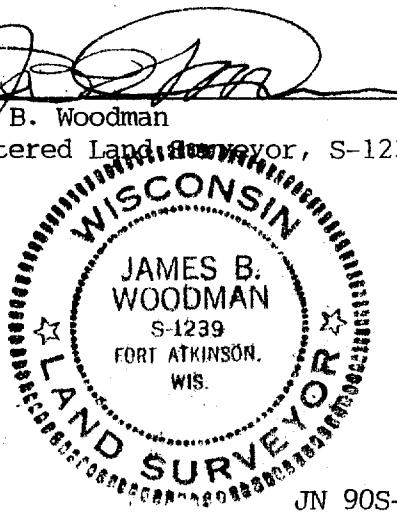

JN 90S-114