


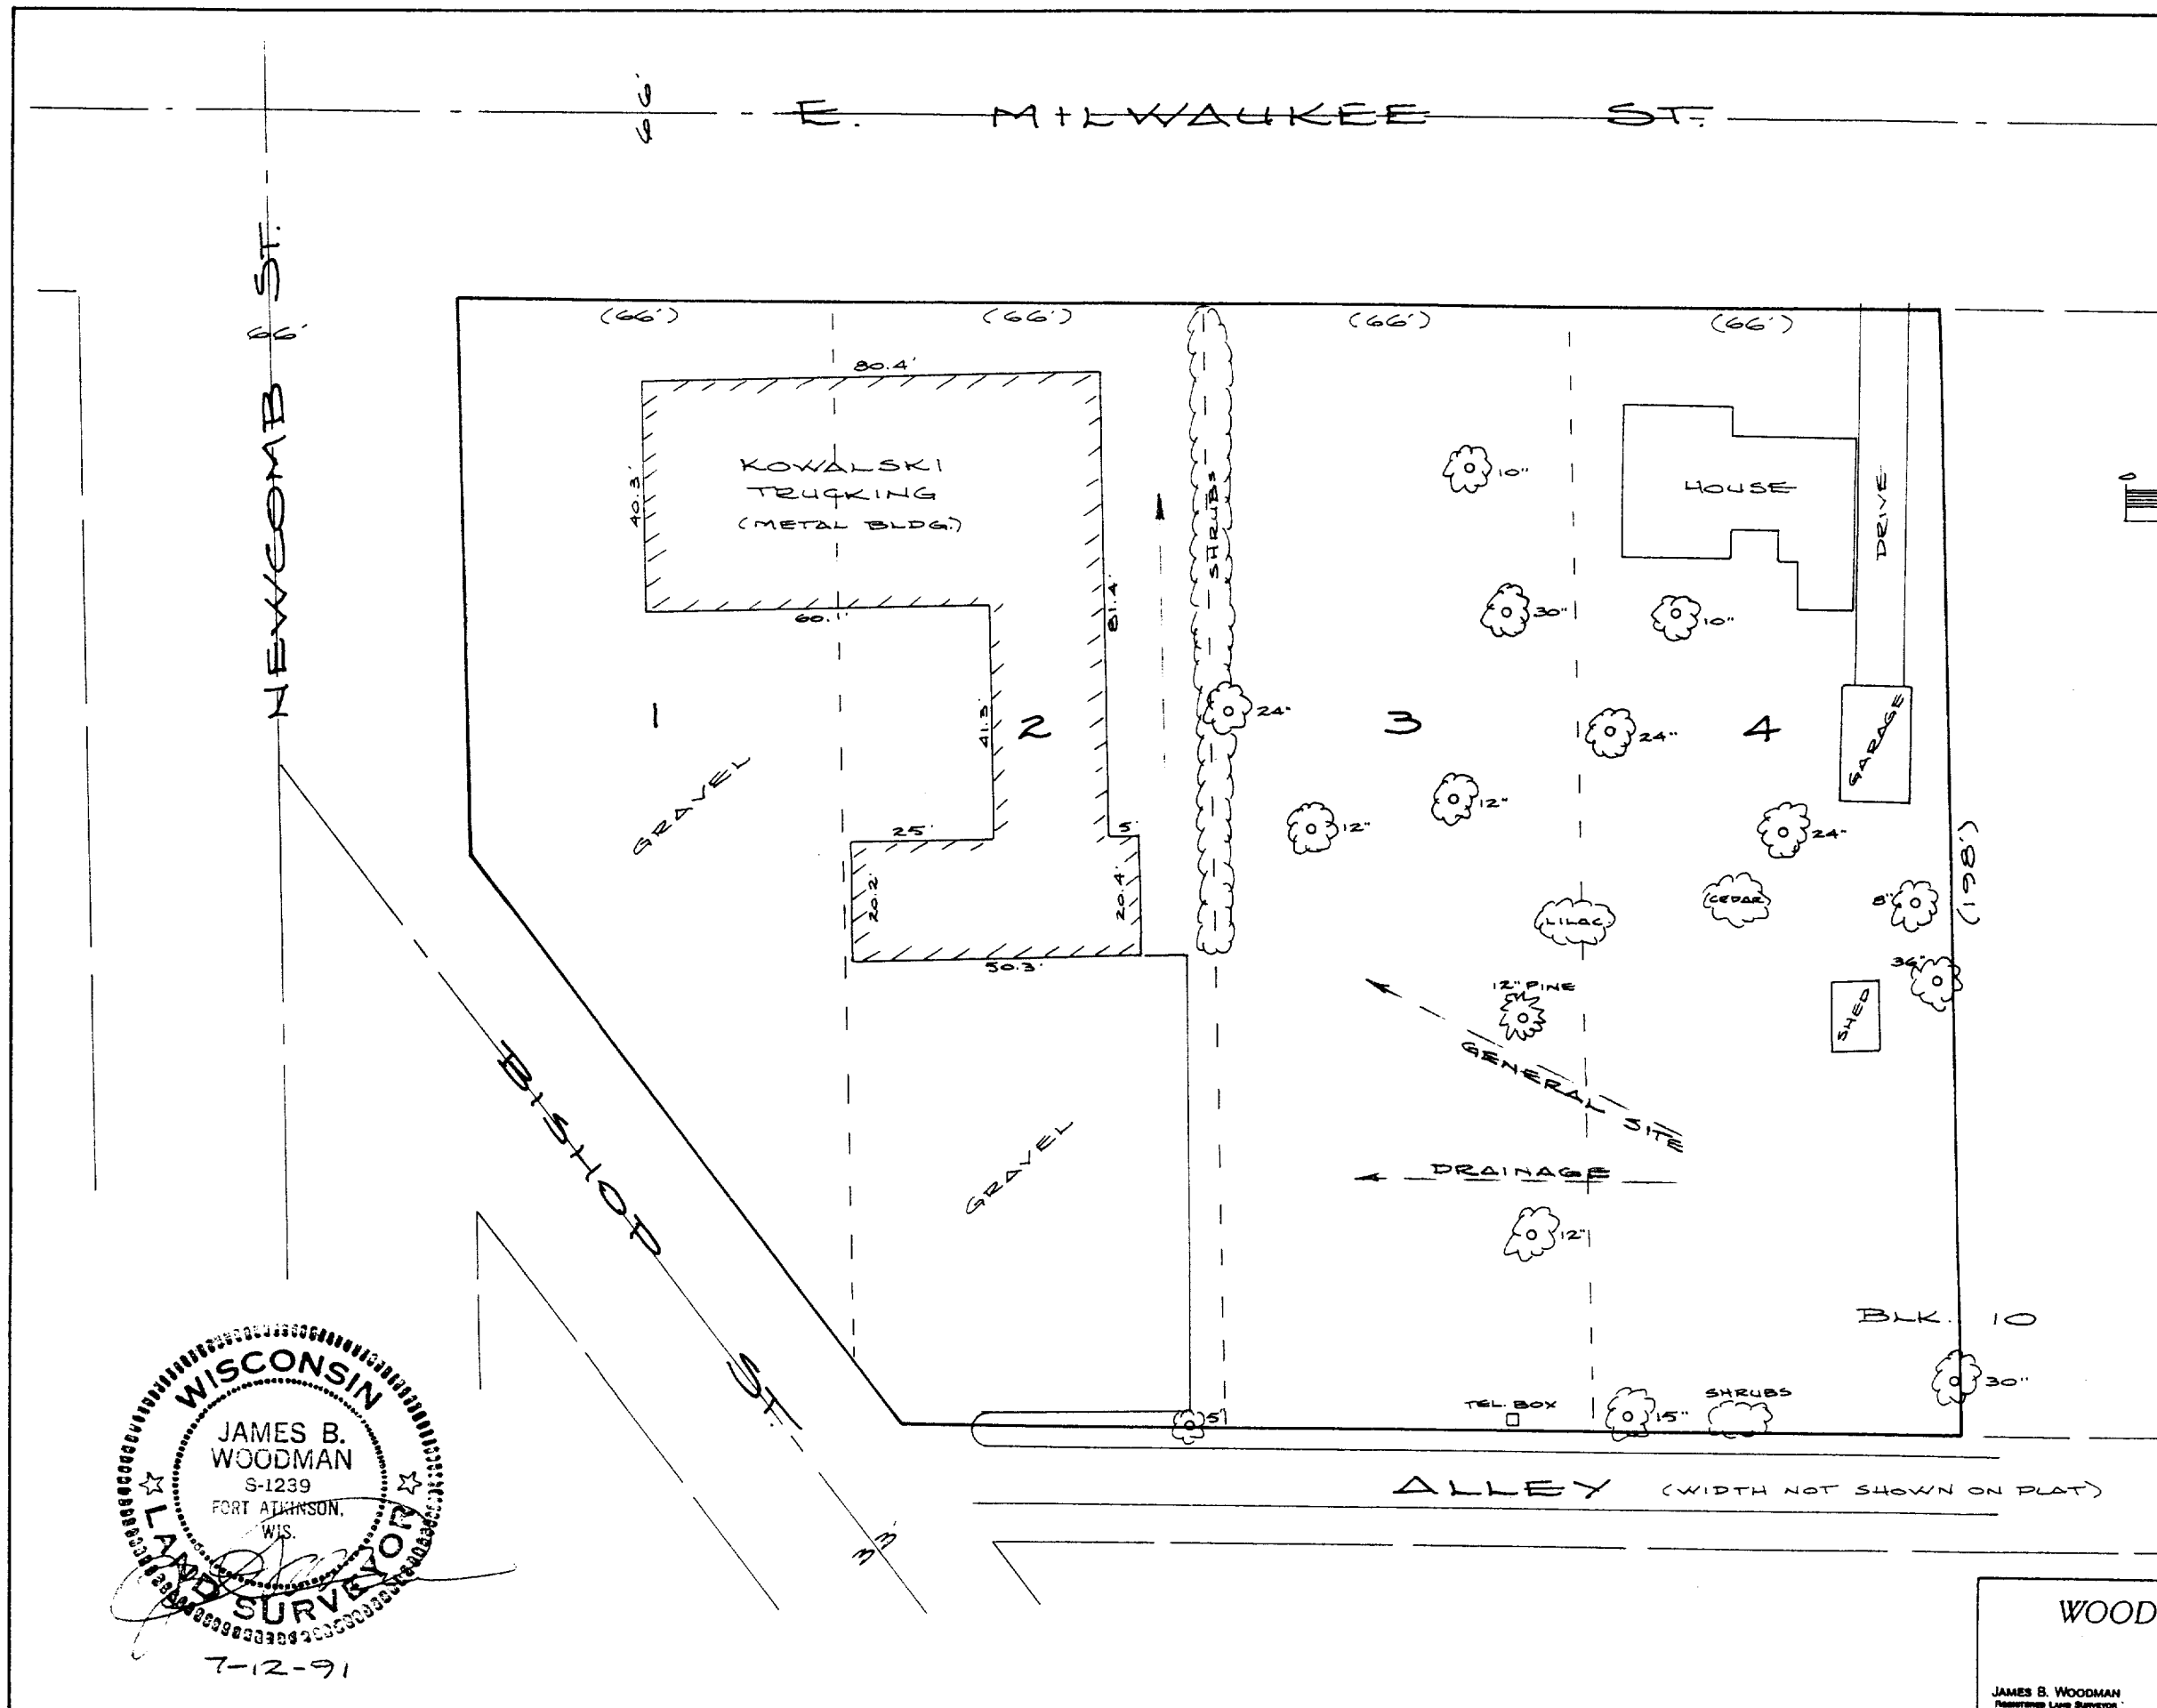

NOTE: Lot dimensions are shown as recorded on the original plat and were not verified.

TOPOGRAPHIC SURVEY OF Lots 1, 2, 3 and 4, Block 10, S.C. HALLS ADDITION in the SW $\frac{1}{4}$ of Section 3, T4N, R15E, City of Whitewater, Walworth County, Wisconsin

Prepared for: Mike Kowalski
KOWALSKI TRUCKING
707 E. Milwaukee
Whitewater, WI 53190

MAILED
JUL 19 1991
ms

WISCONSIN
JAMES B. WOODMAN
S-1239
FORT ATKINSON, WIS.
LAND SURVEYOR
7-12-91

WOODMAN, ANDERSON & ASSOCIATES
Registered Land Surveyors
210 MADISON AVENUE
FORT ATKINSON, WISCONSIN 53538
(414) 583-8162
JAMES B. WOODMAN
Registered Land Surveyor
MARK E. ANDERSON
Registered Land Surveyor

010-464

1 HAS - 59
1 HAS - 59