


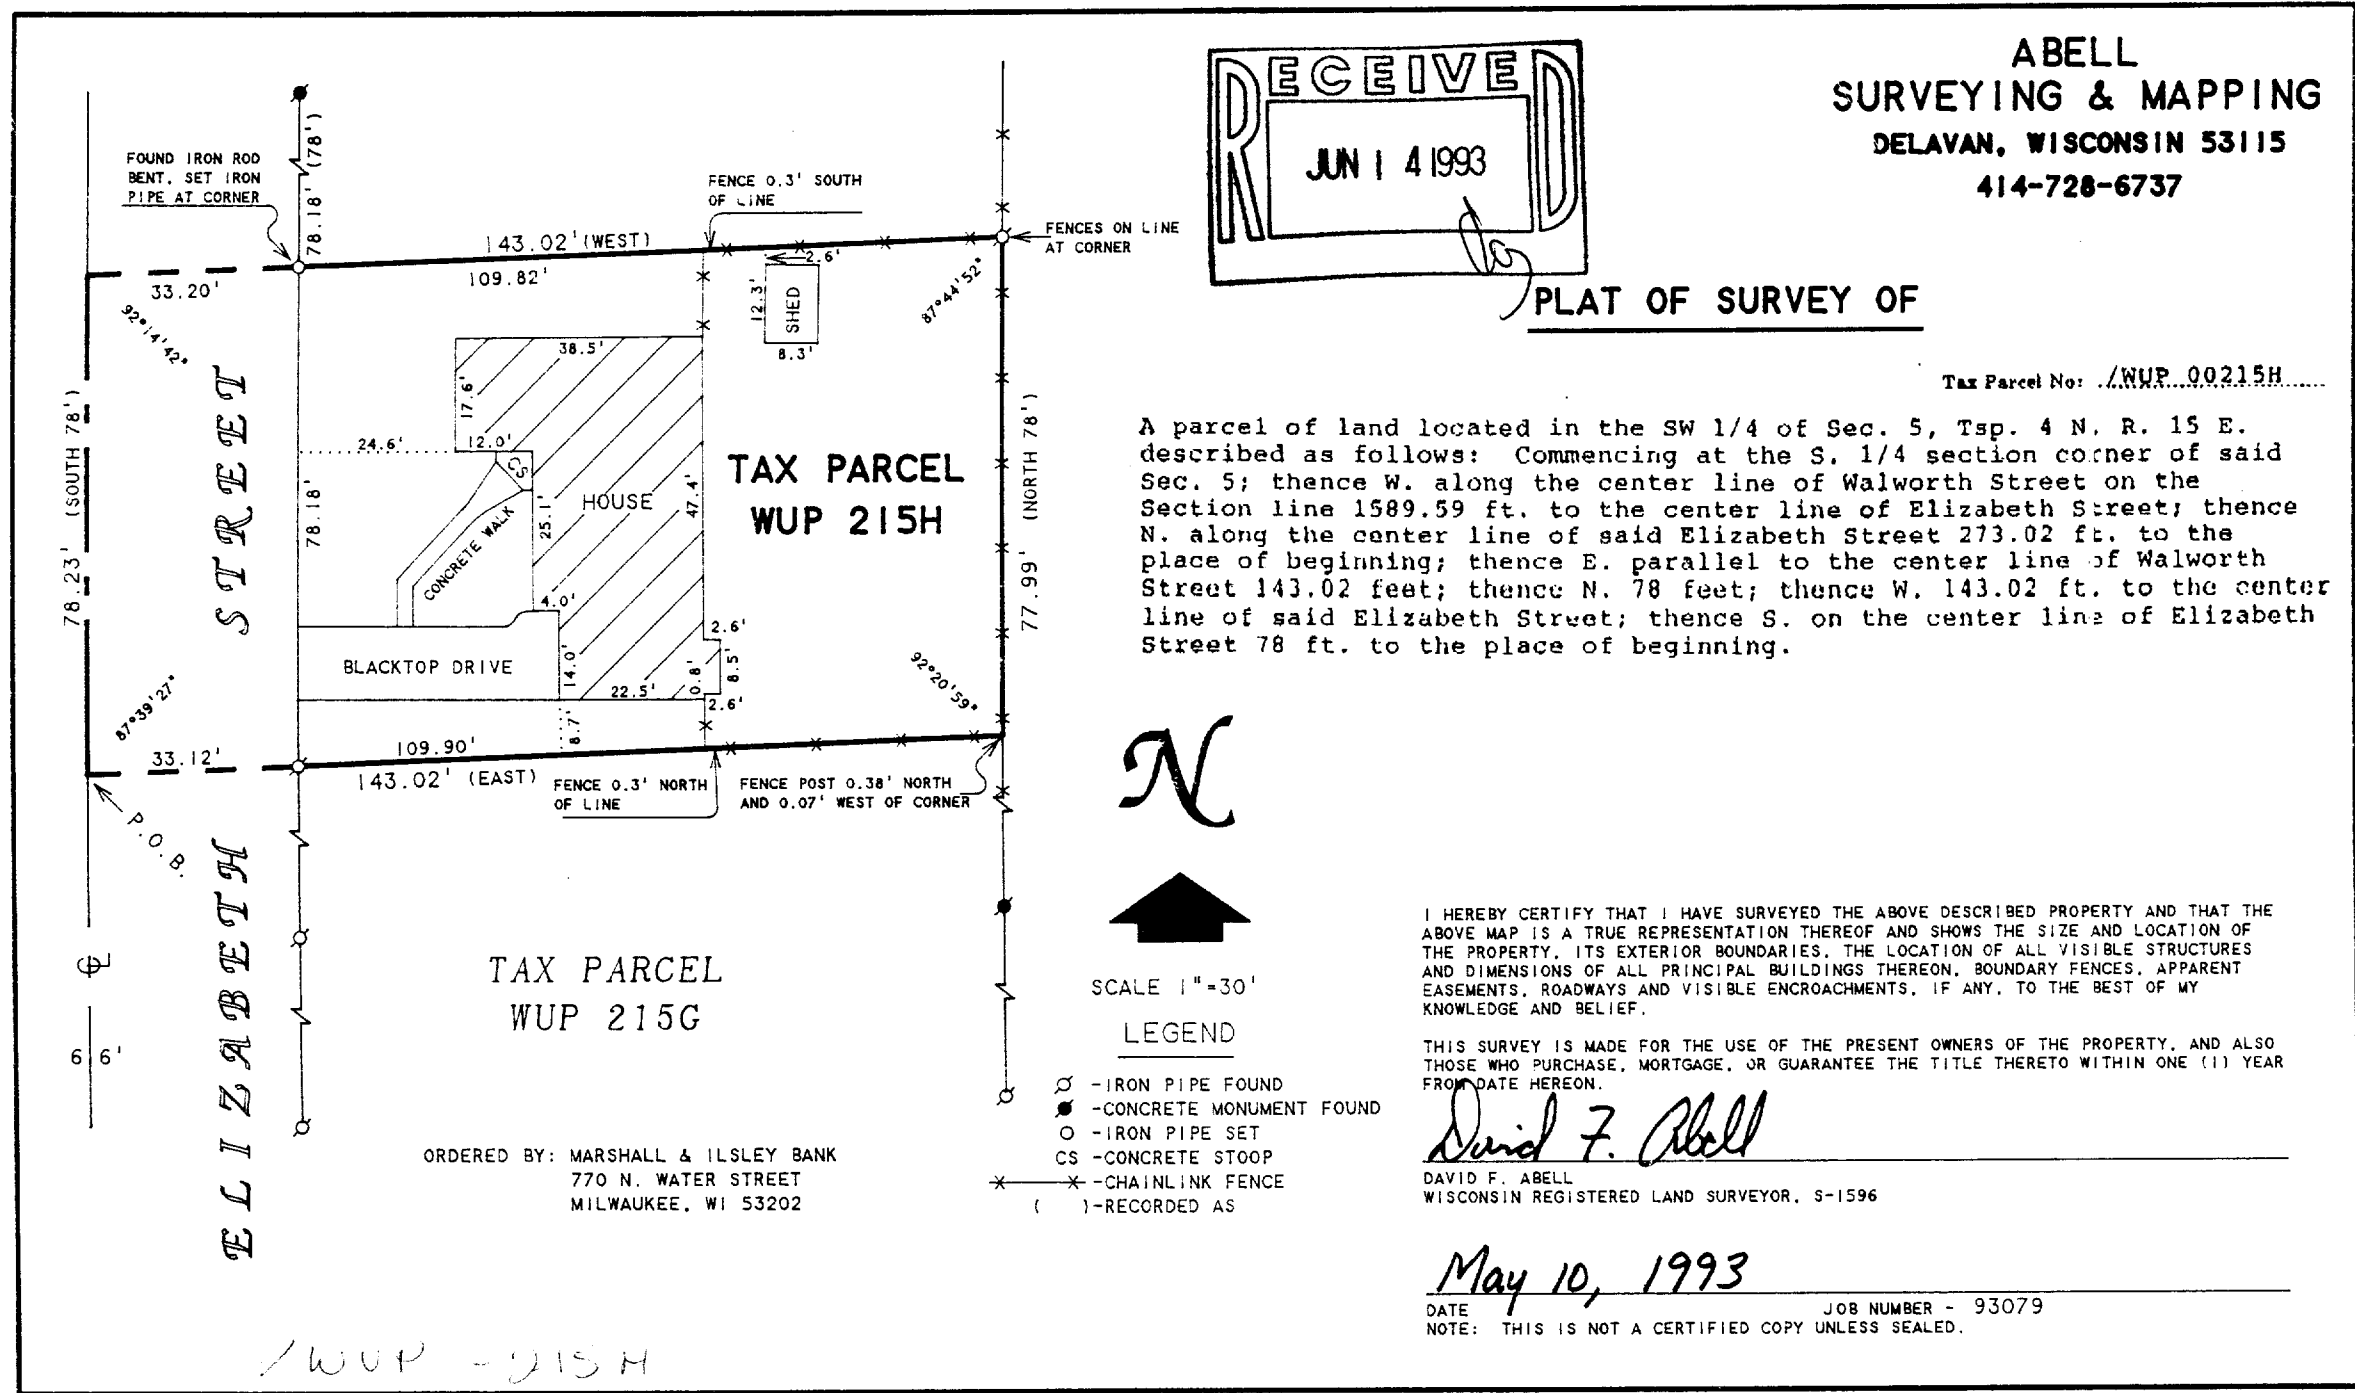

ABELL
SURVEYING & MAPPING
DELAVER, WISCONSIN 53115
414-728-6737

PLAT OF SURVEY OF

Tax Parcel No: ./WUP...00215H.....

A parcel of land located in the SW 1/4 of Sec. 5, Tsp. 4 N. R. 15 E. described as follows: Commencing at the S. 1/4 section corner of said Sec. 5; thence W. along the center line of Walworth Street on the Section line 1589.59 ft. to the center line of Elizabeth Street; thence N. along the center line of said Elizabeth Street 273.02 ft. to the place of beginning; thence E. parallel to the center line of Walworth Street 143.02 feet; thence N. 78 feet; thence W. 143.02 ft. to the center line of said Elizabeth Street; thence S. on the center line of Elizabeth Street 78 ft. to the place of beginning.



SCALE 1"=30'

LEGEND

- - IRON PIPE FOUND
- - CONCRETE MONUMENT FOUND
- - IRON PIPE SET
- CS - CONCRETE STOOP
- ✕ - CHAINLINK FENCE
- () - RECORDED AS

I HEREBY CERTIFY THAT I HAVE SURVEYED THE ABOVE DESCRIBED PROPERTY AND THAT THE ABOVE MAP IS A TRUE REPRESENTATION THEREOF AND SHOWS THE SIZE AND LOCATION OF THE PROPERTY, ITS EXTERIOR BOUNDARIES, THE LOCATION OF ALL VISIBLE STRUCTURES AND DIMENSIONS OF ALL PRINCIPAL BUILDINGS THEREON, BOUNDARY FENCES, APPARENT EASEMENTS, ROADWAYS AND VISIBLE ENCROACHMENTS, IF ANY, TO THE BEST OF MY KNOWLEDGE AND BELIEF.

THIS SURVEY IS MADE FOR THE USE OF THE PRESENT OWNERS OF THE PROPERTY, AND ALSO THOSE WHO PURCHASE, MORTGAGE, OR GUARANTEE THE TITLE THERETO WITHIN ONE (1) YEAR FROM DATE HEREON.

David F. Abell

DAVID F. ABELL
WISCONSIN REGISTERED LAND SURVEYOR, S-1596

May 10, 1993

DATE: May 10, 1993 JOB NUMBER - 93079
NOTE: THIS IS NOT A CERTIFIED COPY UNLESS SEALED.

ORDERED BY: MARSHALL & ILSLEY BANK
770 N. WATER STREET
MILWAUKEE, WI 53202

/WUP - 215H

010-495