


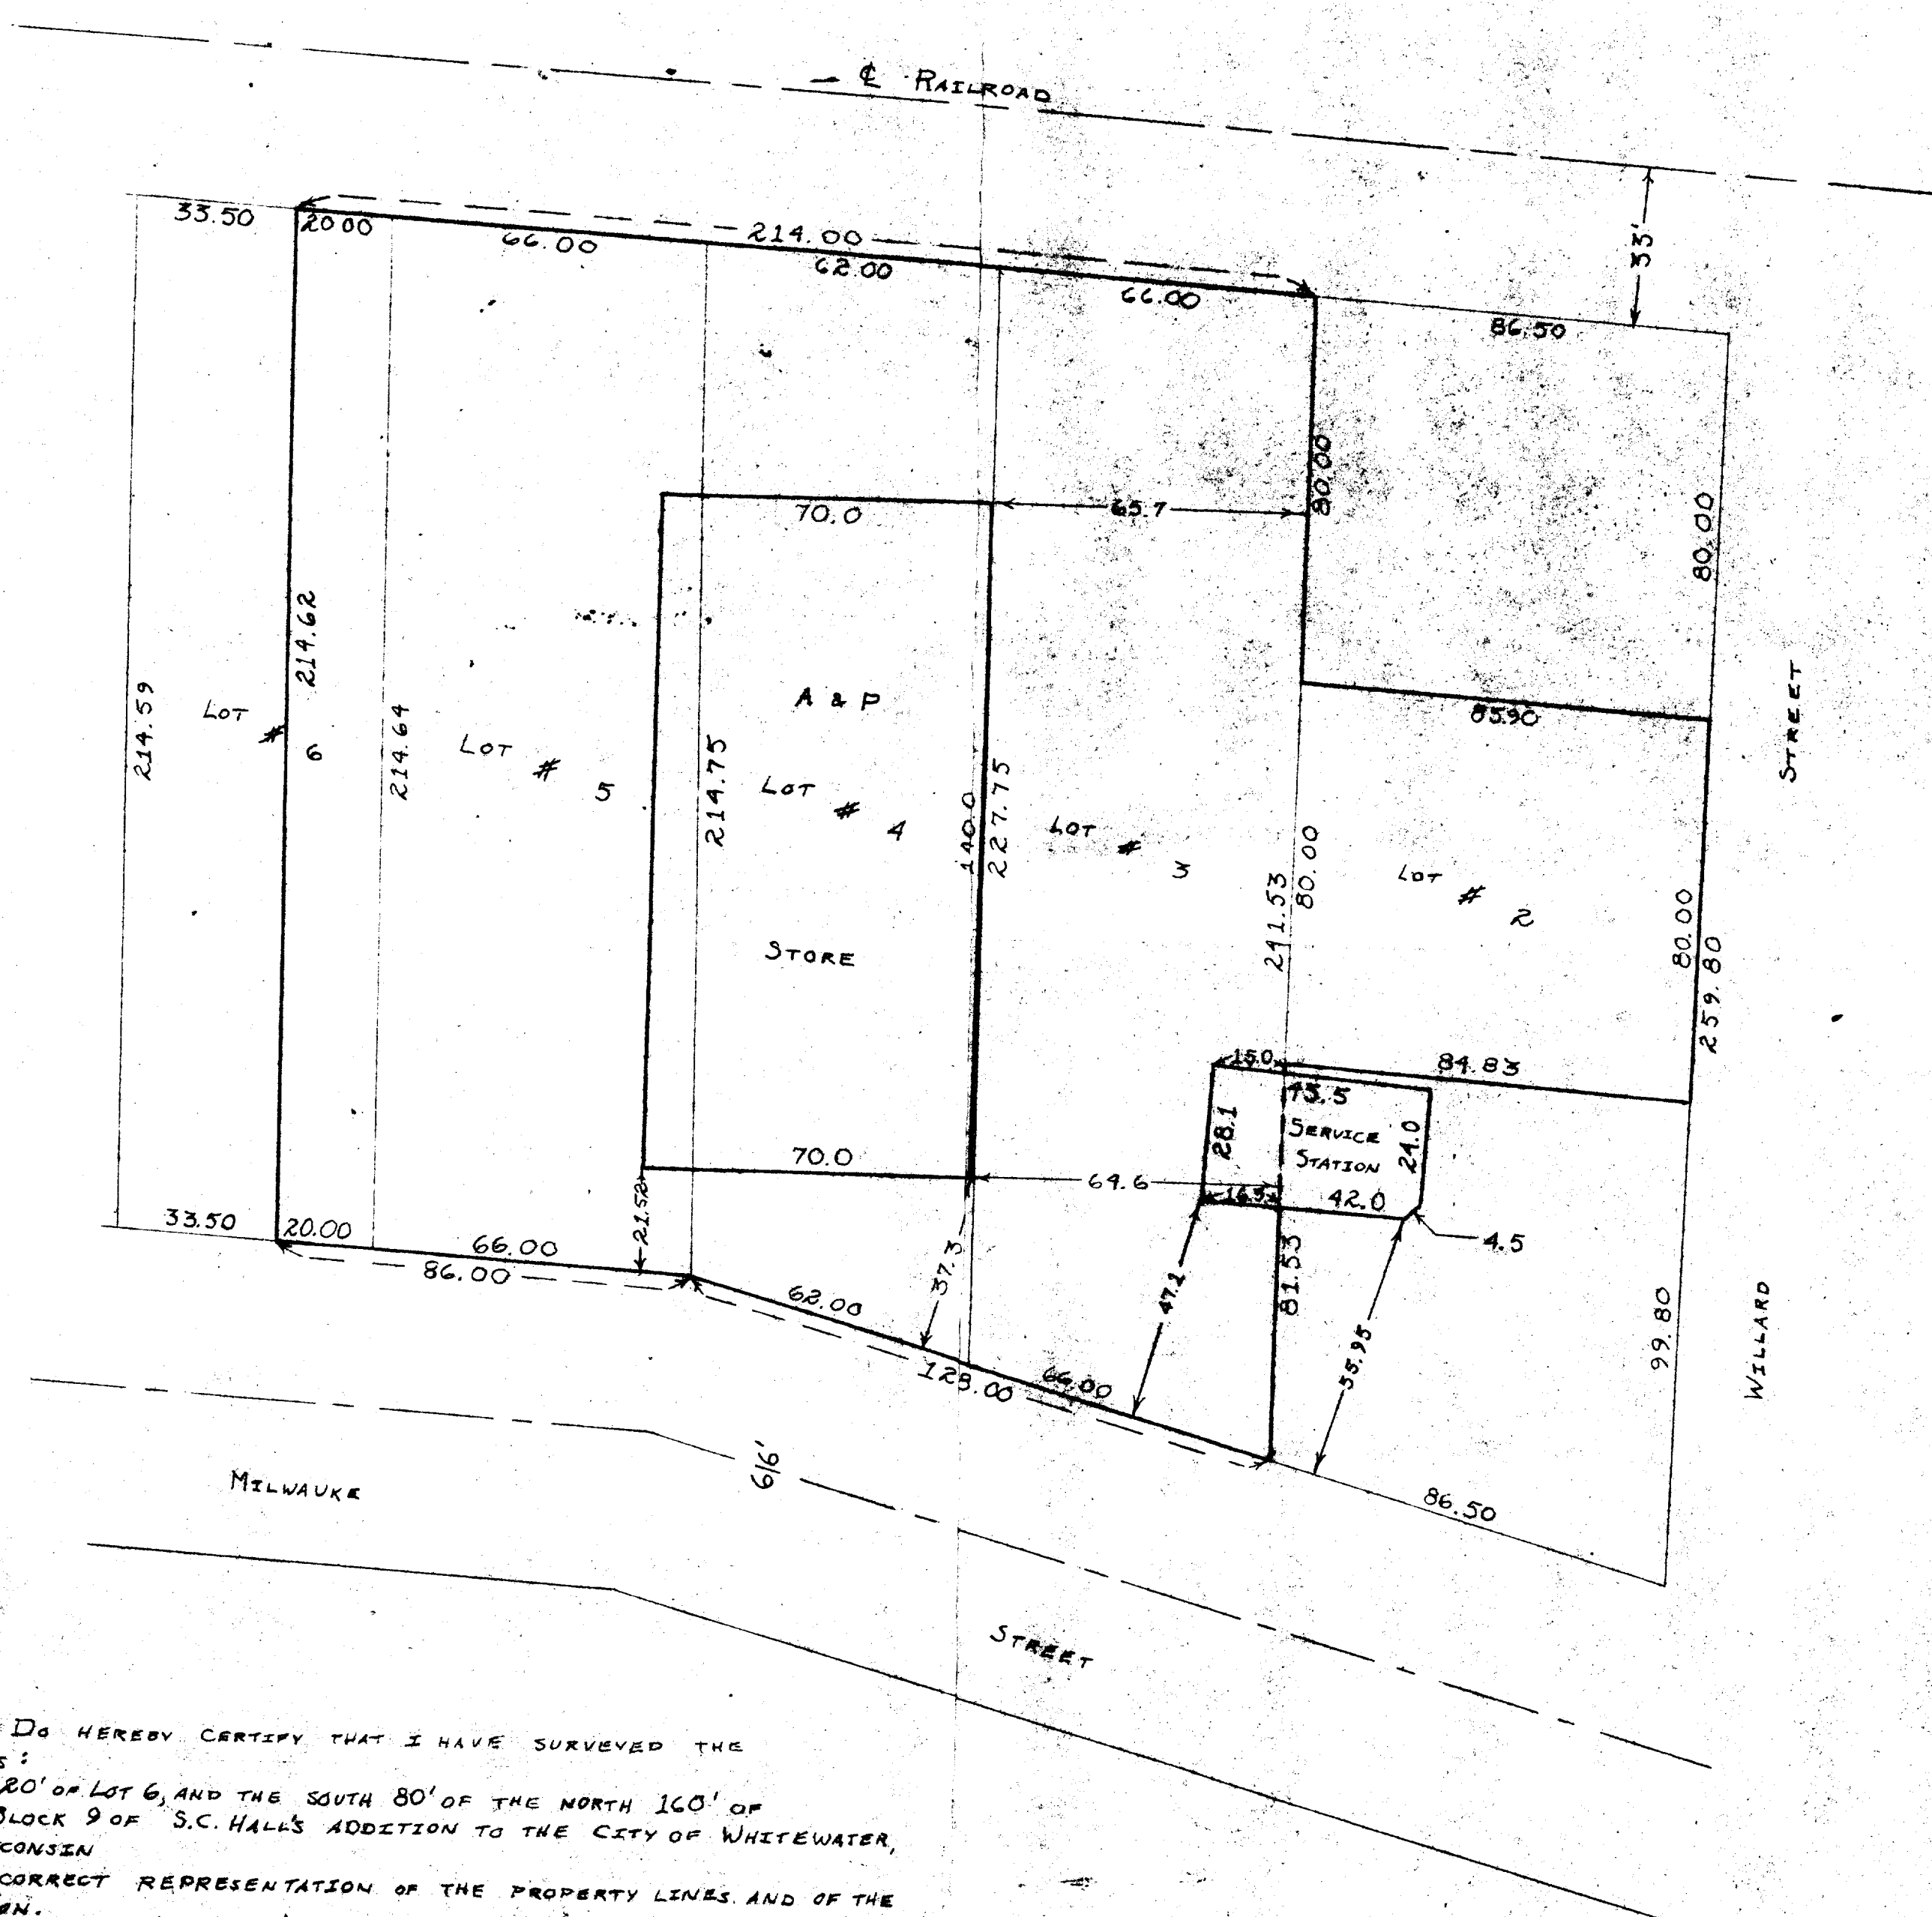

STATE OF WISCONSIN) SS
WALWORTH COUNTY)

I, GEORGE T. DUNHAM, DO HEREBY CERTIFY THAT I HAVE SURVEYED THE PROPERTY DESCRIBED AS FOLLOWS:

LOTS 3, 4, 5, THE EAST 20' OF LOT 6, AND THE SOUTH 80' OF THE NORTH 160' OF LOT 2 LOCATED IN BLOCK 9 OF S.C. HALL'S ADDITION TO THE CITY OF WHITEWATER, WALWORTH COUNTY, WISCONSIN

AND THAT THE ABOVE PLAT IS A CORRECT REPRESENTATION OF THE PROPERTY LINES AND OF THE IMPROVEMENTS LOCATED THEREON.

GEORGE T. DUNHAM, SURVEYOR
DELAVER, WISCONSIN

