



PLAT OF SURVEY

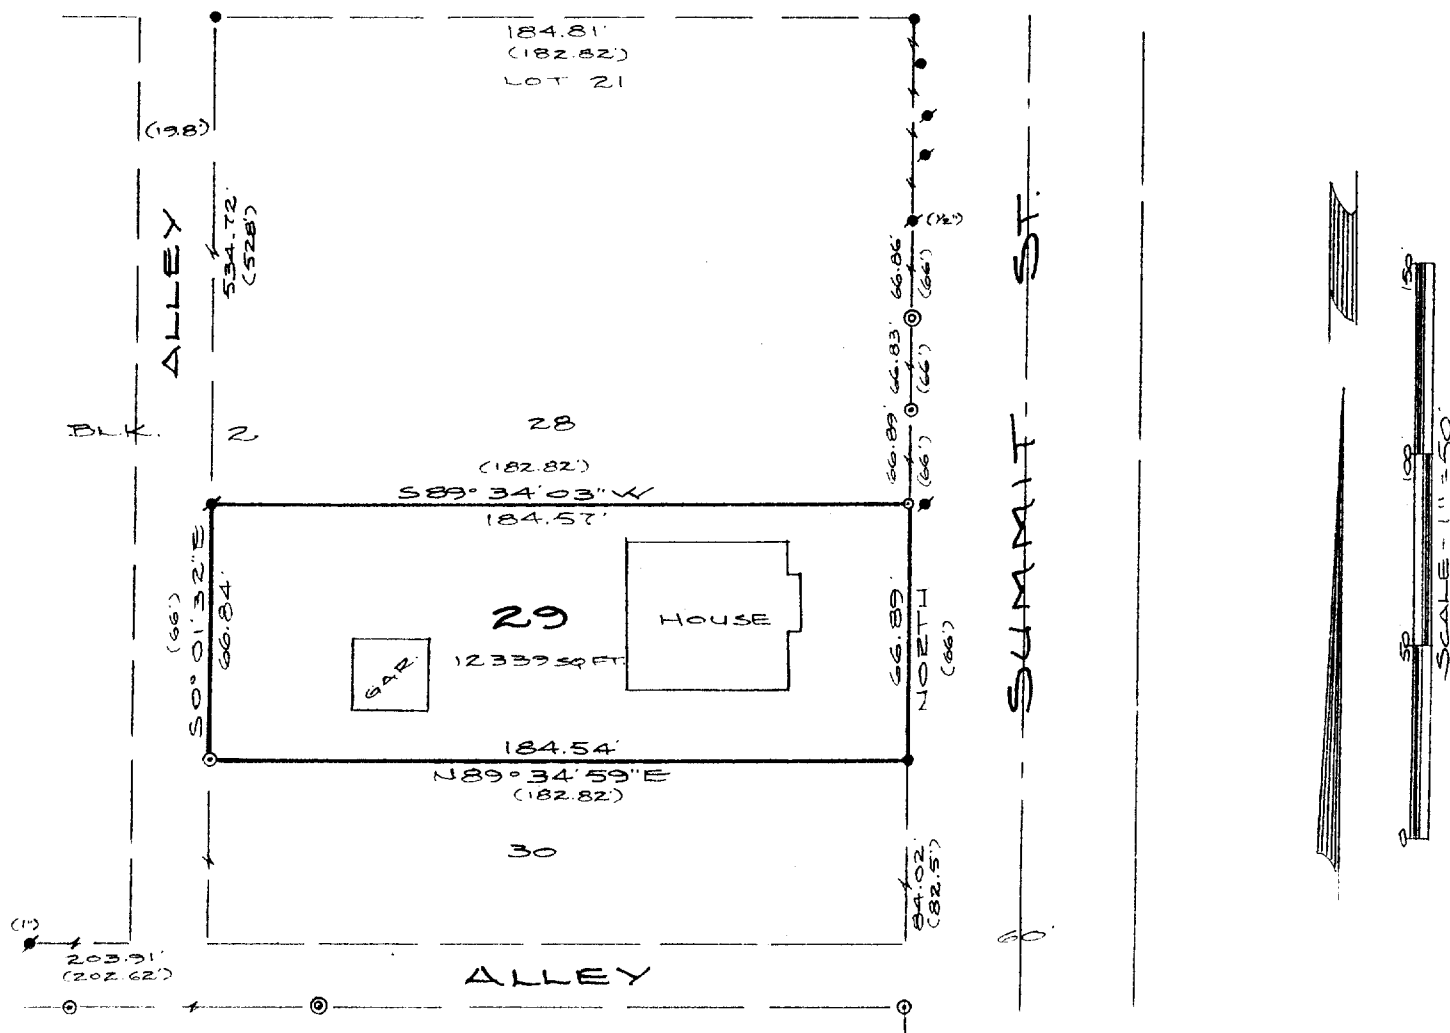

- Found 3/4" Iron Pipe
- Found 3/4" Iron Rod
- ⊙ Found 1 1/4" Iron Pipe
- ⊙ Found 1" Iron Pipe
- Set 1"x24" Iron Pipe

() Indicates data recorded on original plat

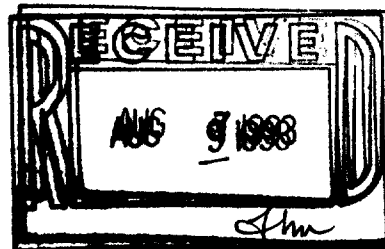

DESCRIPTION


Lot 29, Block 2, BIRGE'S ADDITION in the SE 1/4 of Section 5, T4N, R15E, City of Whitewater, Walworth County, Wisconsin.

CERTIFICATION

I hereby certify that the property described above has been surveyed under my responsible direction and supervision and that this map is an accurate representation of the lot lines and dimensions and the principle lines of the permanent structures thereon.

Date 6-21-93

Prepared for: Laurie Jones
424 S. Summit
Whitewater, WI 53190

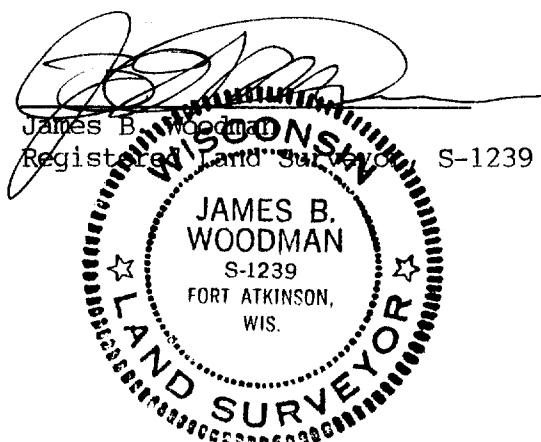

Bir - 35