


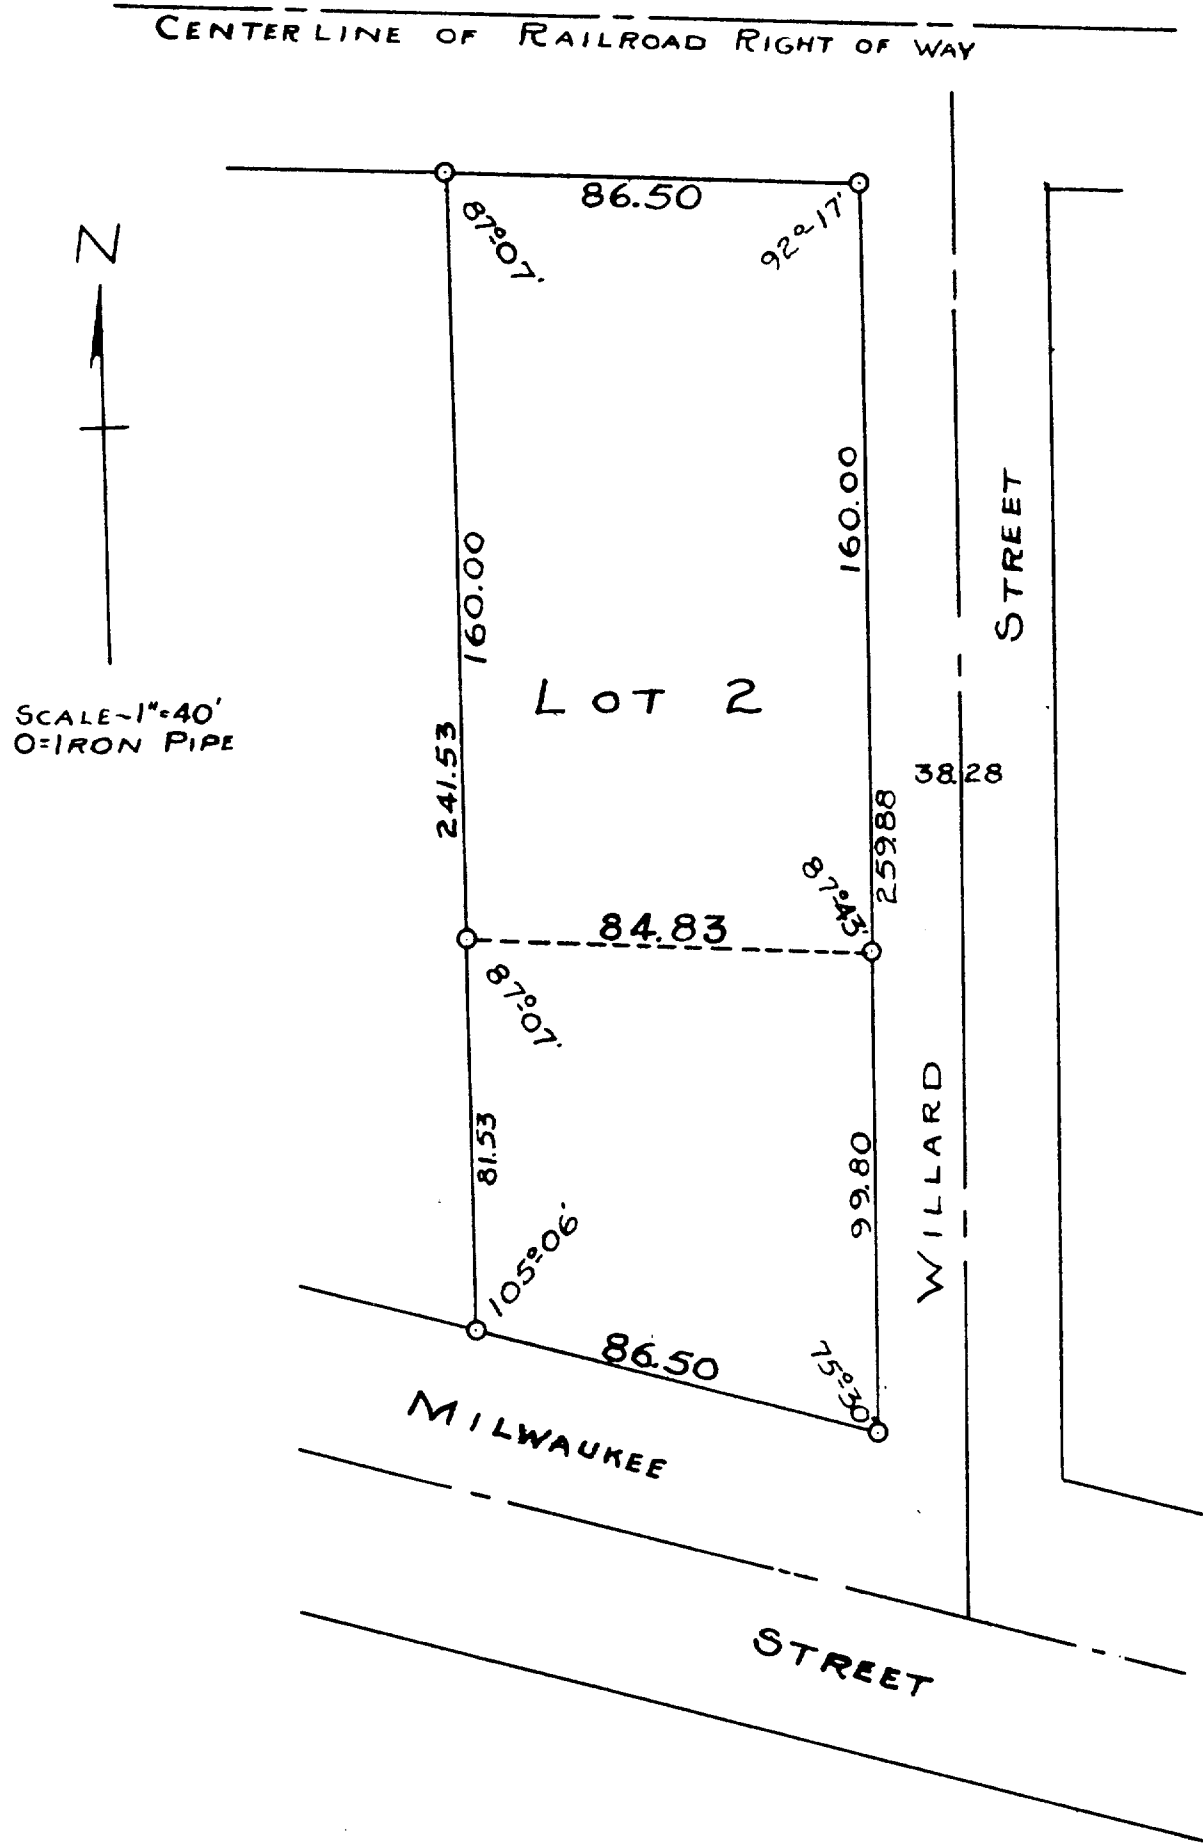

STATE OF WISCONSIN)⁵⁵
COUNTY OF WALWORTH)

I, GEORGE T. DUNHAM, SURVEYOR, DO HEREBY CERTIFY THAT I HAVE
SURVEYED THE PROPERTY DESCRIBED AS FOLLOWS:
LOT 2, BLOCK 9 OF S.C. HALLS ADDITION TO THE CITY OF WHITEWATER
WALWORTH COUNTY, WISCONSIN
AND THAT THE ABOVE PLAT IS A CORRECT REPRESENTATION OF THE LOT LINES.
AUGUST 22, 1955

George T. Dunham

GEORGE T. DUNHAM
SURVEYOR

SUBSCRIBED AND SWORN TO BEFORE ME THIS 22 DAY OF
AUGUST 1955



Martha P. Hotter **MARTHA P. HOTTER**
NOTARY PUBLIC, WALWORTH COUNTY, WISCONSIN
MY COMMISSION EXPIRES June 10 1957