


PLAT OF SURVEY

FOR: WISCONSIN ELECTRIC

NO: 592

DESCRIPTION: LOT 2, BLOCK 3, ORIGINAL PLAT of the VILLAGE,
now CITY OF WHITEWATER, COUNTY OF WALWORTH,
STATE OF WISCONSIN.

SCALE: 1" = 40'

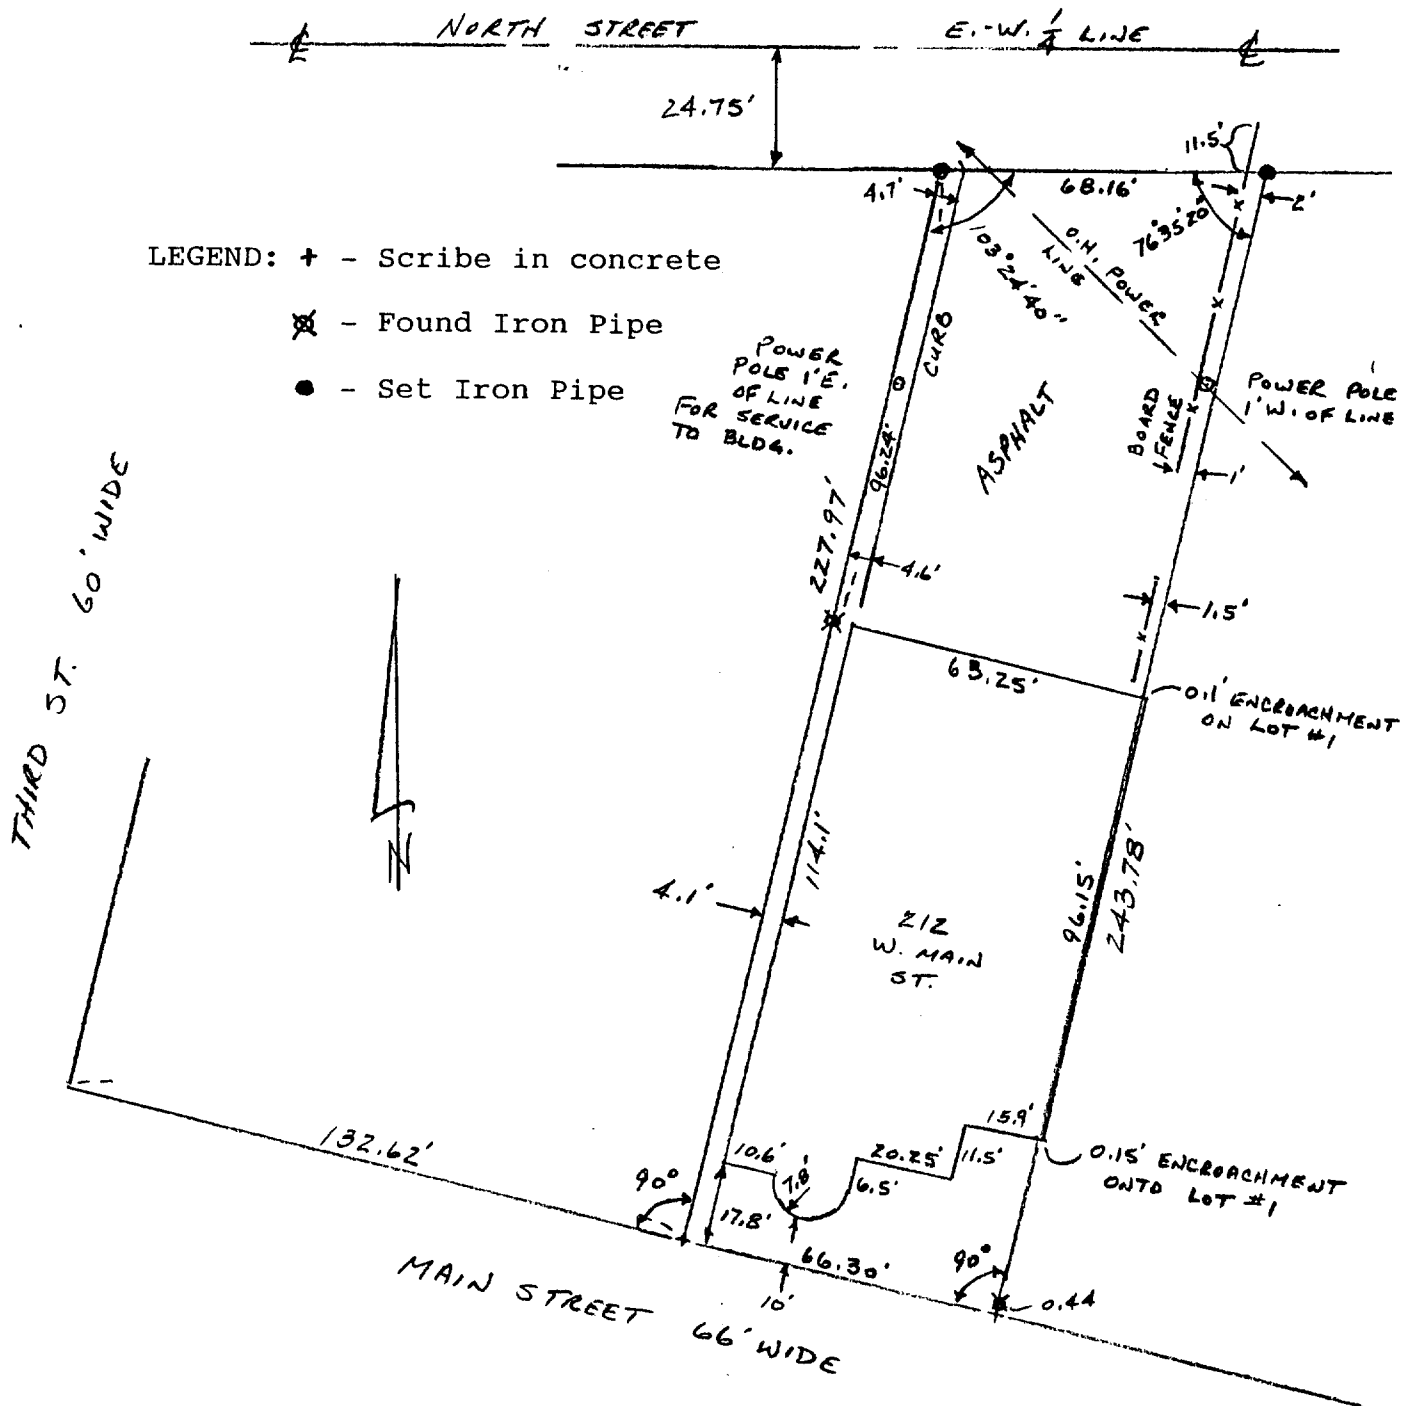


STATE OF WISCONSIN }
COUNTY OF MILWAUKEE } : SS

I HEREBY CERTIFY THAT I HAVE SURVEYED
THE ABOVE DESCRIBED PROPERTY, THAT THE
ABOVE PLAT IS A TRUE REPRESENTATION
THEREOF AND CORRECTLY SHOWS THE
EXTERIOR BOUNDARY LINES.

Richard J. Loy 5-952
REGISTERED LAND SURVEYOR

Feb. 13 1995
DATE

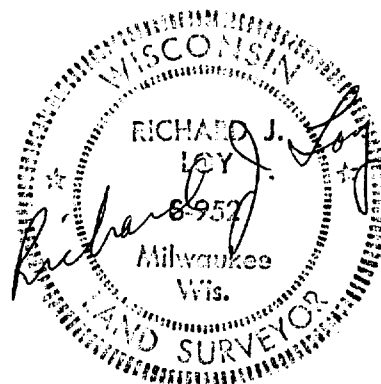

10T-27

010-536