

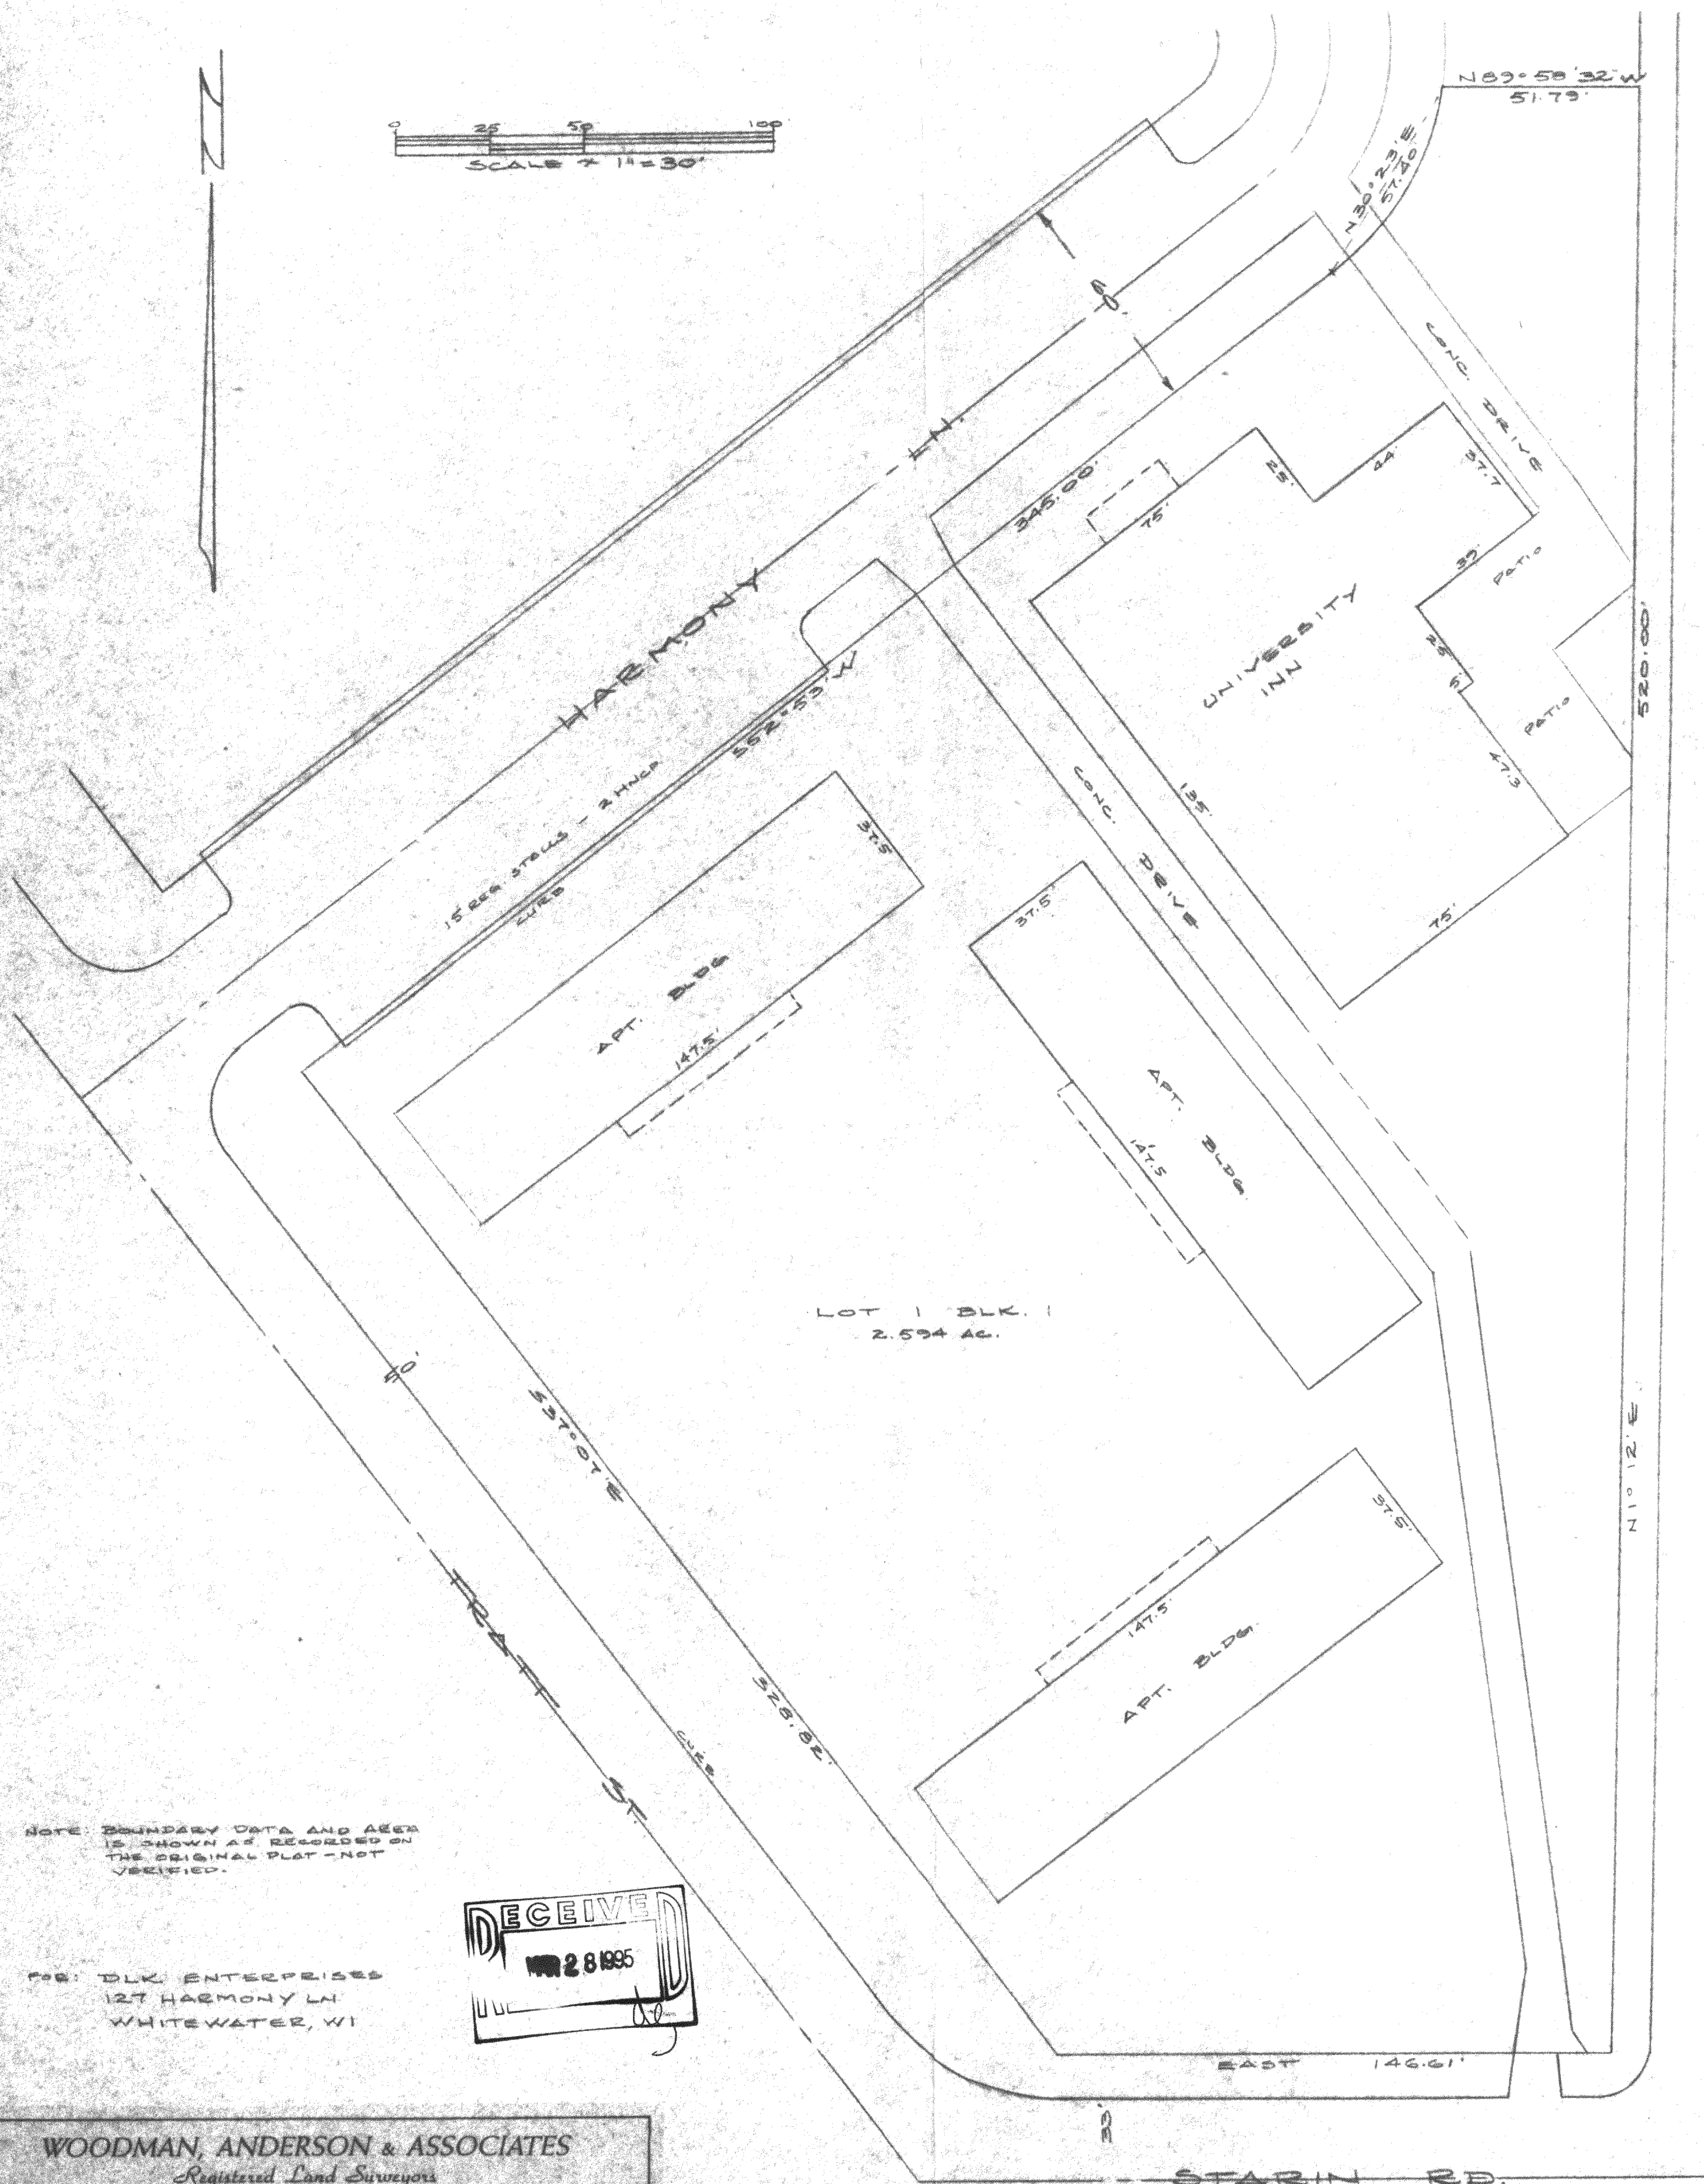


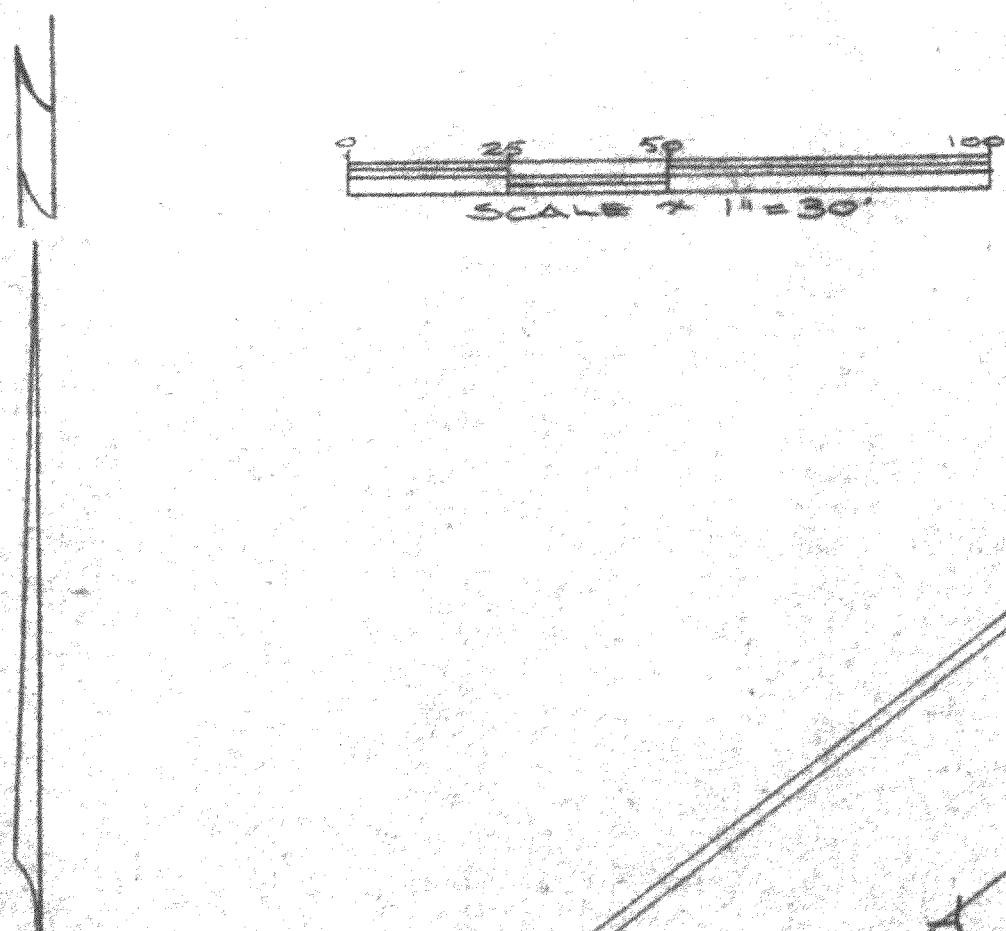


NOTE: BOUNDARY DATA AND AREA IS SHOWN AS RECORDED ON THE ORIGINAL PLAT - NOT VERIFIED.

FOR: DLK ENTERPRISES
127 HARMONY LN.
WHITEWATER, WI

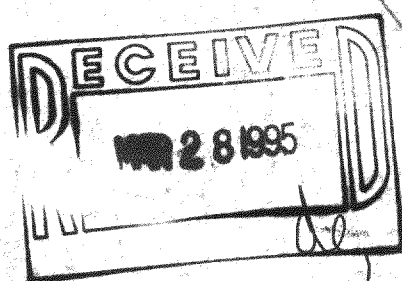

WOODMAN, ANDERSON & ASSOCIATES					
Registered Land Surveyors					
JAMES B. WOODMAN REGISTERED LAND SURVEYOR		210 MADISON AVENUE FORT ATKINSON, WISCONSIN 53538 (414) 563-8182			
MARK E. ANDERSON REGISTERED LAND SURVEYOR					
TOPOGRAPHIC SURVEY					
LOT 1, BLK. 1, HARMONY HILL IN SECTION 5, T4N, R15E, CITY OF WHITEWATER, WALWORTH CO., WI					
DATE	REV.	DATE	REV.	SCALE	1" = 30'
2-7-95	REV.			JOB NO.	845-33
2-8-95	REV.			SHEET	1 OF 1

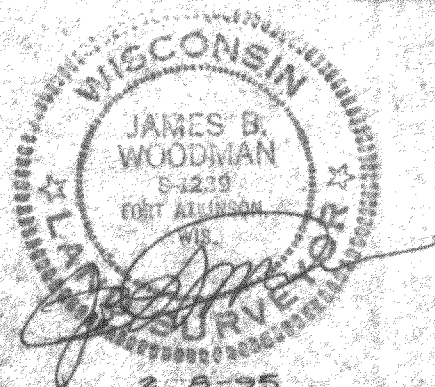

HH-1

010-538