


PLAT OF SURVEY

LOTS 10, 11 AND 12 OF BLOCK 3, OF THE S.C. HALL'S ADDITION TO THE VILLAGE (NOW CITY) OF WHITEWATER, BEING A PART OF THE SOUTHWEST 1/4 OF SECTION 3, TOWN 4 NORTH, RANGE 15 EAST, IN THE CITY OF WHITEWATER, WALWORTH COUNTY, WISCONSIN.
SURVEYED FOR: HEARTLAND RETIREMENT SERVICES INC.

60' WIDE
CHICAGO STREET

NOTE: LATERAL LOCATION WAS BASED ON AS-BUILT PLANS PROVIDED BY THE CITY OF WHITEWATER.

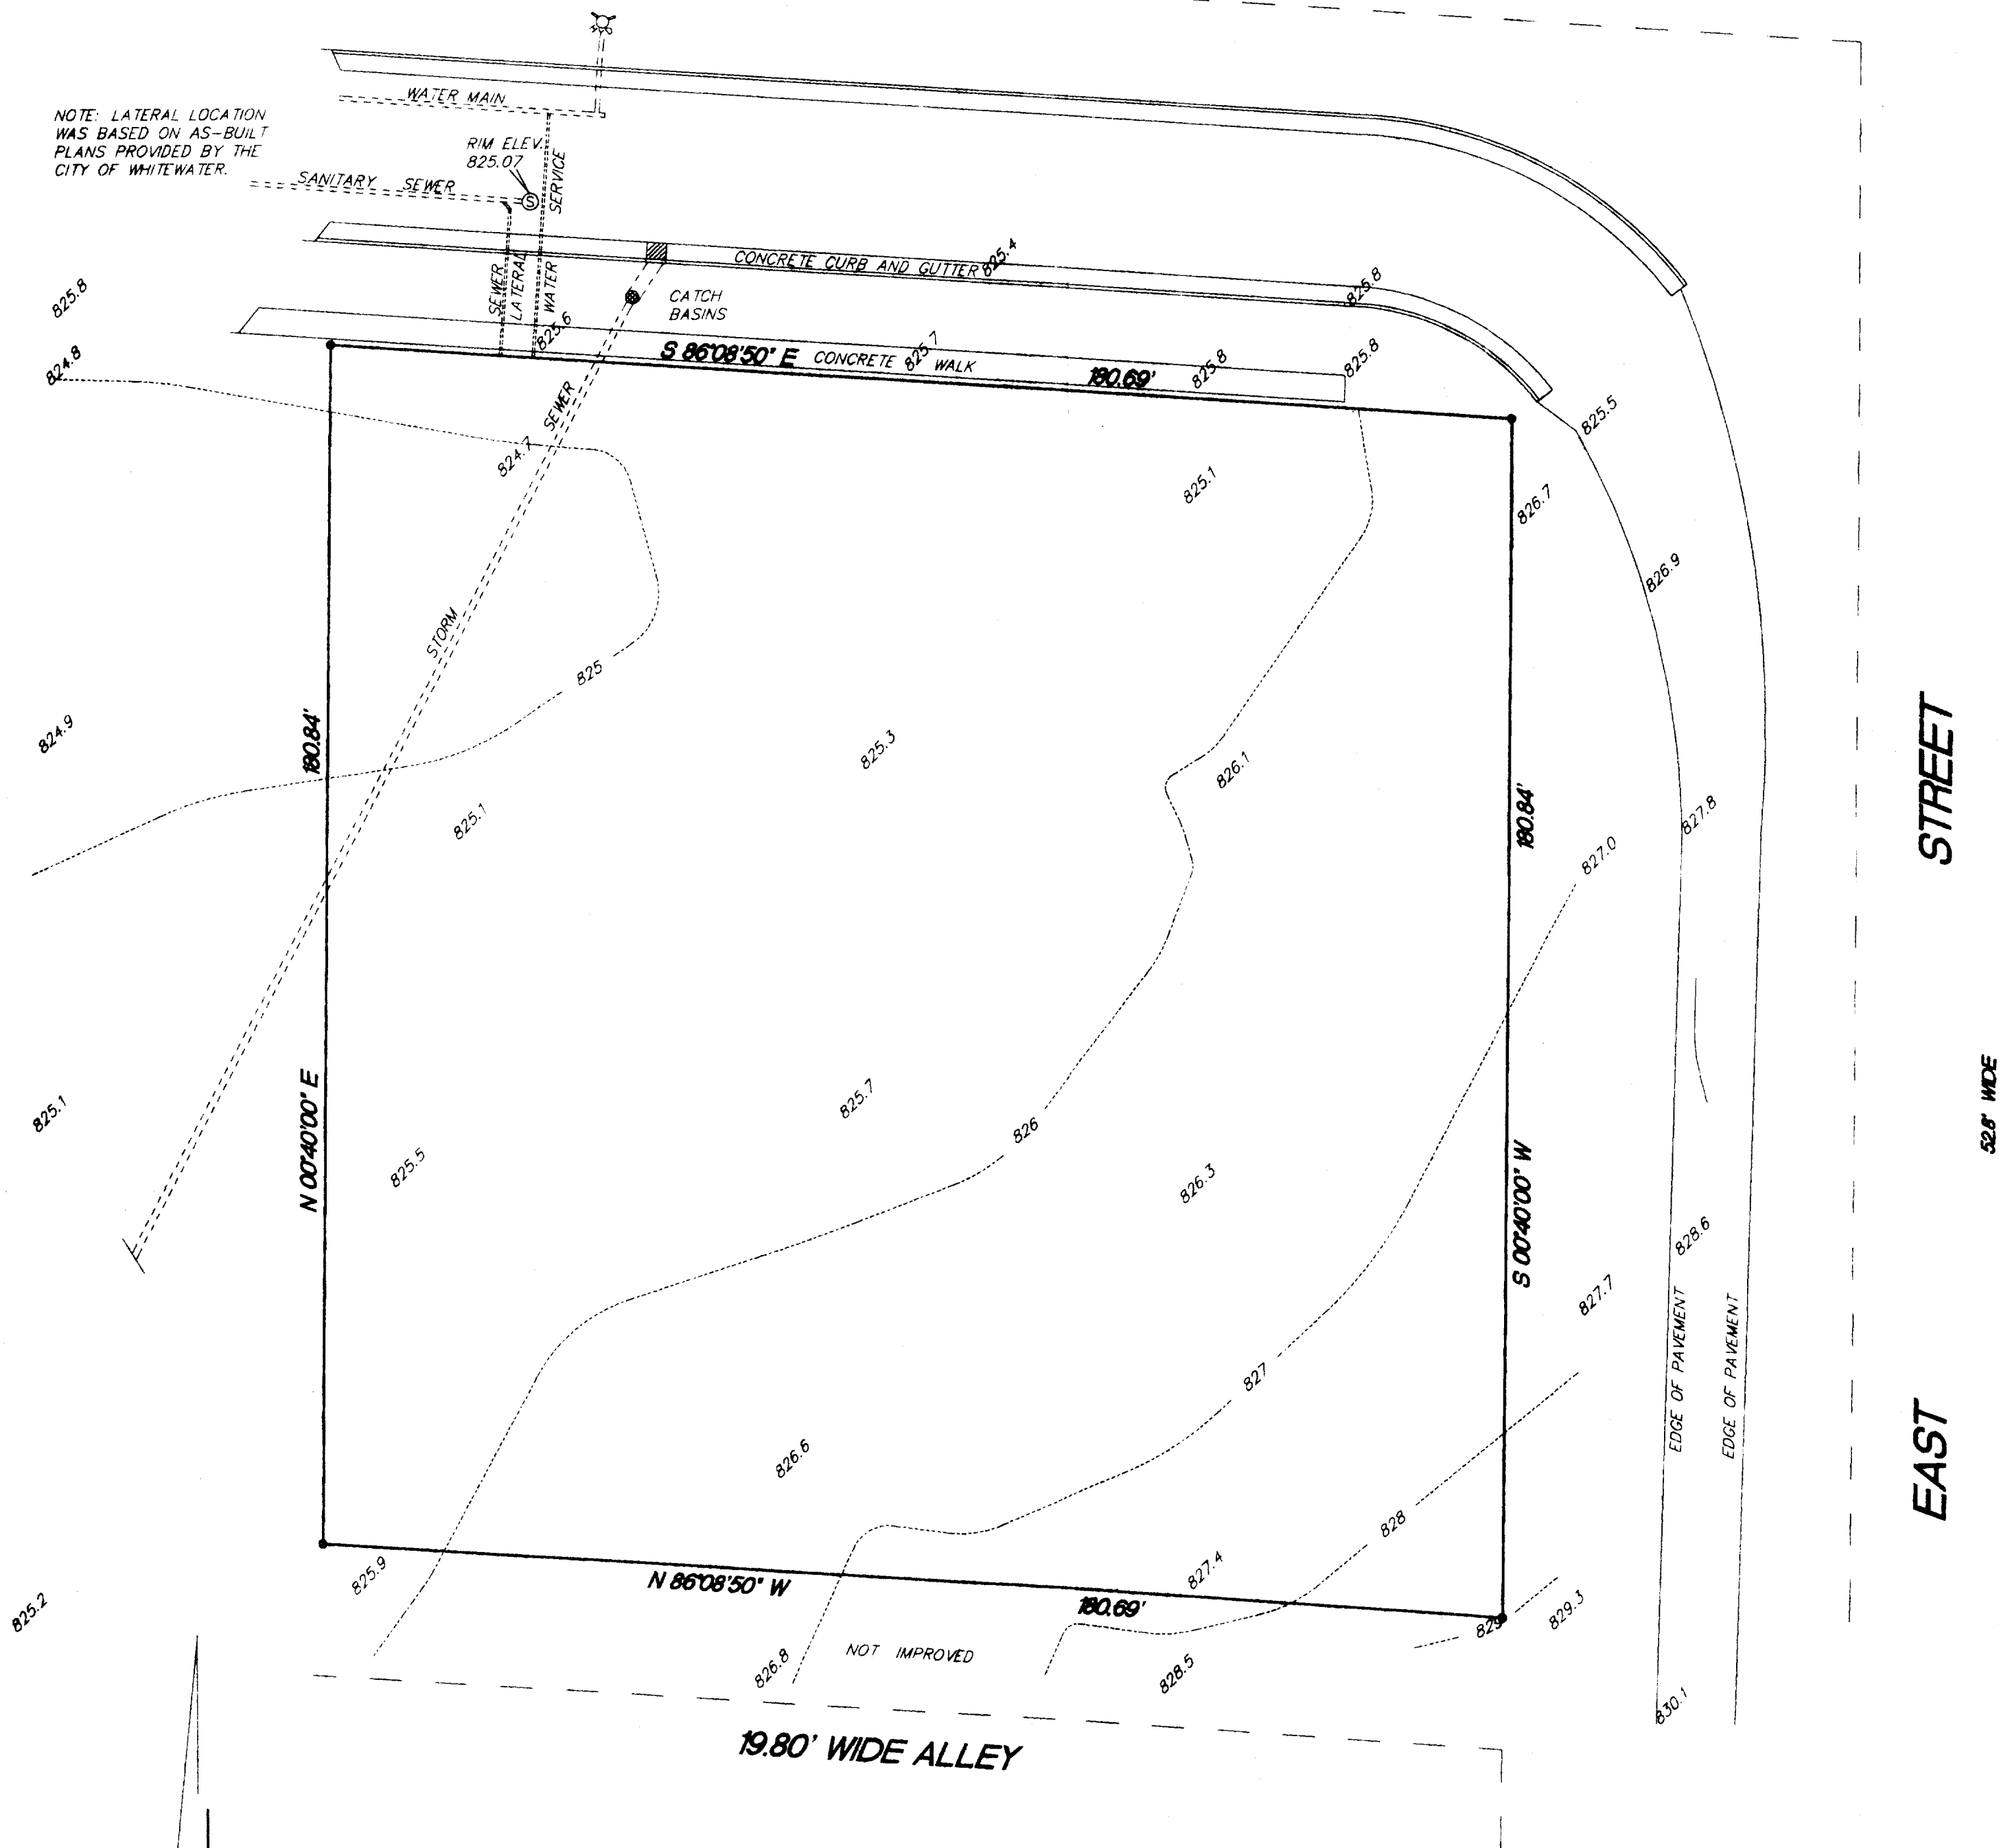

SCALE 1"=20'

I hereby certify that I have surveyed the above property and that the above map is a true representation thereof and shows the size and location of the property, exterior boundaries, the location of all visible structures and dimensions of all principal buildings thereon, boundary fences, apparent easements, roadways and encroachments if any.

This survey is made for the use of the present owners of the property, and also those who purchase, mortgage or guarantee the title thereto within one year from date hereof.

9/13/95 DATE TEP/DRP FIELD WORK BY TEP DRAWN BY 95149 JOB NUMBER

KETTLE MORANE SURVEYING
1902 SIOUX LEVIN LANE
EAGLE, WI 53119
(414) 894-3400
fax (414) 894-3004

WISCONSIN
TERRANCE E. PISAREK
S-1990
EAGLE, WISCONSIN
LAND SURVEYOR

THIS IS NOT AN ORIGINAL SURVEY UNLESS THE SEAL IS RED

830.1 SET 1" IRON PIPE
• SPOT ELEVATIONS

