


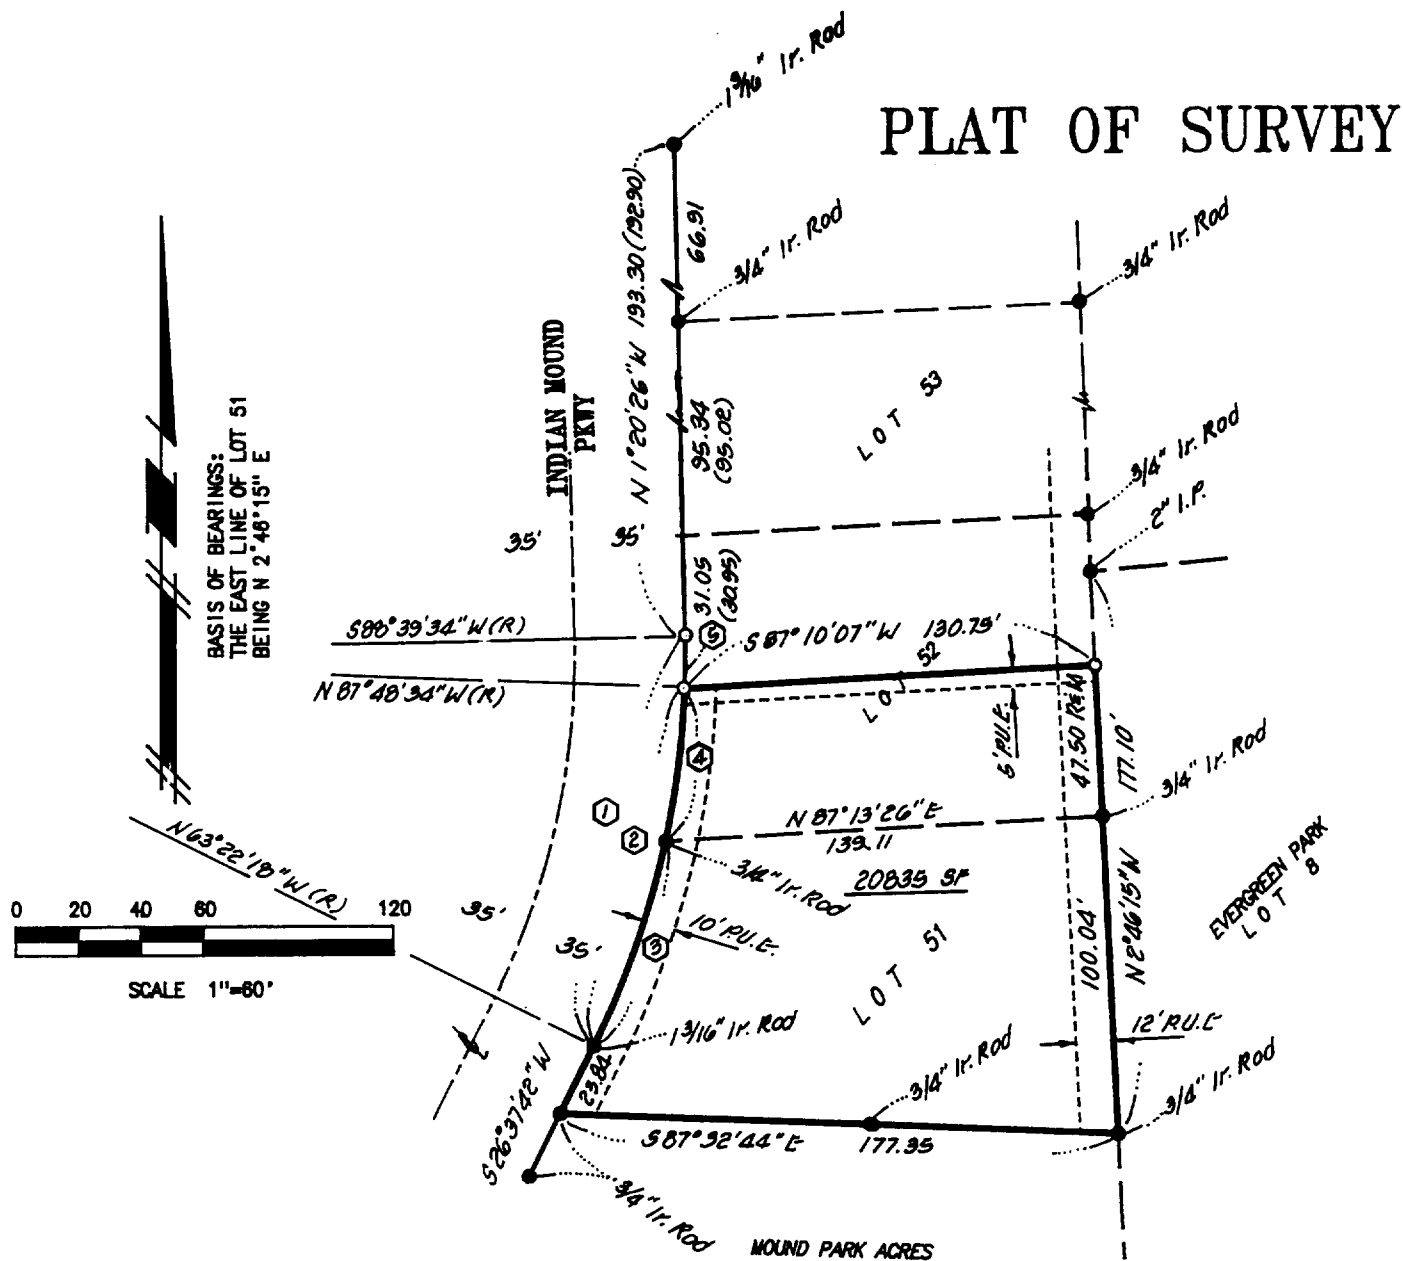

SURVEYOR'S CERTIFICATE

I, JAMES K. LANGONE, REGISTERED LAND SURVEYOR, CERTIFY THAT I HAVE SURVEYED THE PROPERTY HEREIN DESCRIBED:

LOT 51, MOUND PARK ACRES 1ST ADDITION, AND THE SOUTH 1/2, LOT 52, MOUND PARK ACRES 1ST ADDITION MORE PARTICULARLY DESCRIBED AS FOLLOWS:
 BEGINNING AT THE SE CORNER OF SAID LOT 52; THENCE S 87°13'45" W, ALONG THE SOUTH LINE OF SAID LOT 52, 139.13'; THENCE NE'LY ALONG THE WEST LINE OF SAID LOT 52 AND THE ARC OF A CURVE TO THE LEFT (CENTRAL ANGLE - 10°04'55", RADIUS - 273.73', WHOSE CHORD BEARS N 7°16'20" E, 48.10') 48.17'; THENCE N 87°10'16" E, 130.74'; THENCE S 2°46'15" E, ALONG THE EAST LINE OF SAID LOT 47.50', TO THE POINT BEGINNING.
 IN THE CITY OF WHITEWATER, WALWORTH COUNTY, WISCONSIN.

AND THAT THE PLAT SHOWS HEREON IS A CORRECT REPRESENTATION OF THE BOUNDARIES THEREOF.

DATE: 12/1/95

WISCONSIN
 JAMES K. LANGONE
 S-1347
 WHITEWATER
 WISCONSIN
 REG. LAND SURVEYOR S-1347

JAMES K. LANGONE

LAND SURVEYS & CIVIL ENGINEERING

N339 Co. Rd. "N" (Upper) Whitewater, WI. 53190-2842 (414) 473-4119

10-558

1/101-1

JN: 95-115