


PLAT OF SURVEY

LEGAL DESCRIPTION

LOT 62, MOUND PARK ACRES 2ND ADDITION

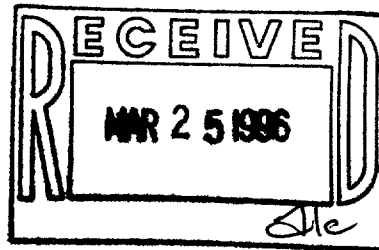

SURVEYOR'S CERTIFICATE

I, JAMES K. LANGONE, REGISTERED LAND SURVEYOR, CERTIFY THAT THE ATTACHED PLAT IS A CORRECT REPRESENTATION OF THE LOCATION OF THE EXISTING FOUNDATION SHOWN, AND WAS PREPARED AT THE REQUEST OF JIM RODGERS.


JAMES K. LANGONE
S-1347
REG. LAND SURVEYOR
WHITEWATER, WI 53190-2842
3/20/96

NOTES

- () -- Indicates Record Distance
 - -- Indicates Monument Found as Noted
- SET-BACKS shown are the minimums discovered and are measured at right-angles to the indicated lot line.

LEGAL DESCRIPTION

LOT 62, MOUND PARK ACRES 2ND ADDITION

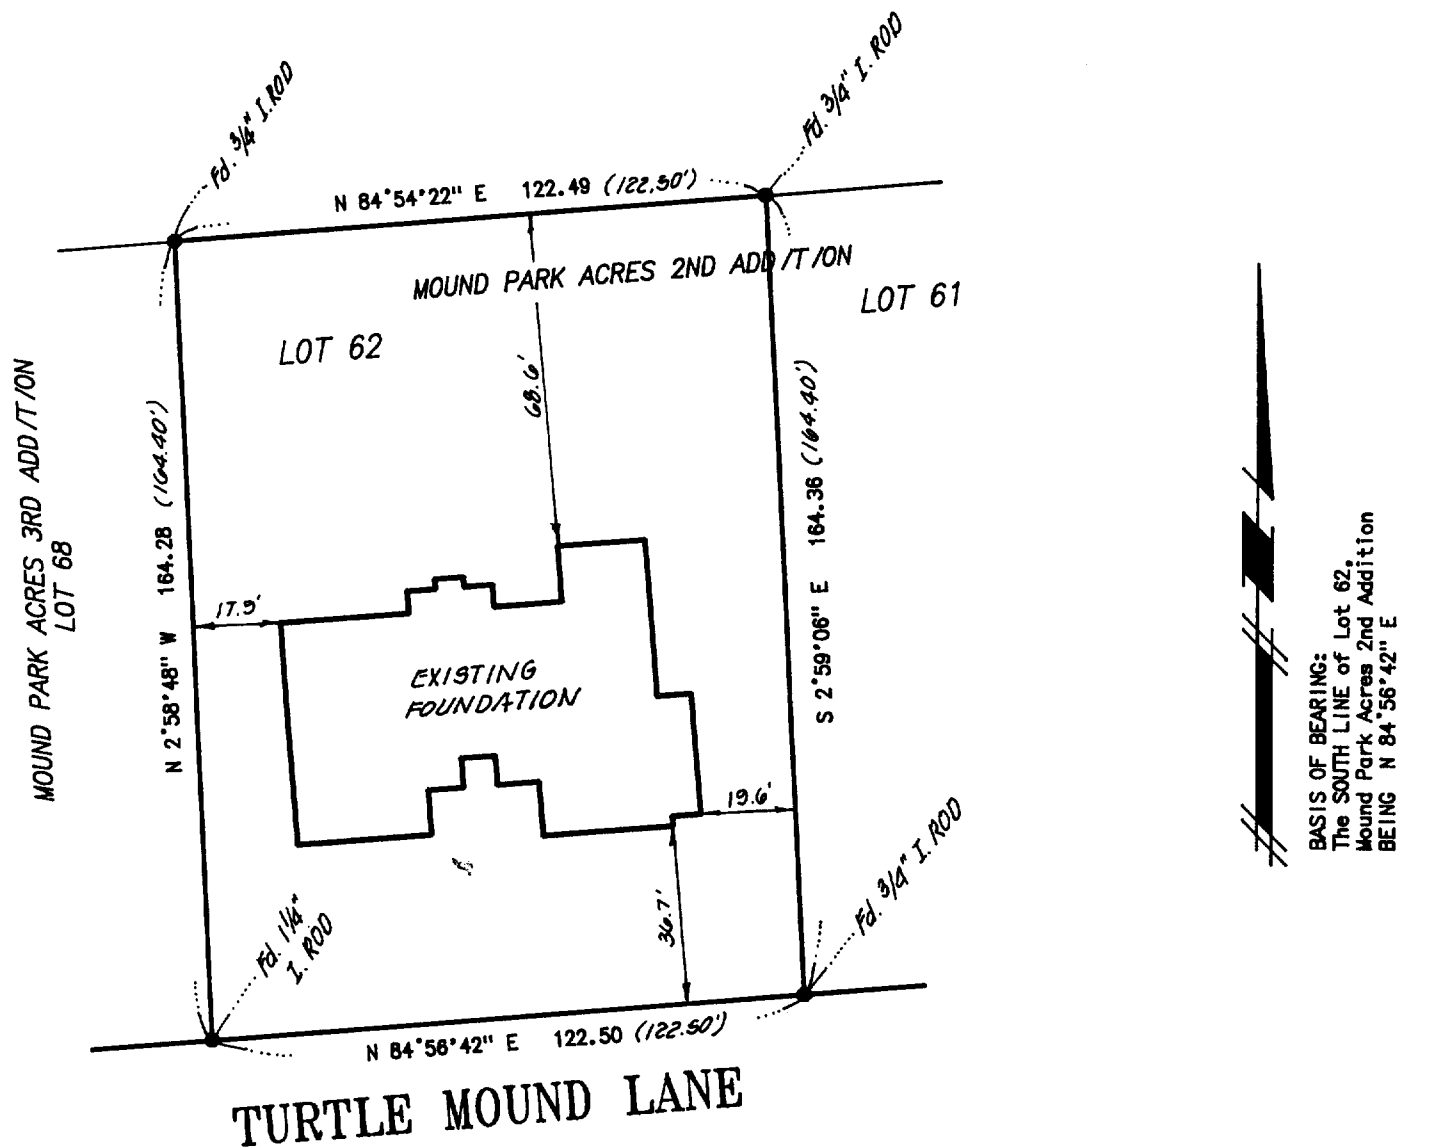

/M02-7
10-570

JAMES K. LANGONE
LAND SURVEYS & CIVIL ENGINEERING

N339 Co. Rd. "N" (Upper)

Whitewater, WI. 53190-2842

(414) 473-4119

JN:96-100