


LEGAL DESCRIPTION


THE SOUTH 9 RODS OF THE FOLLOWING DESCRIBED PARCELS;
OUTLOT 9 AND THE EAST 6 RODS OF OUTLOT 8, BLK 4,
S.C. HALL'S ADDITION TO THE VILLAGE (NOW CITY)
OF WHITEWATER, WALWORTH COUNTY, WISCONSIN.

PLAT OF SURVEY

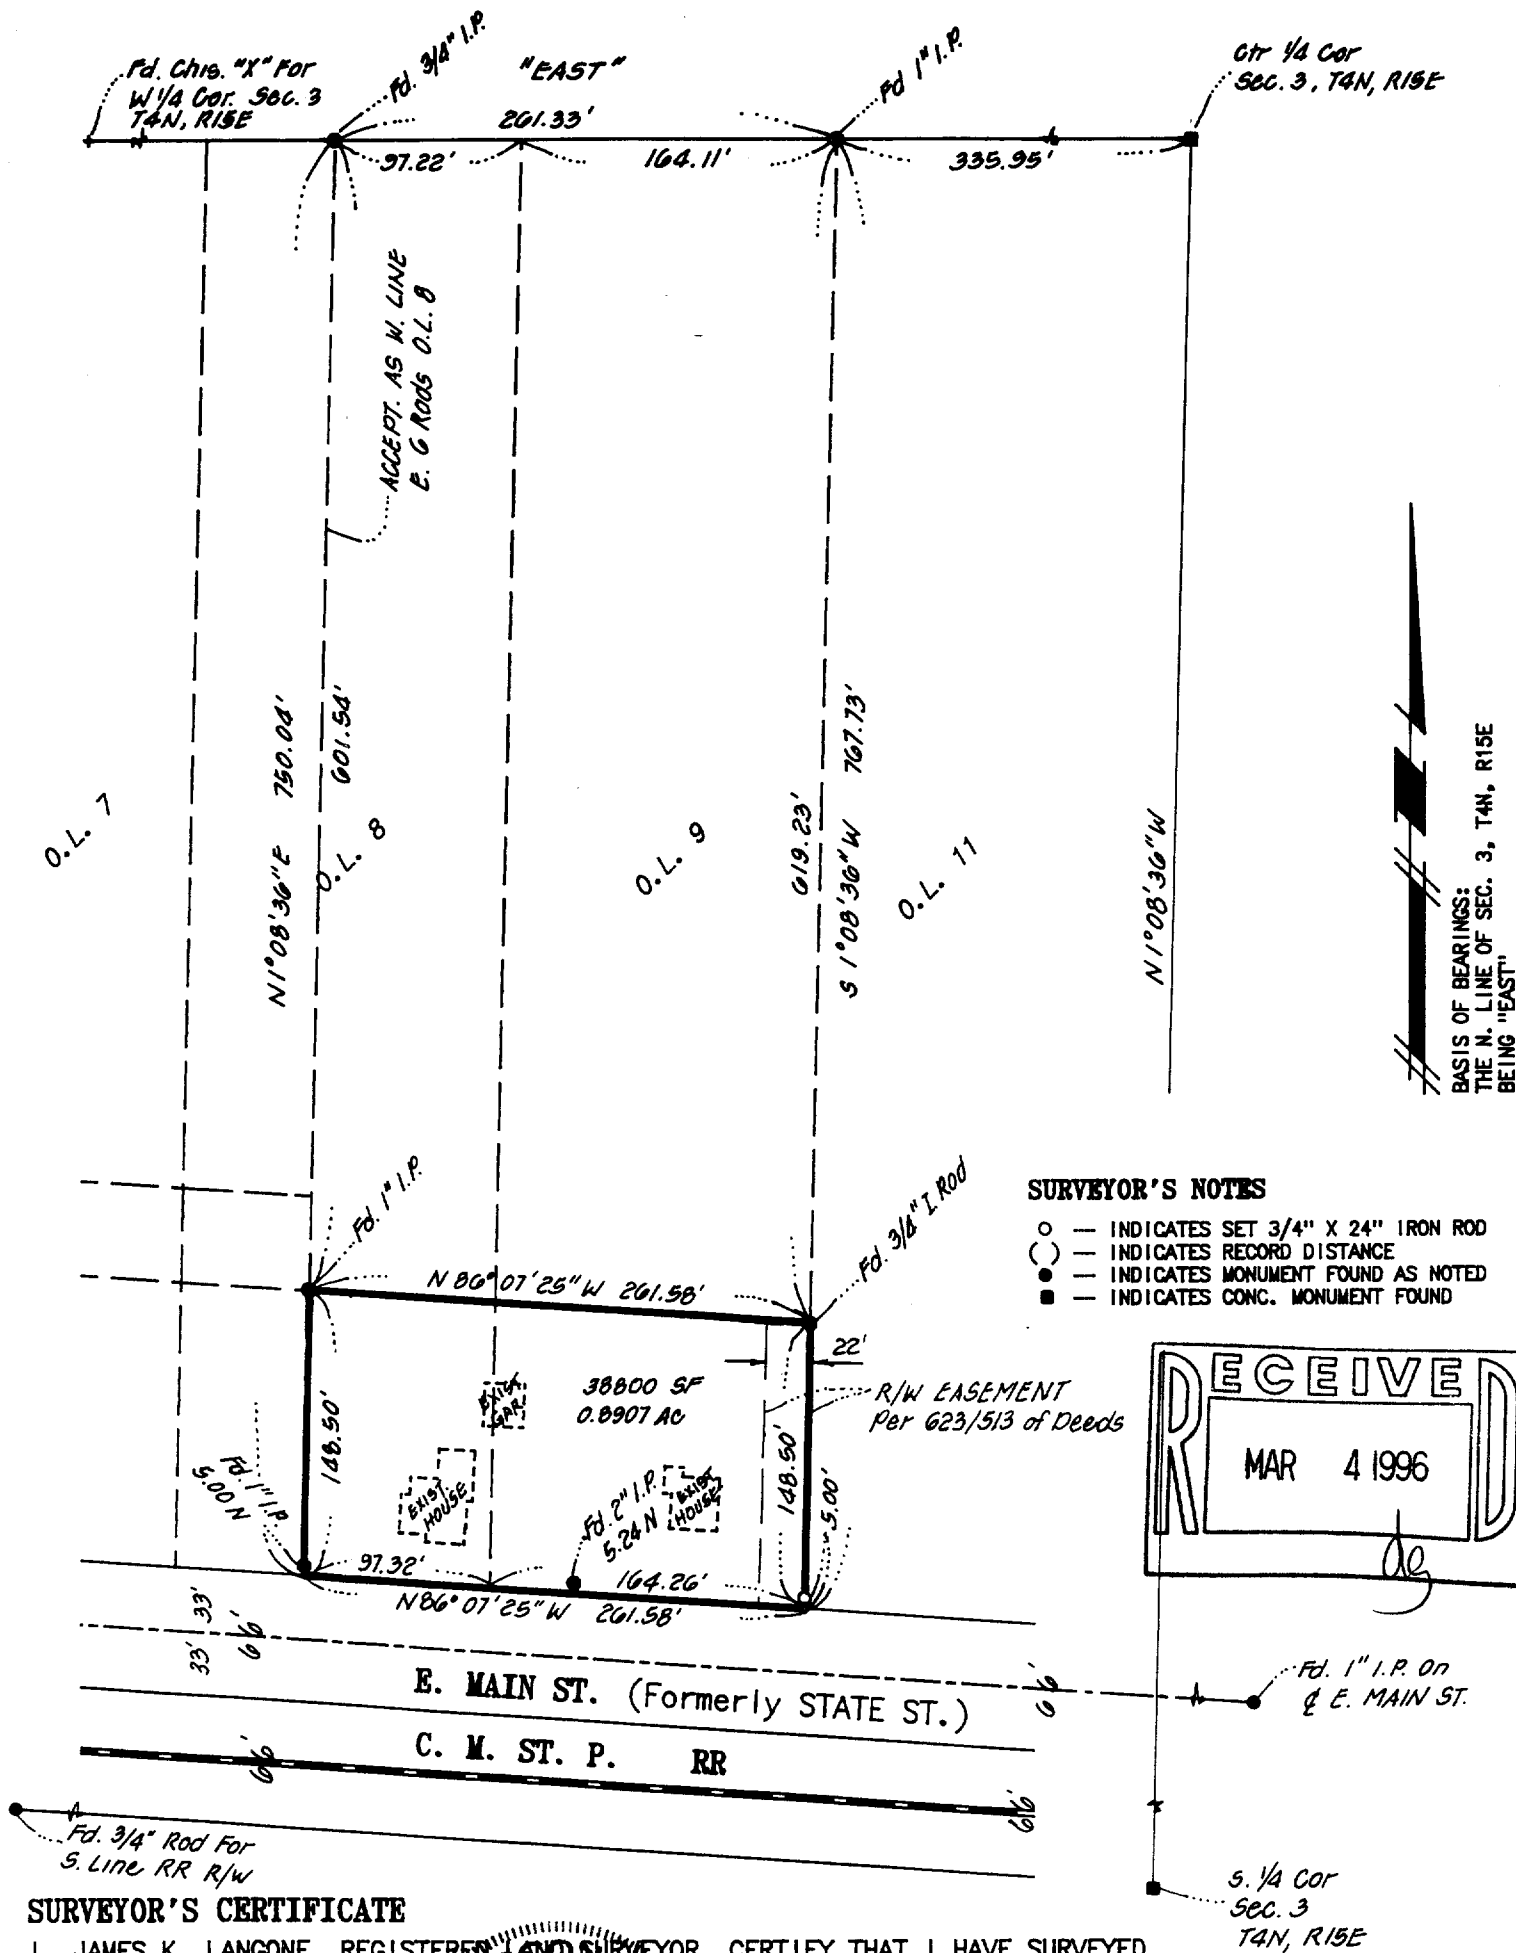

SURVEYOR'S NOTES

- — INDICATES SET 3/4" X 24" IRON ROD
- () — INDICATES RECORD DISTANCE
- — INDICATES MONUMENT FOUND AS NOTED
- — INDICATES CONC. MONUMENT FOUND

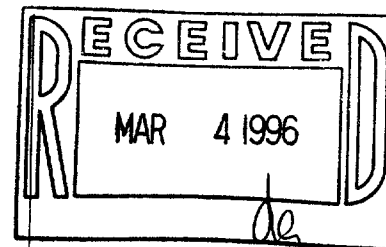

SURVEYOR'S CERTIFICATE

I, JAMES K. LANGONE, REGISTERED LAND SURVEYOR, CERTIFY THAT I HAVE SURVEYED THE PROPERTY DESCRIBED, AND THAT THE PLAT SHOWN HEREON IS A CORRECT REPRESENTATION OF THE BOUNDARIES THEREOF.

DATE: 3/1/96

JAMES K. LANGONE
 REG. LAND SURVEYOR, S-1347



/Has-29A

JAMES K. LANGONE

LAND SURVEYS & CIVIL ENGINEERING

N339 Co. Rd. "N" (Upper)

Whitewater, WI. 53190-2842

(414) 473-4119

JN: 96-106

010-581