


NORTH 1/4 CORNER
SECTION 4-4-15
CONCRETE MONUMENT —
FOUND LEANING SOUTH.
ESTABLISHED CORNER
FROM TIES.

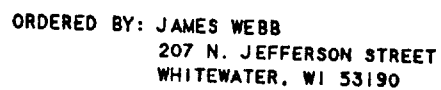

LOT 2, BLOCK 4, WILSON'S ADDITION TO THE CITY
OF WHITEWATER, WALWORTH COUNTY, WISCONSIN.

David F. Abell
DAVID F. ABELL
WISCONSIN REGISTERED LAND SURVEYOR, S-1596

DATE _____ JOB NUMBER - 96010
NOTE: THIS IS NOT A CERTIFIED COPY UNLESS SEALED.

- Ø -IRON PIPE FOUND
- Ø -PK NAIL FOUND
- -CONCRETE MONUMENT FOUND
- -IRON ROD SET
- *——* -WIRE FENCE
- CS -CONCRETE STOOP
- BE -BASEMENT ENTRY

WSS-24

010-586