



PLAT OF SURVEY

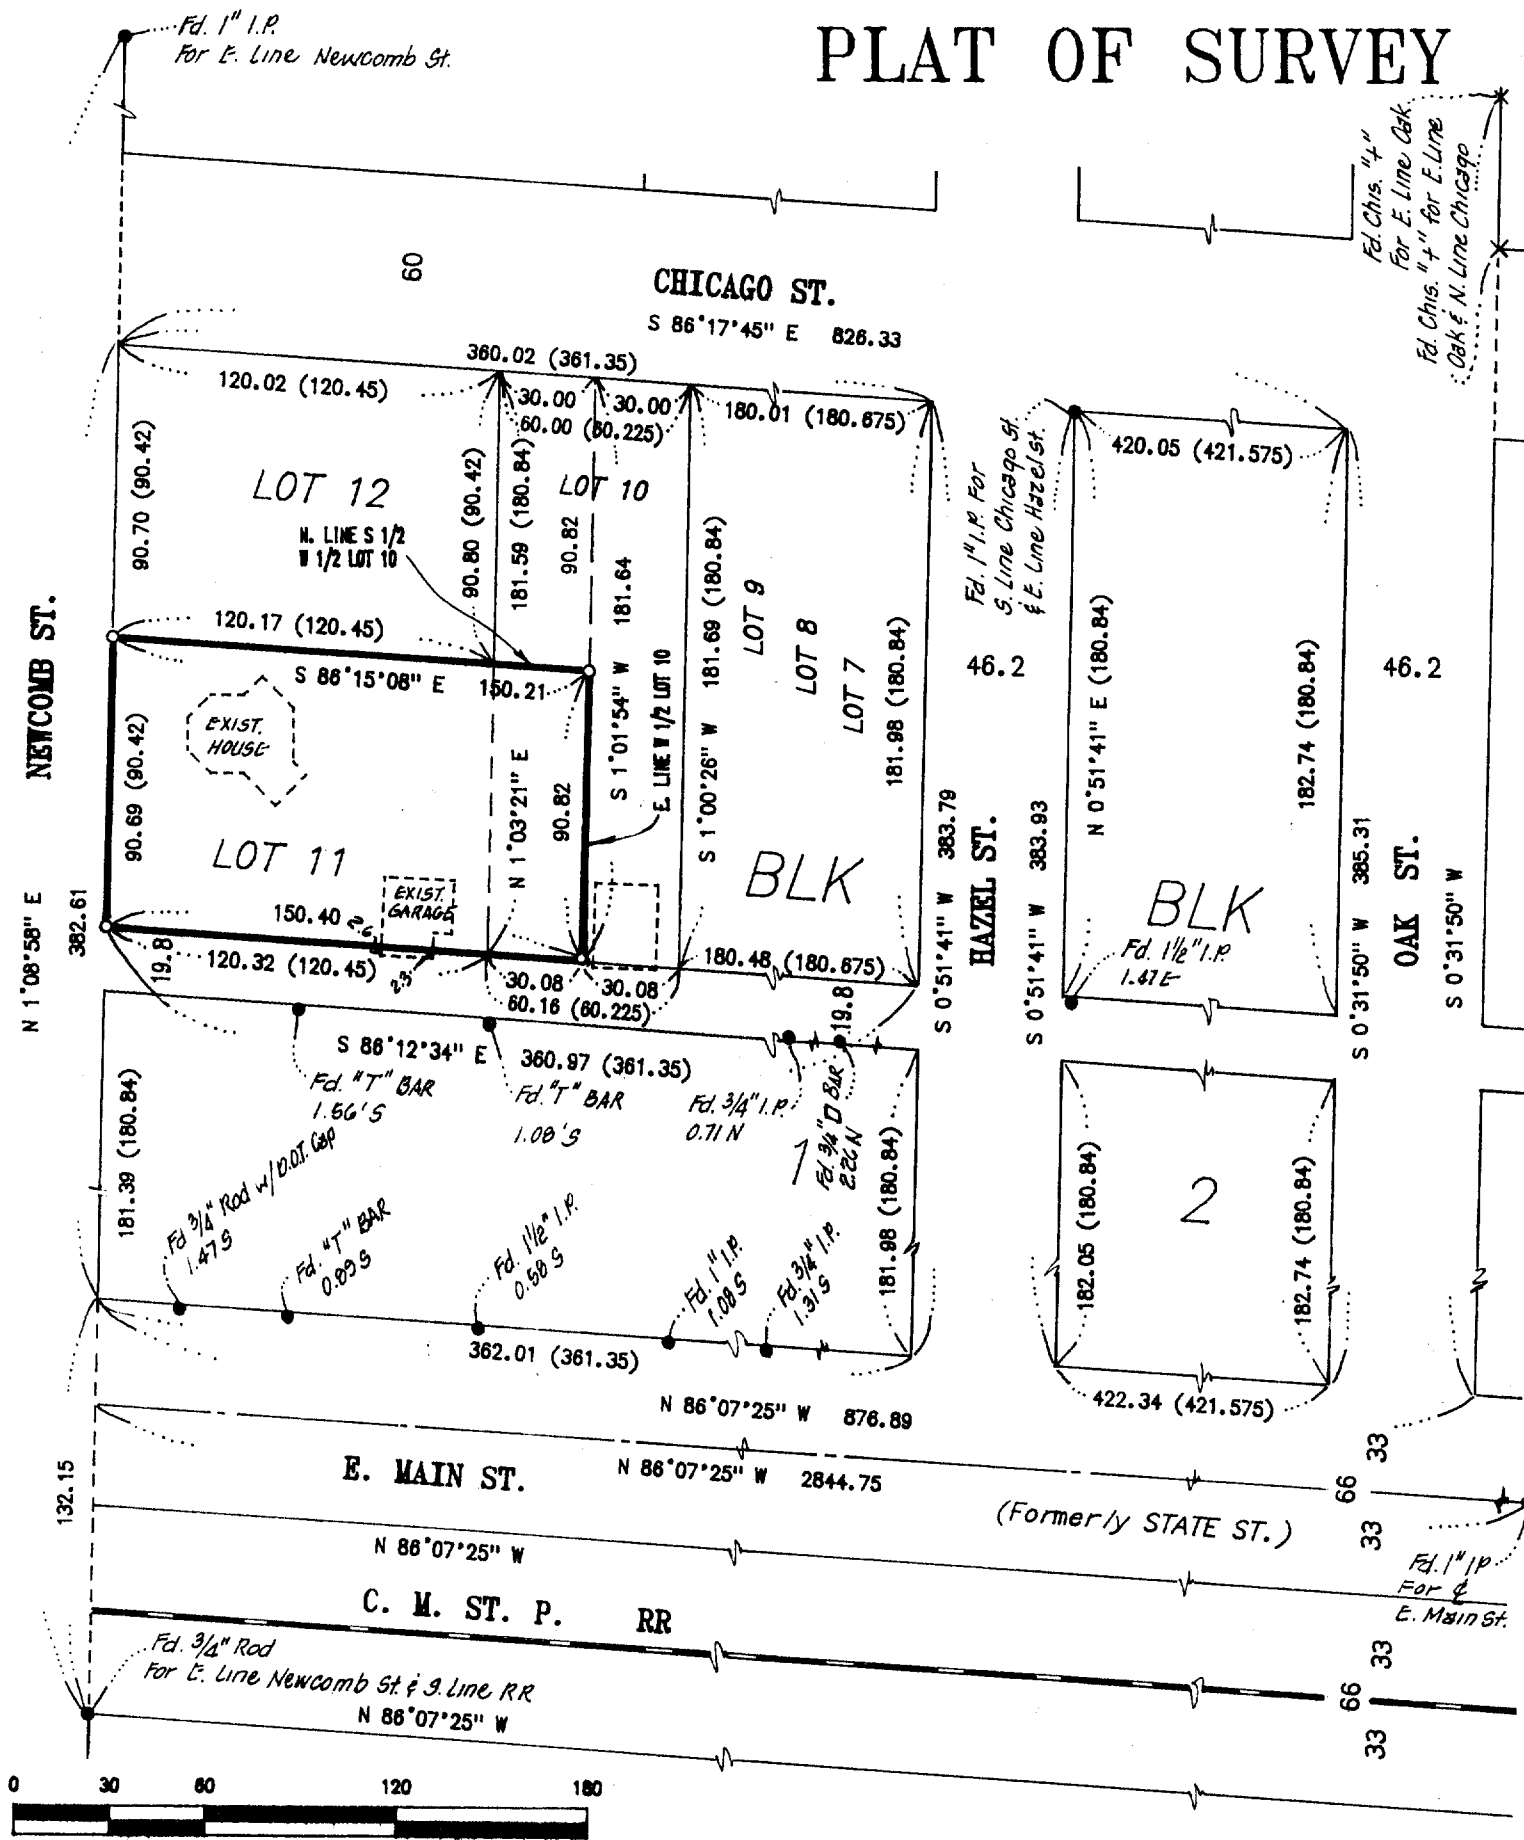

NOTES:

- INDICATES MNT. FD. AS NOTED
- () — INDICATES SET 3/4" IRON ROD
- () — INDICATES RECORDED DISTANCE

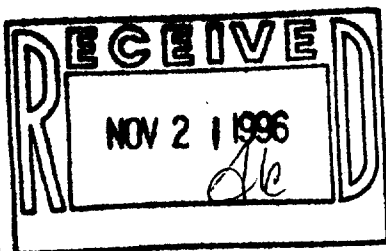

SURVEYOR'S CERTIFICATE

I, JAMES K. LANGONE, REGISTERED LAND SURVEYOR, CERTIFY THAT I HAVE SURVEYED THE PROPERTY DESCRIBED ABOVE AND THAT THE PLAT SHOWN HEREON IS A CORRECT REPRESENTATION OF THE BOUNDARIES THEREOF.

DATE: 11/21/96

JAMES K. LANGONE
S-1347
REGISTERED LAND SURVEYOR, S-1347

LEGAL DESCRIPTION:

LOCATED IN THE SW 1/4, SEC. 3, T4N, R15E, IN THE CITY OF WHITWATER, WALWORTH COUNTY, WI.

LOT 11 AND THE S 1/2 OF THE W 1/2 OF LOT 10, BLOCK 1, S.C. HALL'S ADDITION TO THE VILLAGE OF WHITWATER

JAMES K. LANGONE

LAND SURVEYS & CIVIL ENGINEERING

N339 Co. Rd. "N" (Upper)

Whitwater, WI. 53190-2842

(414) 473-4119

JN:96-130

010-587

BASIS OF BEARINGS:
THE E. LINE OF NEWCOMB ST.
BEING N 1°08'58" E

/HAS-9