

PLAT OF SURVEY

SURVEYOR'S CERTIFICATE

I, JAMES K. LANGONE, REGISTERED LAND SURVEYOR, CERTIFY THAT I HAVE SURVEYED THE PROPERTIES DESCRIBED HEREON AND THAT THE PLAT SHOWN HEREON IS A CORRECT REPRESENTATION OF THE BOUNDARIES THEREOF.


DATE: 3/26/97

JAMES K. LANGONE
S-1347
REGISTERED LAND SURVEYOR, S-1347

LEGAL DESCRIPTIONS:



IN THE SE 1/4, SEC. 4, T4N, R15E
IN THE CITY OF WHITEWATER, WALWORTH COUNTY, WISCONSIN

LOT 6, BLK 4, ESTERLY'S ADDITION
LOT 1, BLK 4, ESTERLY'S ADDITION

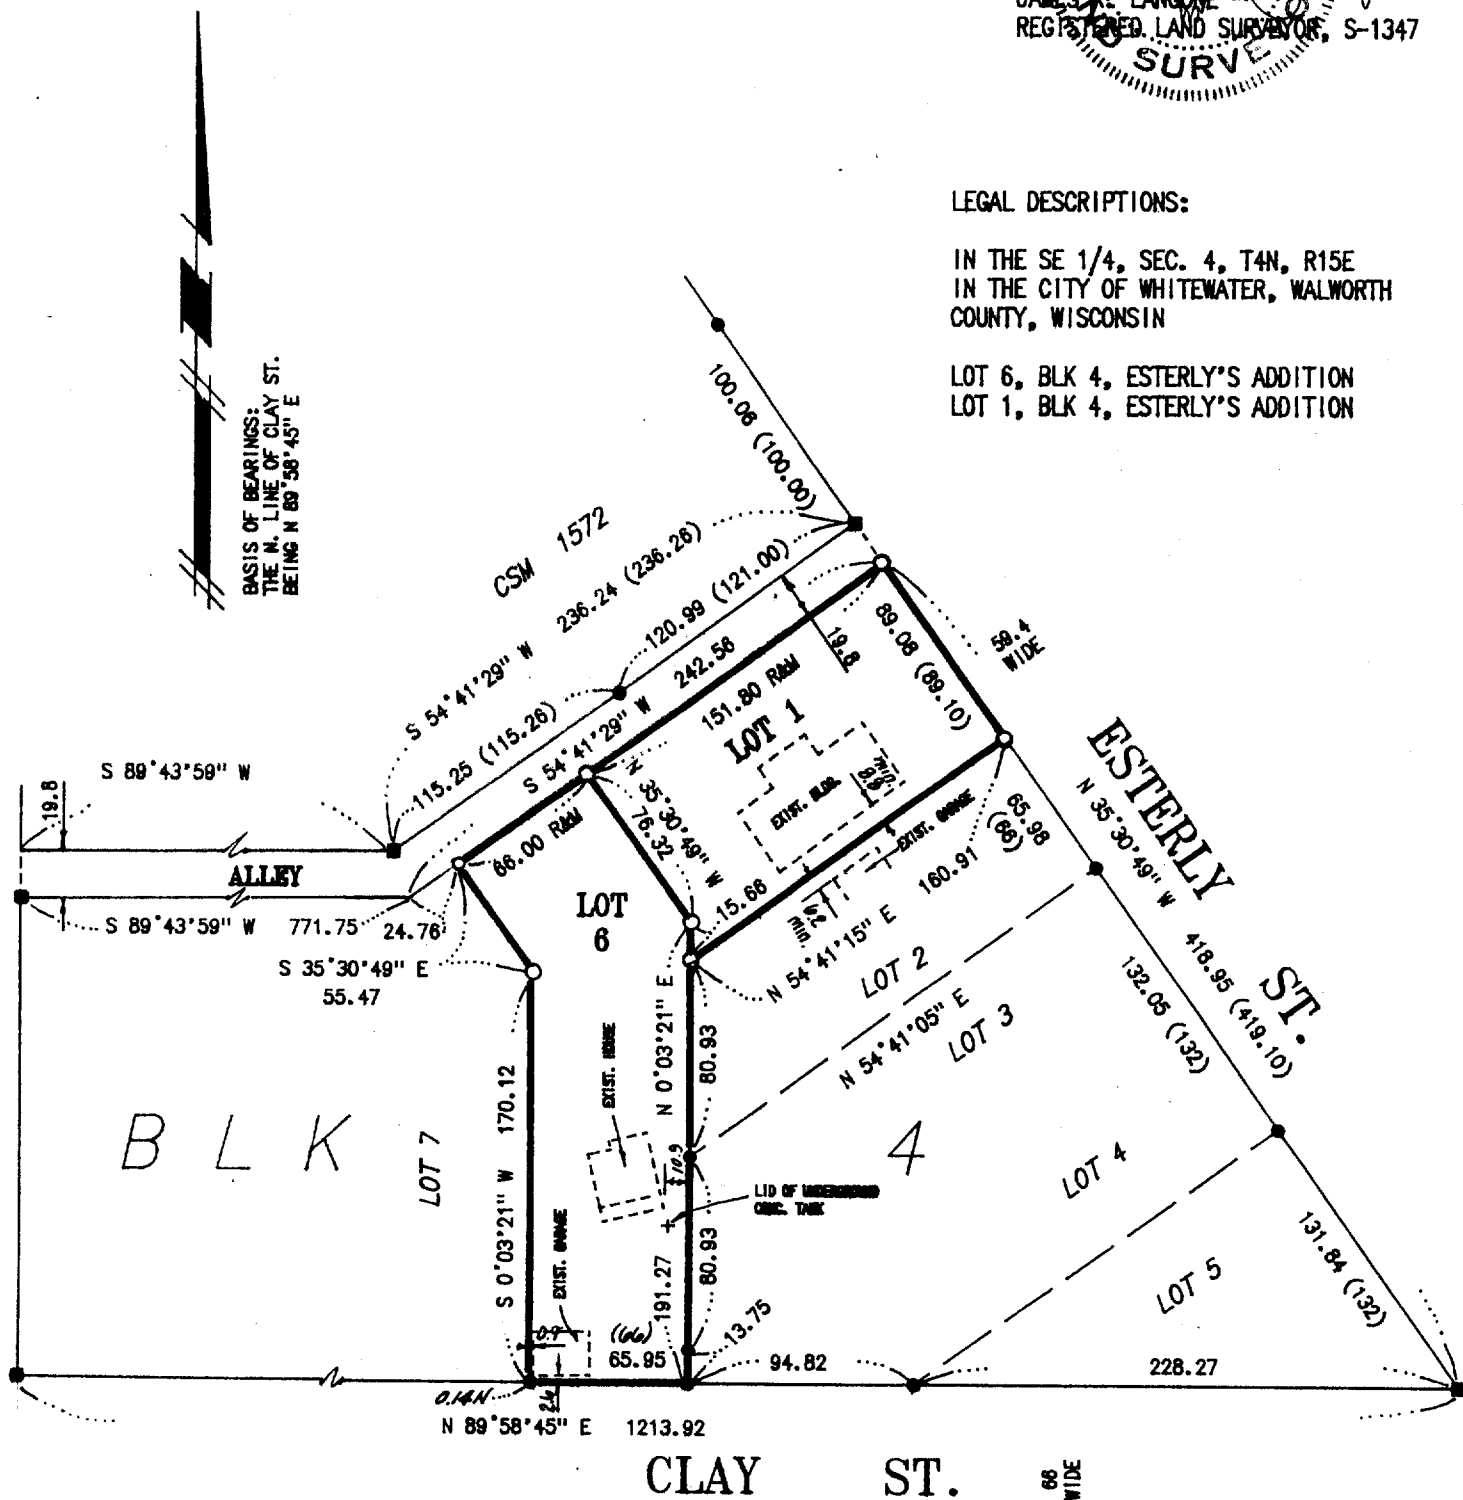

NOTES:

- o — Indicates SET 3/4" x 24" Iron Rod
- () — Indicates Record Distance
- — Indicates Found 1" I.P. unless otherwise noted
- — Indicates Conc. Monument Found
- R&M — Indicates Distance Record & Measured

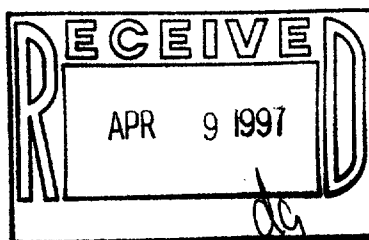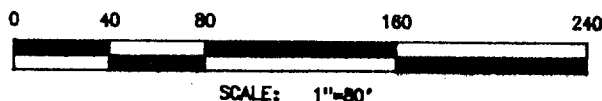

SHEET 1 OF 1

4/22/97

ES-18

ES-22 10-597

JAMES K. LANGONE

LAND SURVEYS & CIVIL ENGINEERING

N339 Co. Rd. "N" (Upper)

Whitewater, WI. 53190-2842

(414) 473-4119

JN: 97-111