


PLAT OF SURVEY

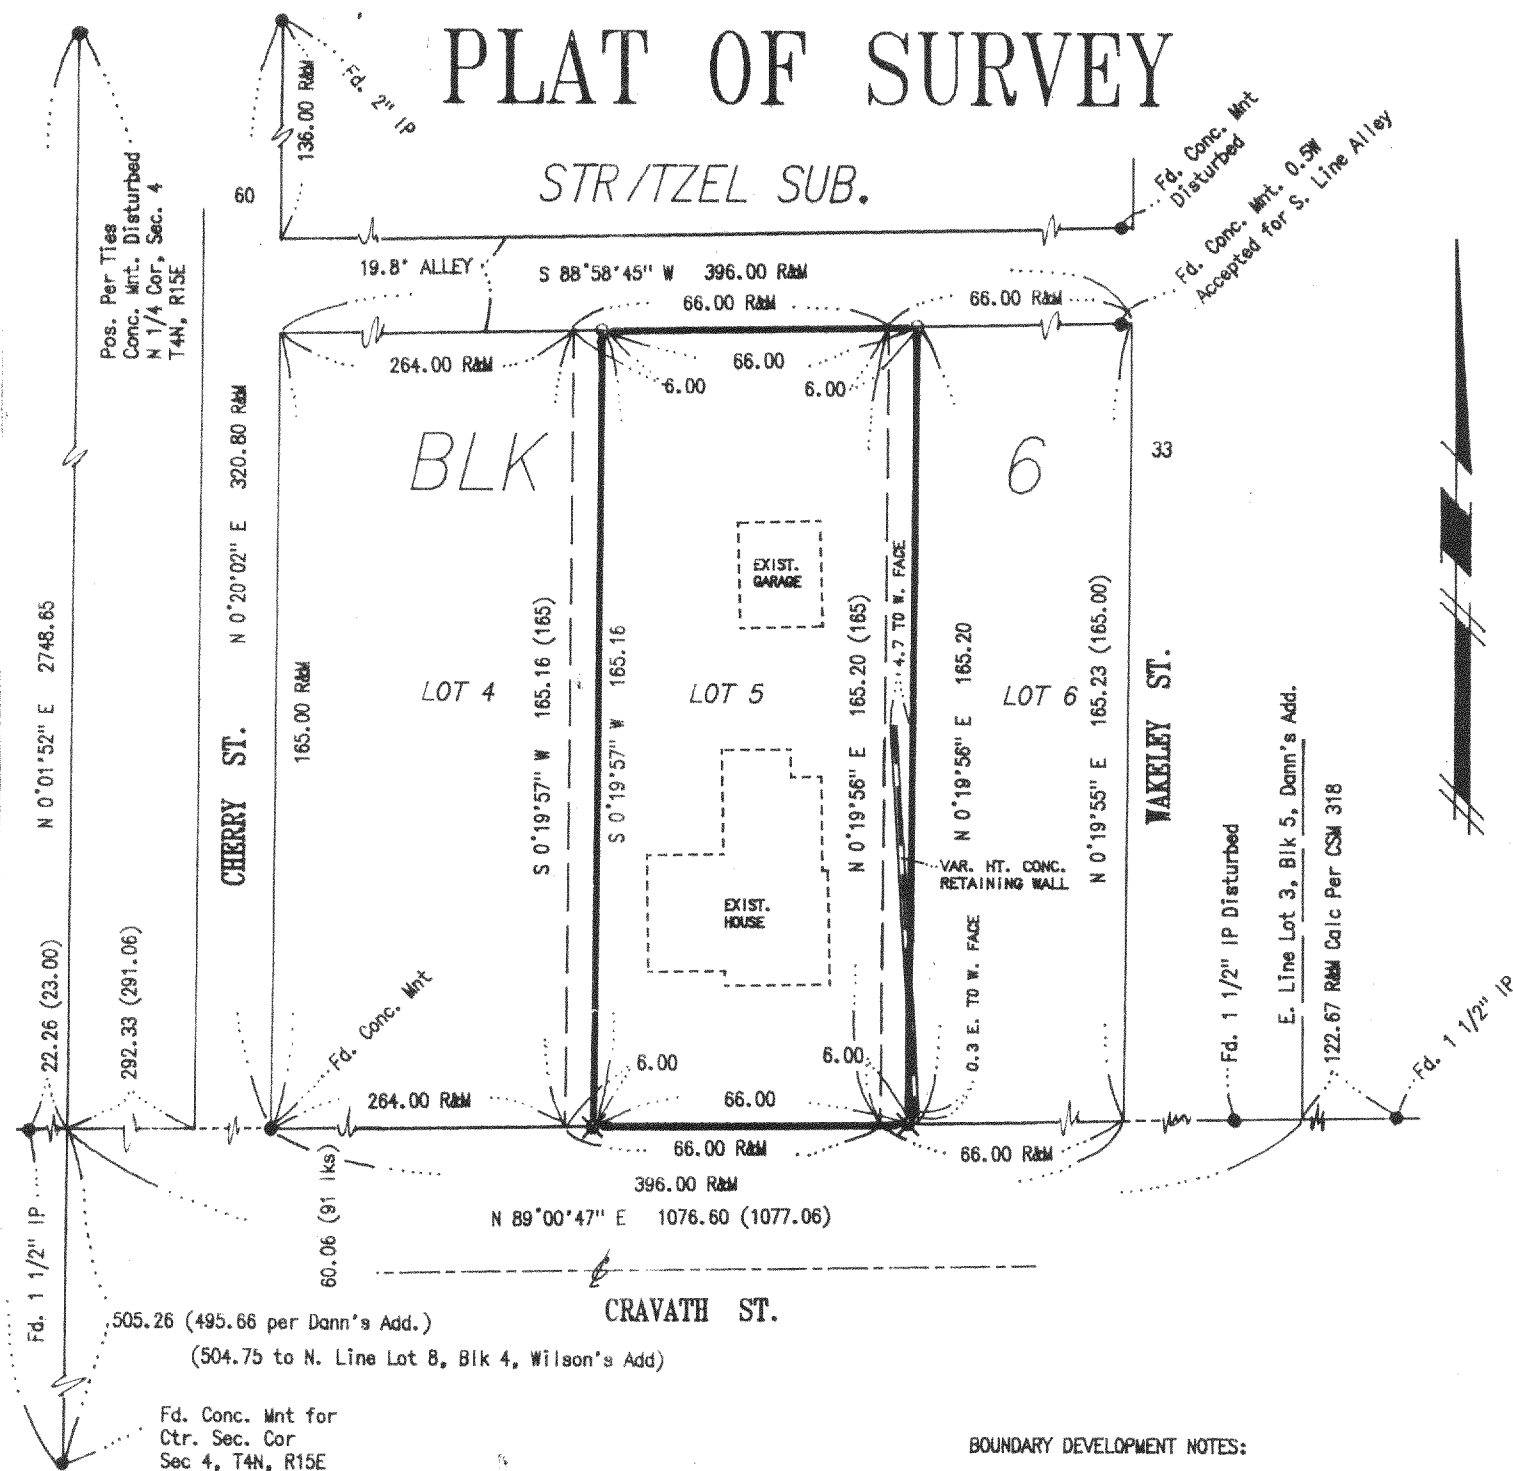

SURVEYOR'S CERTIFICATE

I, JAMES K. LANGONE, REGISTERED LAND SURVEYOR, CERTIFY THAT I HAVE SURVEYED THE PROPERTY DESCRIBED BELOW AND THAT THE PLAT SHOWN HEREON IS A CORRECT REPRESENTATION OF THE BOUNDARIES THEREOF.

DATE: 6/11/97

JAMES K. LANGONE
REGISTERED LAND SURVEYOR, S-1347


LEGAL DESCRIPTION:

IN THE NE 1/4, SEC. 4, T4N, R15E, IN THE CITY OF
WHITEWATER, WALWORTH COUNTY, WISCONSIN

THE E. 60 FEET OF LOT 5, BLK. 6, AND THE W. 6 FEET OF LOT 6, BLK. 6, OF DANN'S ADDITION.


BOUNDARY DEVELOPMENT NOTES:

1. BLOCK 6: Found Monumentation was accepted due to previous acceptance per existing platting, however N/S positions do not reasonably conform to positions (relative to E/W Ctr. 1/4 Line) as shown on "DANN'S ADD.". E/W positions appear to have been based on record dimensions from an undisclosed alternate location for the N/S Ctr. 1/4 Line, with the exception of Monumentation set for CSM 318.
2. METHOD: Fd. Monumentation was held for N/S position.
RECORD Distances (per DANN'S ADD.) were held from the E. Line of Cherry St., as monumented, for E/W positions.

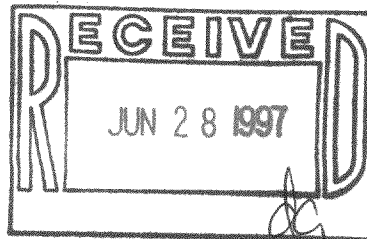

NOTES:

- () — Indicates Record Distance
 () — Indicates Dist. Record & Measured
 ● — Indicates Mnt. FD. as Noted
 ○ — Indicates SET 3/4" Rod
 ⊗ — Indicates SET Drill Hole w/ Nail & Brass Tag

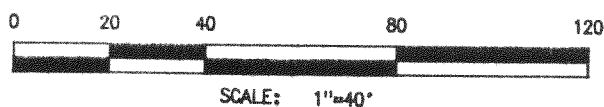

JAMES K. LANGONE
LAND SURVEYS & CIVIL ENGINEERING

N339 Co. Rd. "N" (Upper)

Whitewater, WI. 53190-2842

(414) 473-4119

JN: 97-117

6/10/97

10-604
/DA-32