


PLAT OF SURVEY

NOTES:

- () -- Indicates Record Distance
- -- Indicates Mnt. FD. as Noted
- o -- Indicates SET 3/4" Iron Rod

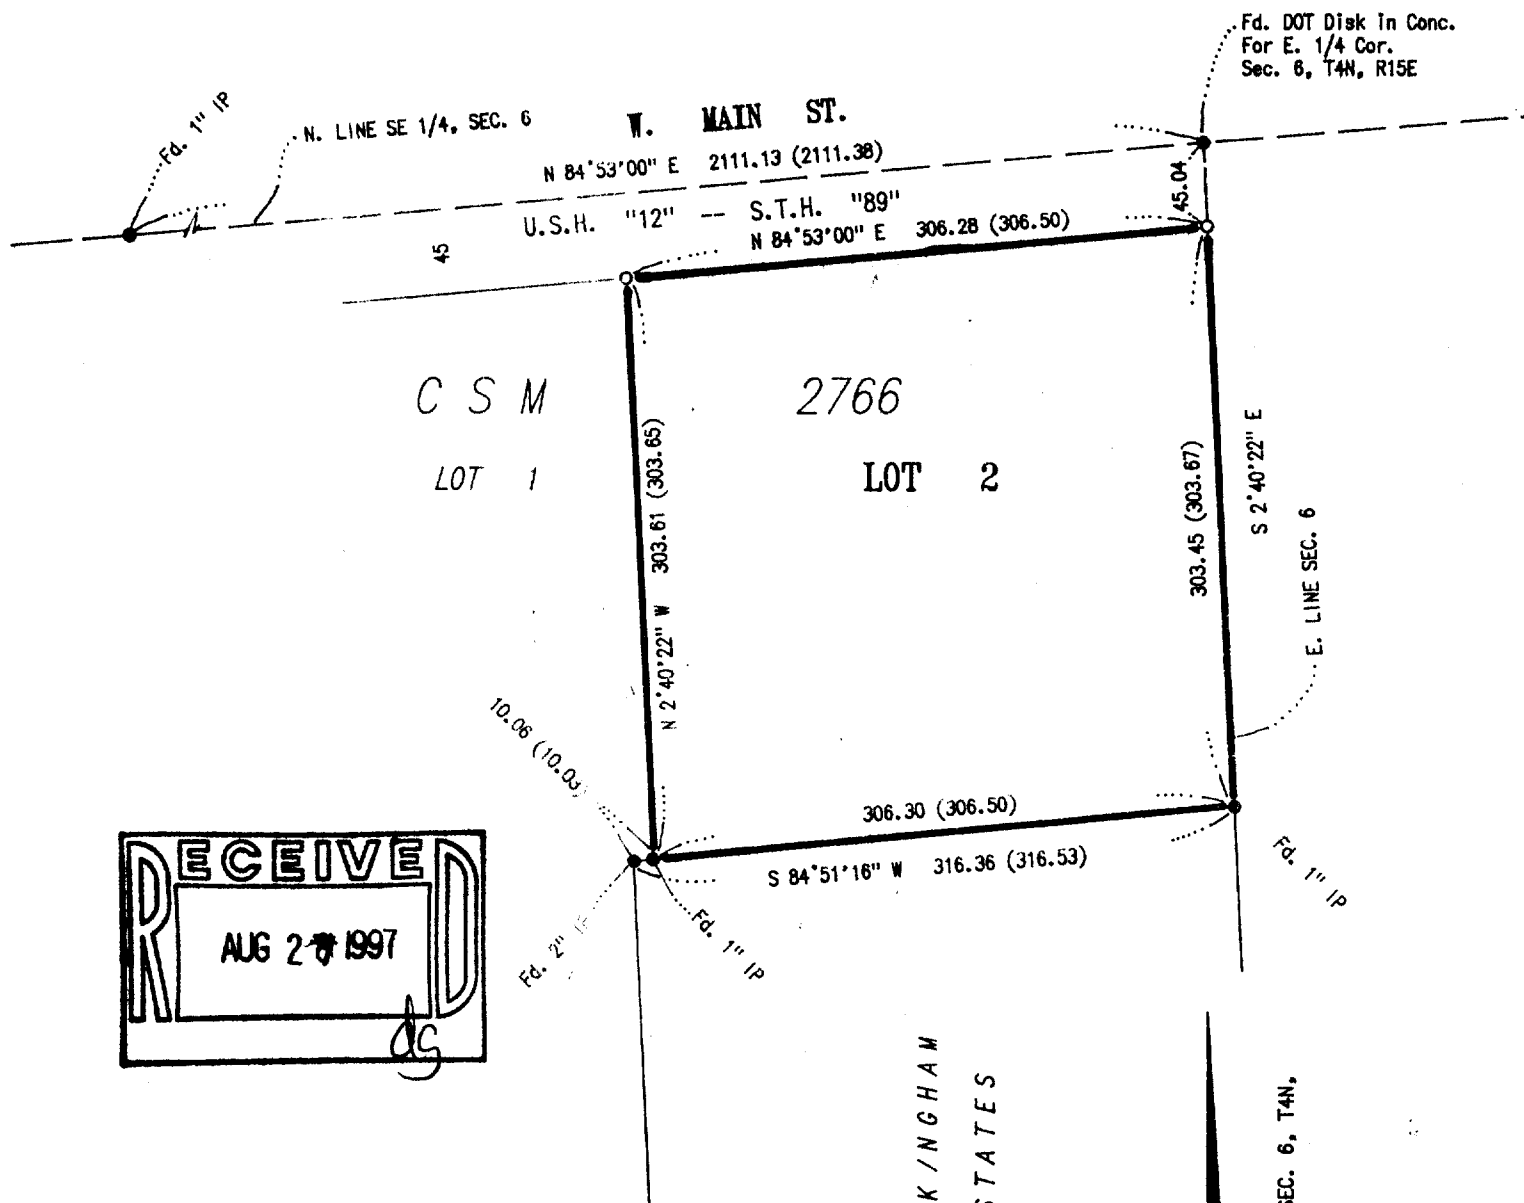

SURVEYOR'S CERTIFICATE

I, JAMES K. LANGONE, REGISTERED LAND SURVEYOR, CERTIFY THAT I HAVE SURVEYED THE PROPERTY DESCRIBED HEREON, AND THAT THE PLAT SHOWN HEREON IS A CORRECT REPRESENTATION OF THE BOUNDARIES THEREOF.

DATE: 8/29/97

JAMES K. LANGONE
 981347
 WHITEWATER
 JAMES K. LANGONE
 REGISTERED LAND SURVEYOR, S-1347

BASIS OF BEARINGS:
 THE NORTH LINE OF THE SE 1/4, SEC. 6, T4N,
 R15E
 BEING N 84°53'00" E

LEGAL DESCRIPTION:

IN THE NE 1/4, SEC. 6, T4N, R15E, IN THE CITY OF
 WHITEWATER, WALWORTH CO., WISCONSIN

LOT 2, CERTIFIED SURVEY MAP NO. 2766



8/21/97

JN: 97-134

JAMES K. LANGONE

LAND SURVEYS & CIVIL ENGINEERING

N339 Co. Rd. "N" (Upper)

Whitewater, WI. 53190-2842

(414) 473-4119

1A-2766-2
 010-606