



PROKOP'S SURVEYING

Service with Quality
1101 Saraloga Parkway, Oconomowoc, WI 53066

PLAT OF SURVEY



LEGAL DESCRIPTION: The center 1/3 of Lot 7, Block 3, Corydon Pratt's Addition, City of Whitewater, Walworth County, Wisconsin.

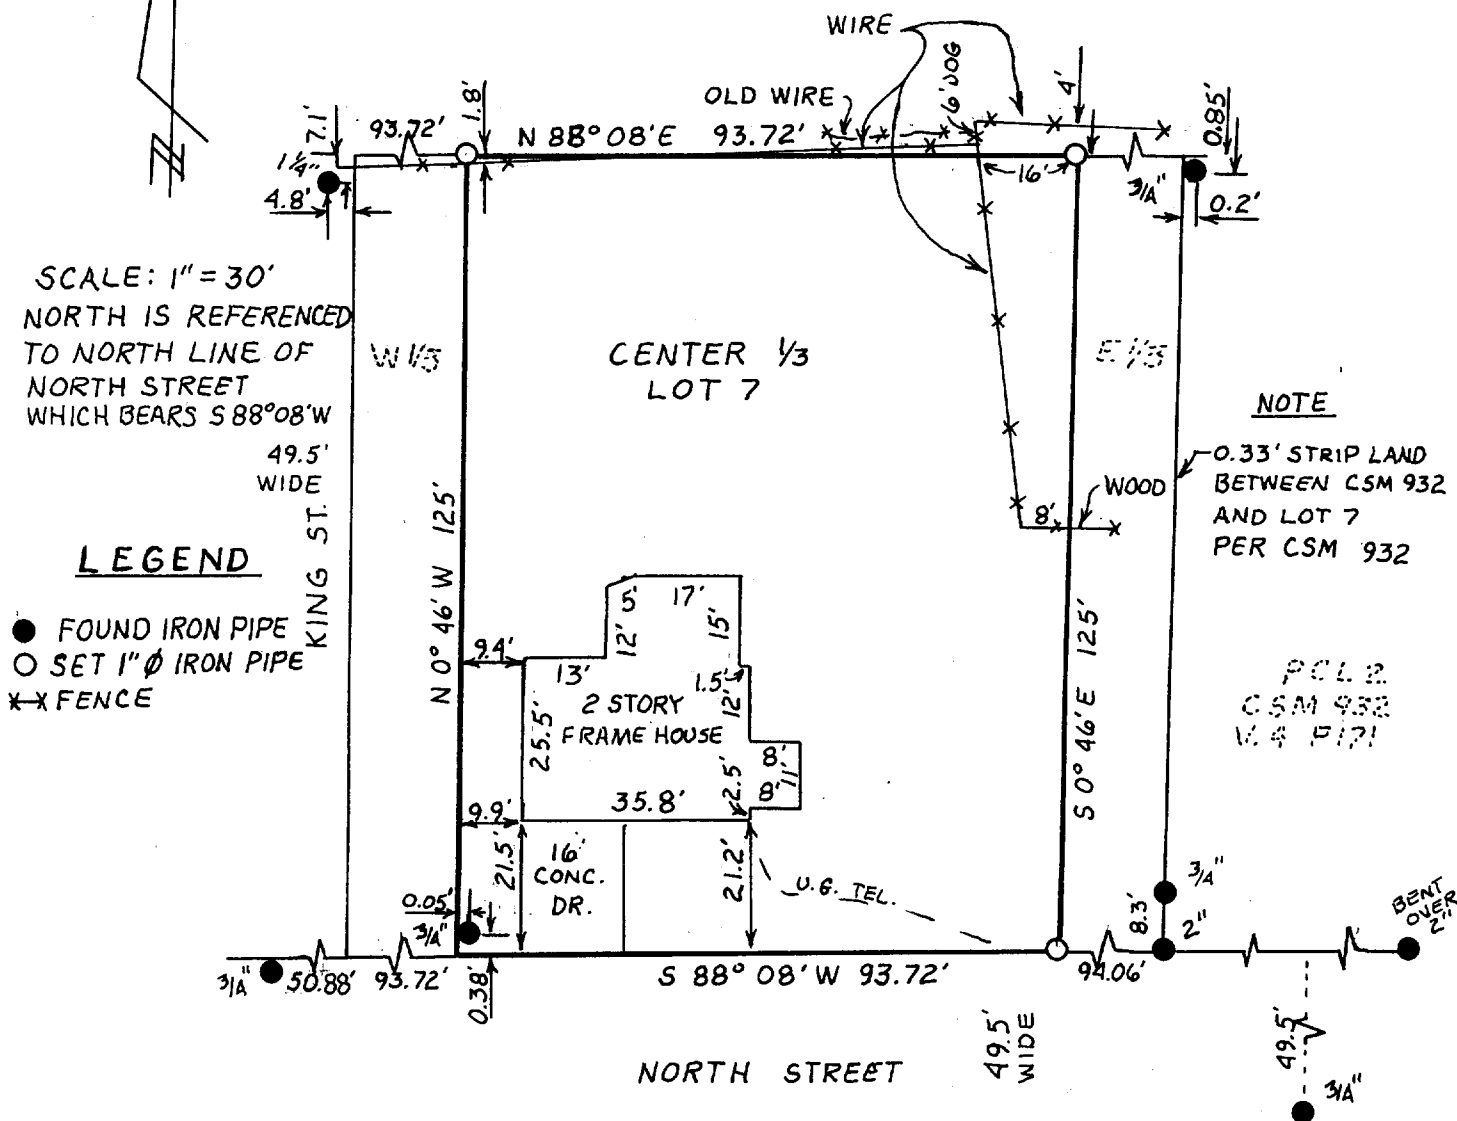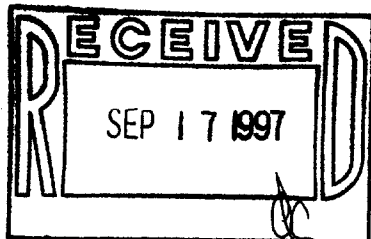

CLIENT
Michael O'Connor
842 E. North St.
Whitewater, WI 53190


DATE: 5/30/1997
Job: 97001
Sheet 1 of 1

I have surveyed the above described property, and the above map is a true representation thereof and shows the size and location of the property, its exterior boundaries, the location and dimensions of all visible structures thereon, fences, apparent easements, roadways and visible encroachments.

This survey is made for the exclusive use of the present owners of the property; also those who purchase, mortgage or guarantee the title thereto, within one year from date hereof, and to them I warrant the accuracy of said survey and map.

John M. Prokop

REGISTERED LAND SURVEYOR NO. 2-1635- STATE OF WISCONSIN

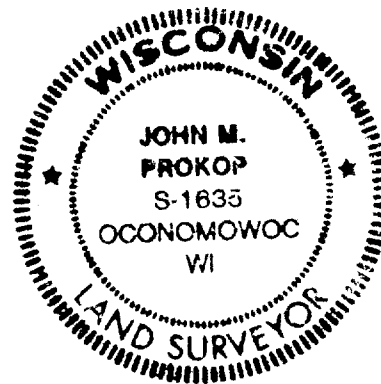

1/PC-24
010-607