
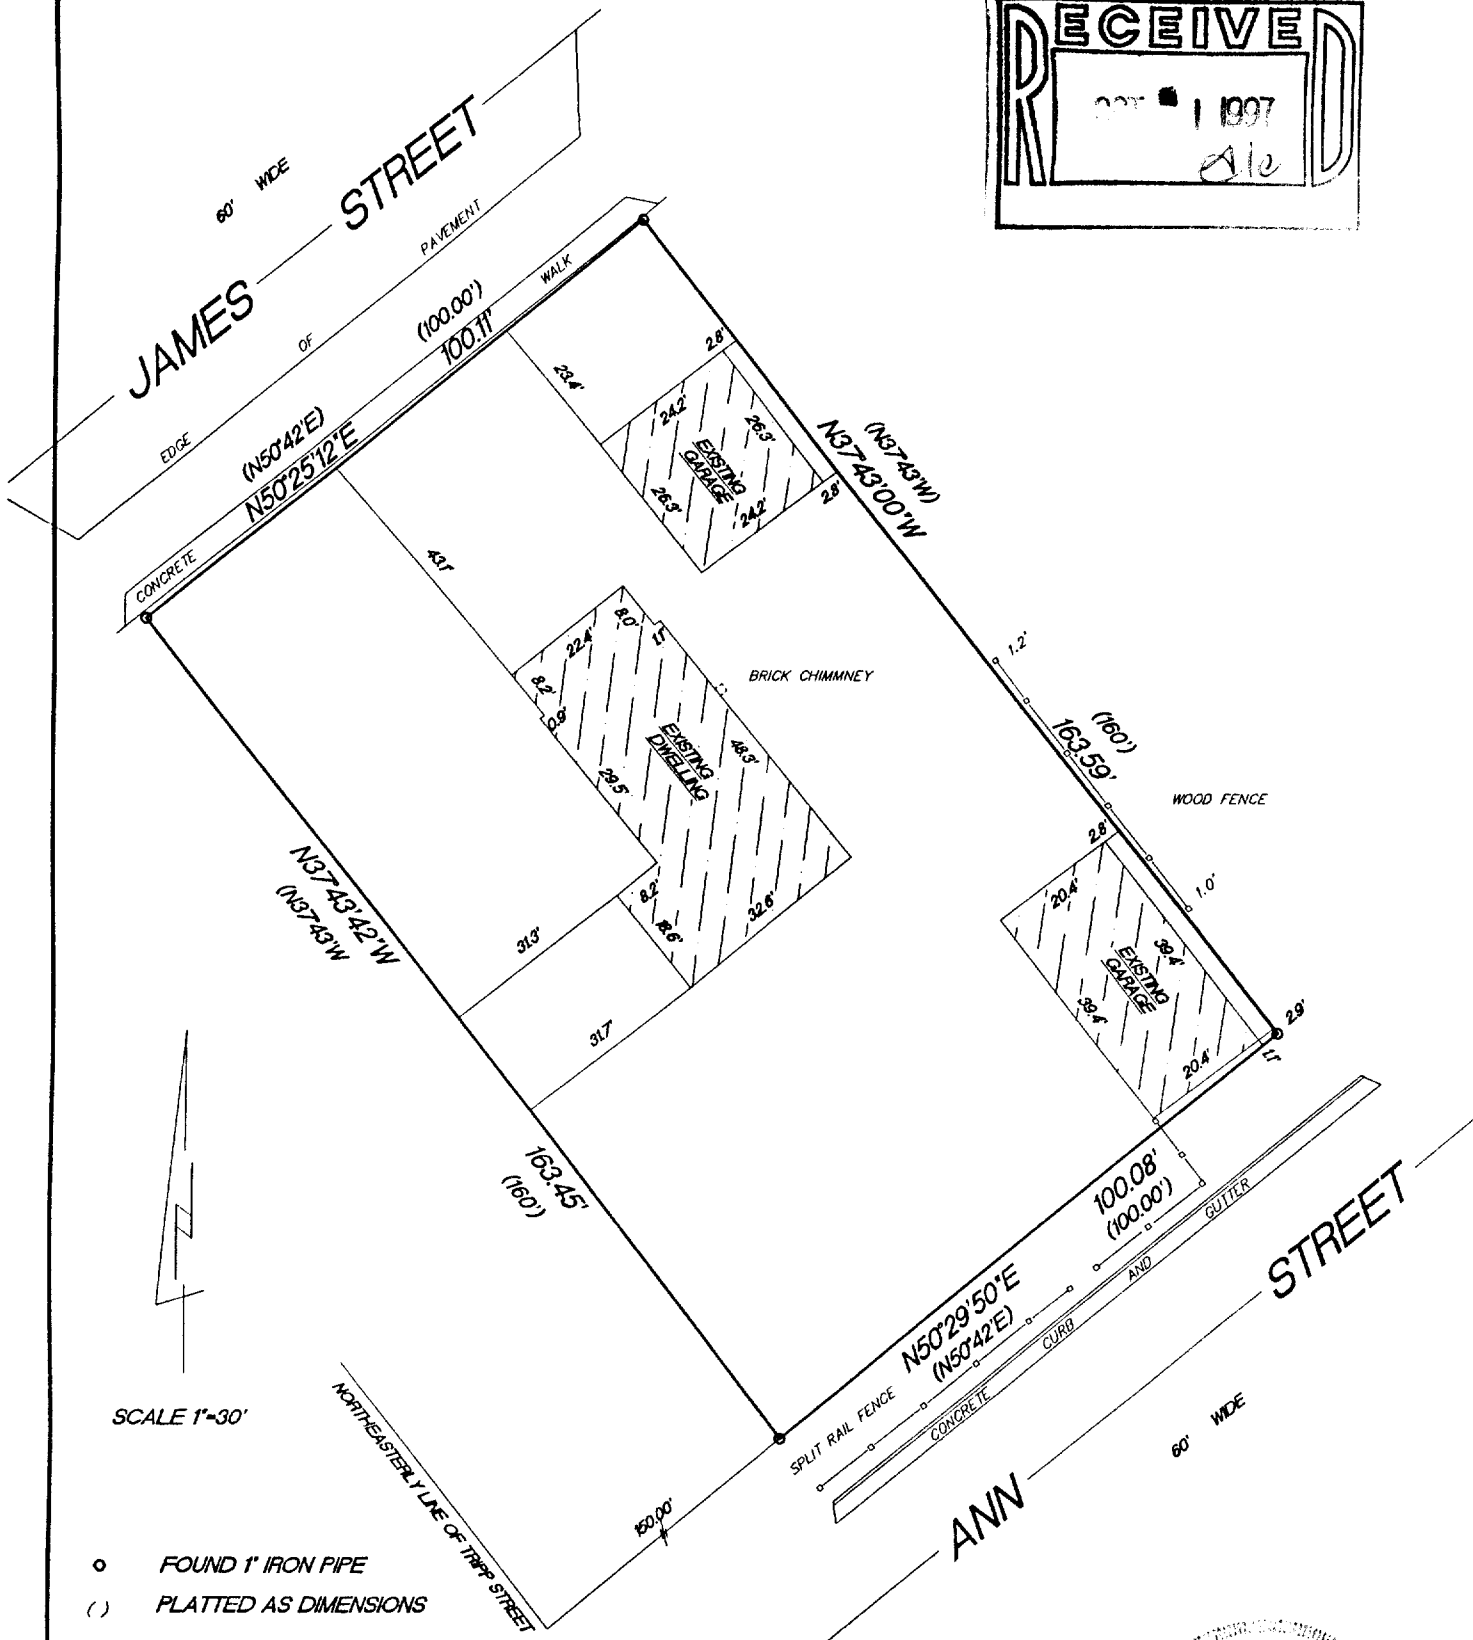


PLAT OF SURVEY

LOTS 14 AND 15, BLOCK 4, Tripp's Addition to the Village (now City) of Whitewater, Walworth County, Wisconsin.

Surveyed for: Bridget Wescott

Survey address: 370 W. Ann St.

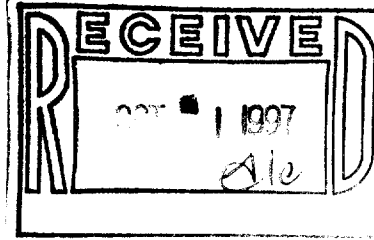


- FOUND 1" IRON PIPE
- () PLATTED AS DIMENSIONS

"I hereby certify that I have surveyed the above described property and that the above map is a true representation thereof and shows the size and location of the property, its exterior boundaries, the location of all visible structures and dimension of all principal buildings thereon, boundary fences, apparent easements, roadways and encroachments if any."

"This survey is made for the use of the present owners of the property, and also those who purchase, mortgage or guarantee the title thereto within one year from date hereof."



W362 S10227 Lewin Lane
Eagle, Wisconsin 53119
Terrance E. Pisarek R.L.S.

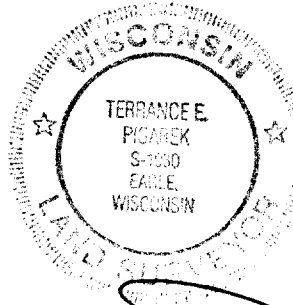

(414) 594-3484
fax (414) 594-5904

THIS IS NOT AN ORIGINAL SURVEY UNLESS THE SEAL IS RED.

9/11/97 DATE TEP/JPK FIELD WORK BY

JPK DRAWN BY 97187 JOB NUMBER

TR-28
10-608