


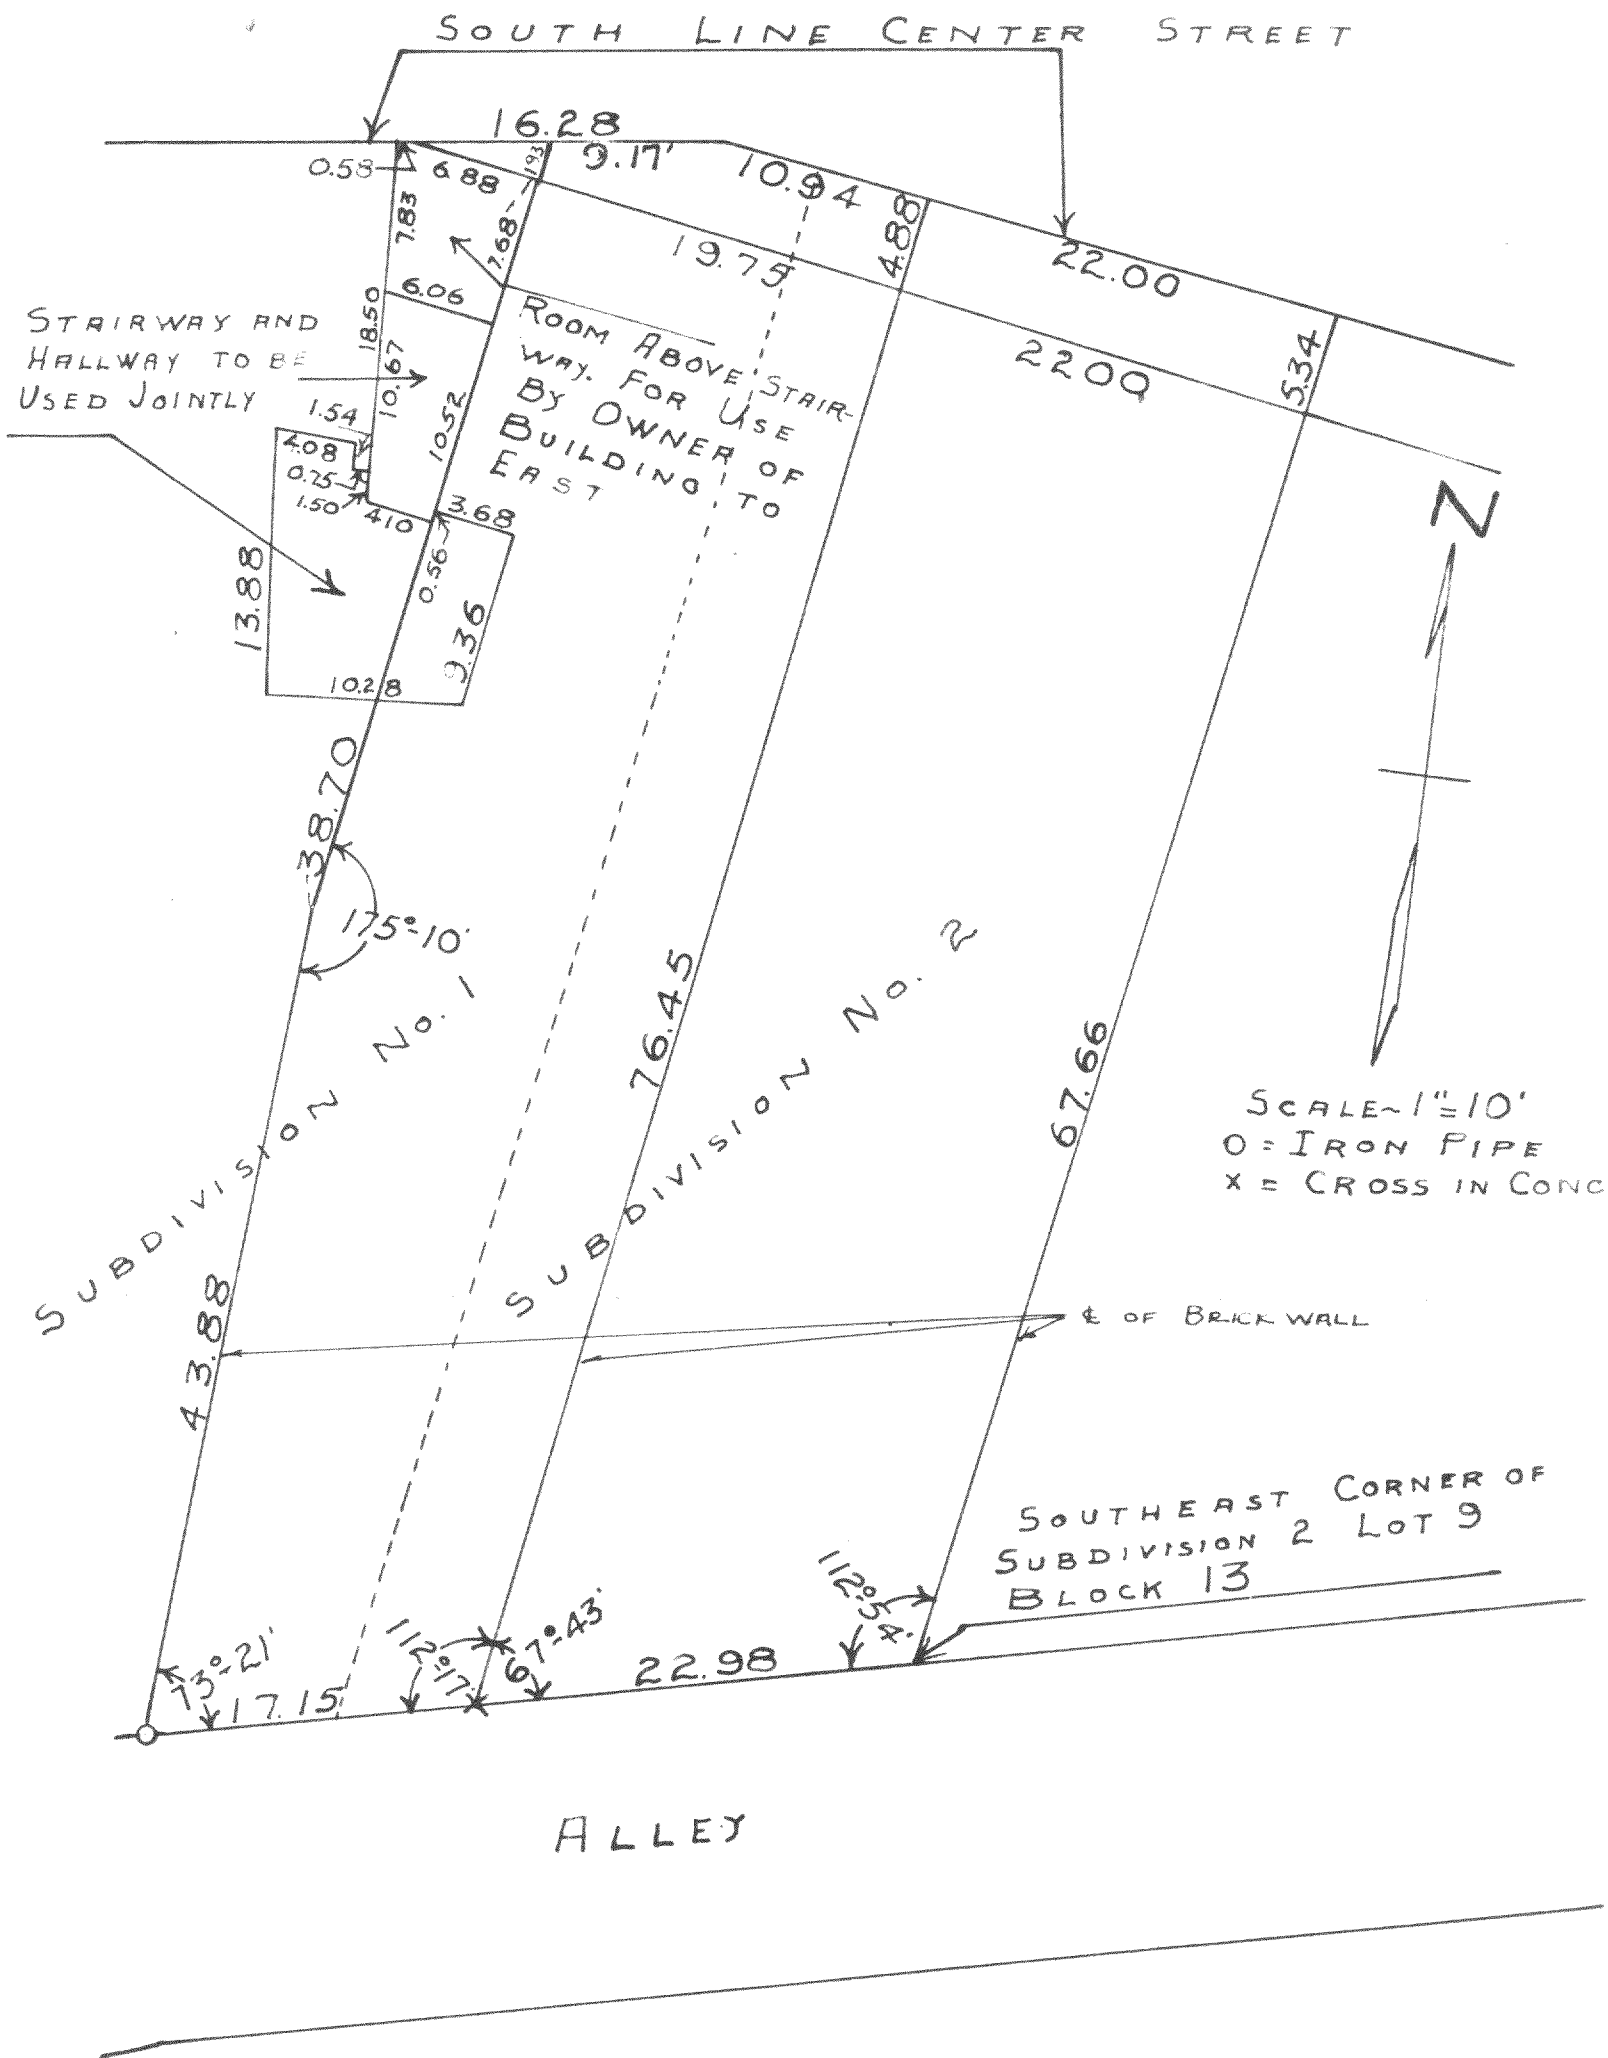

PLAT OF SURVEY OF SUBDIVISION No. 2
AND PART OF SUBDIVISION No. 1 OF LOT 9
OF BLOCK 13 OF THE ORIGINAL PLAT OF
VILLAGE (NOW CITY) OF WHITEWATER, WALWORTH
COUNTY, WISCONSIN

OCT. 1948

Lloyd L. Jensen
COUNTY SURVEYOR

10-625