


PLAT OF SURVEY

LEGAL DESCRIPTION:
IN THE NE 1/4, SEC. 4, T4N, R15E, IN THE CITY OF
WHITEWATER, WALWORTH CO., WISCONSIN.

LOT 8, BLOCK 2, DANN'S ADDITION TO THE VILLAGE OF
WHITEWATER.

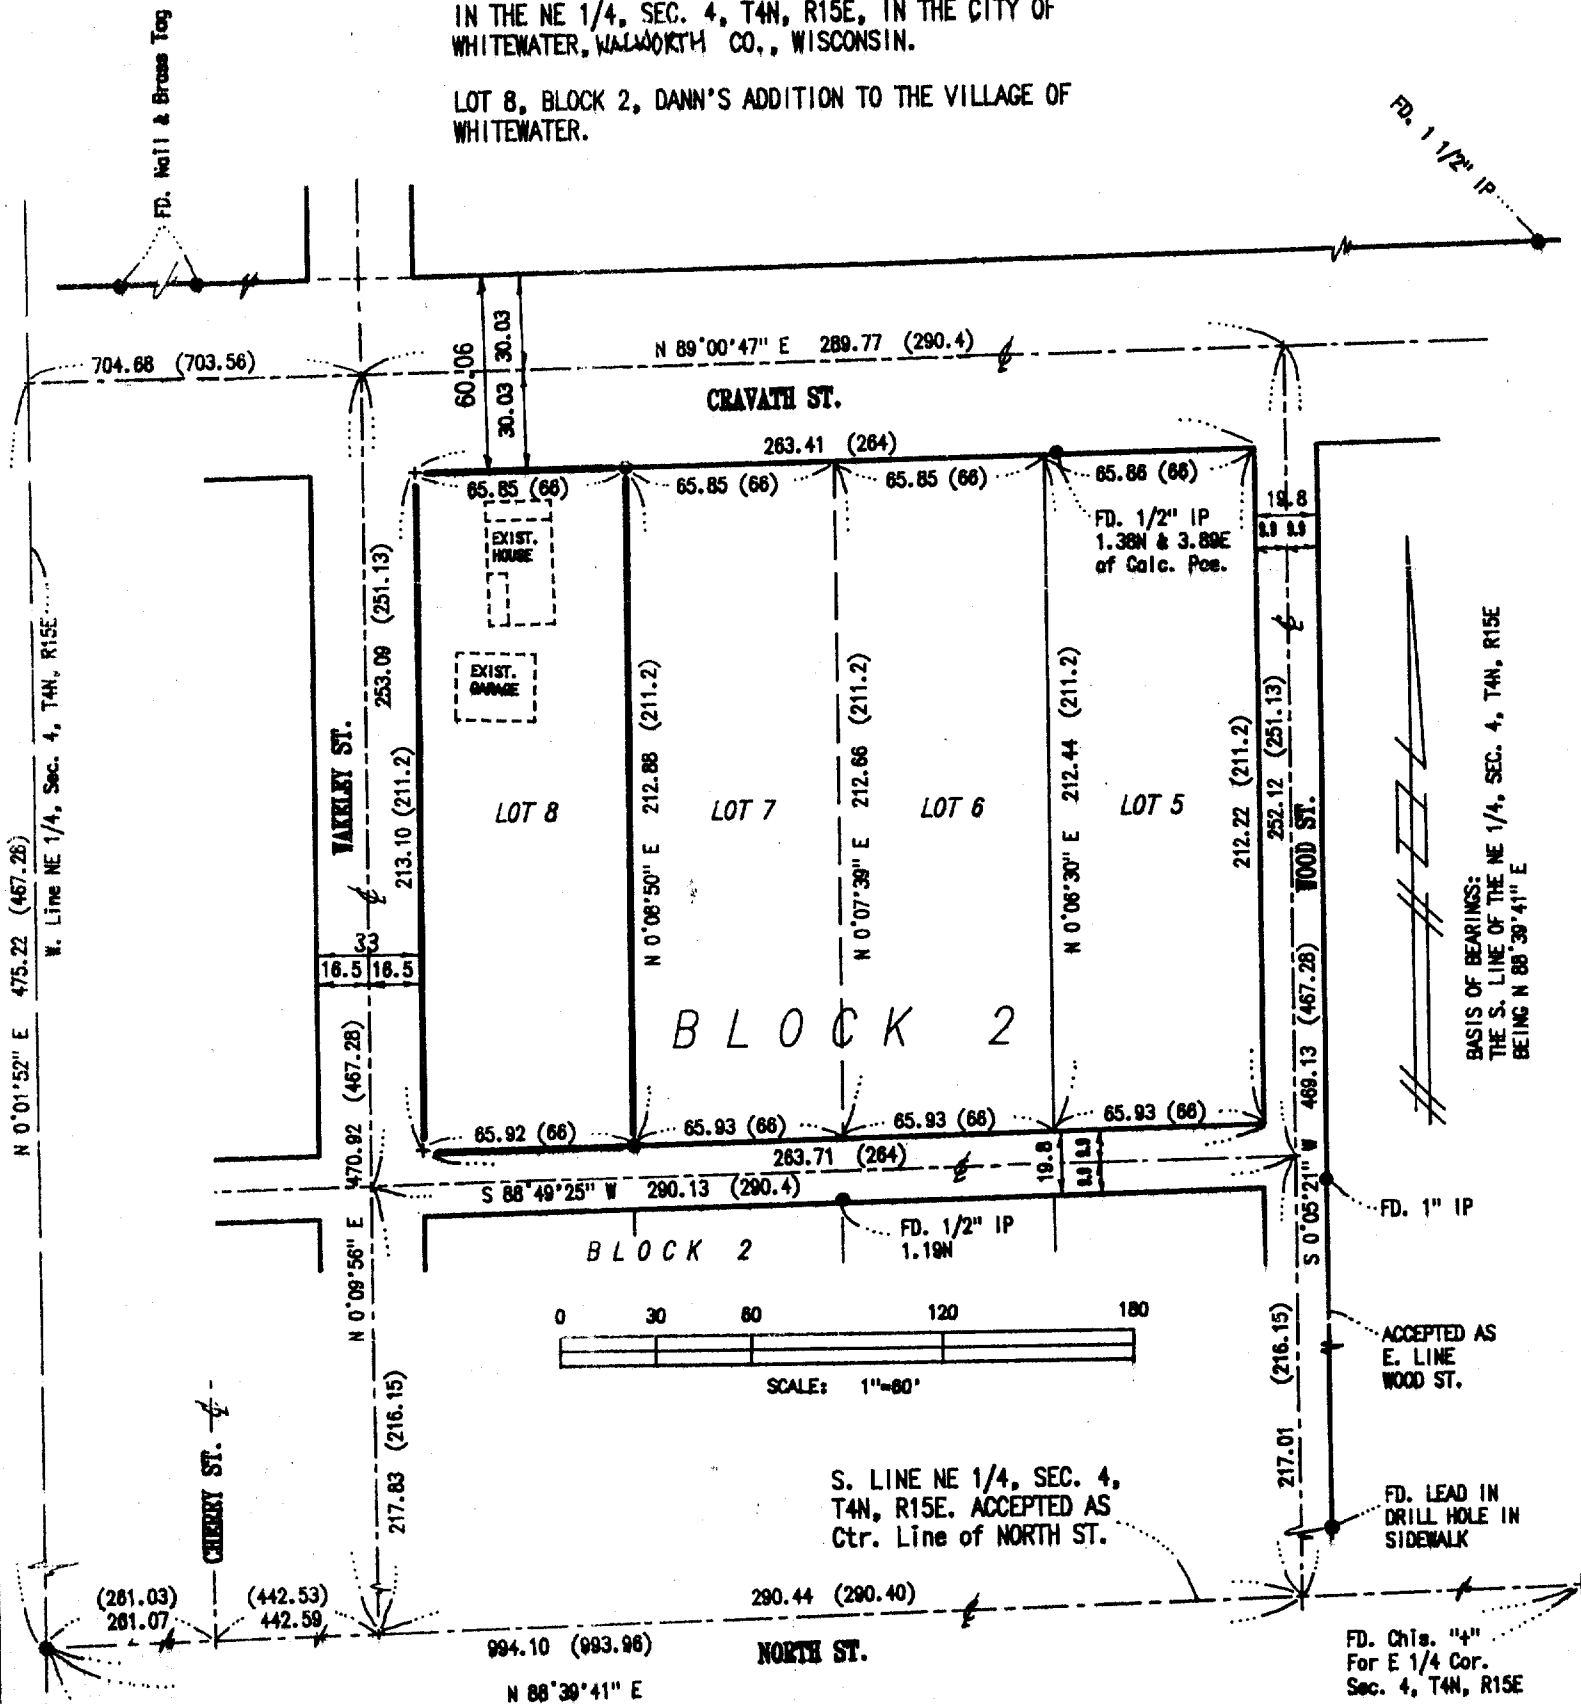

NOTE: The Plat for DANN'S ADDITION indicates a width of 70 links for the R/W of NORTH ST. The width reflected on plats to the W., E. and S. is 75 links. It has been assumed that the width reflected on DANN'S ADDITION is in error, and 75 links (48.5') has been used in the development of BLK 2.

NOTES:


- () — Indicates Record Data
- — Indicates Int. FD. as Noted
- — Indicates SET 1" Iron Pipe
- + — Indicates SET Chls. "+" In Top of Curb

SURVEYOR'S CERTIFICATE

I, JAMES K. LANGONE, REGISTERED LAND SURVEYOR, CERTIFY THAT I HAVE SURVEYED THE PROPERTY DESCRIBED HEREON AND THAT THIS PLAT IS A TRUE AND CORRECT REPRESENTATION OF THE BOUNDARIES THEREOF.

DATE: 12/03/98

JAMES K. LANGONE
REGISTERED LAND SURVEYOR, S-1347

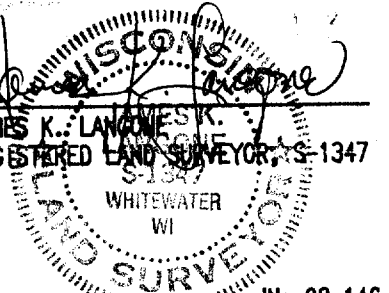

JN: 98-146
12/02/98

JAMES K. LANGONE
LAND SURVEYS & CIVIL ENGINEERING

N339 Co. Rd. "N" (Upper)

Whitewater, WI. 53190-2842

(414) 473-4119

DA-16

010-640