


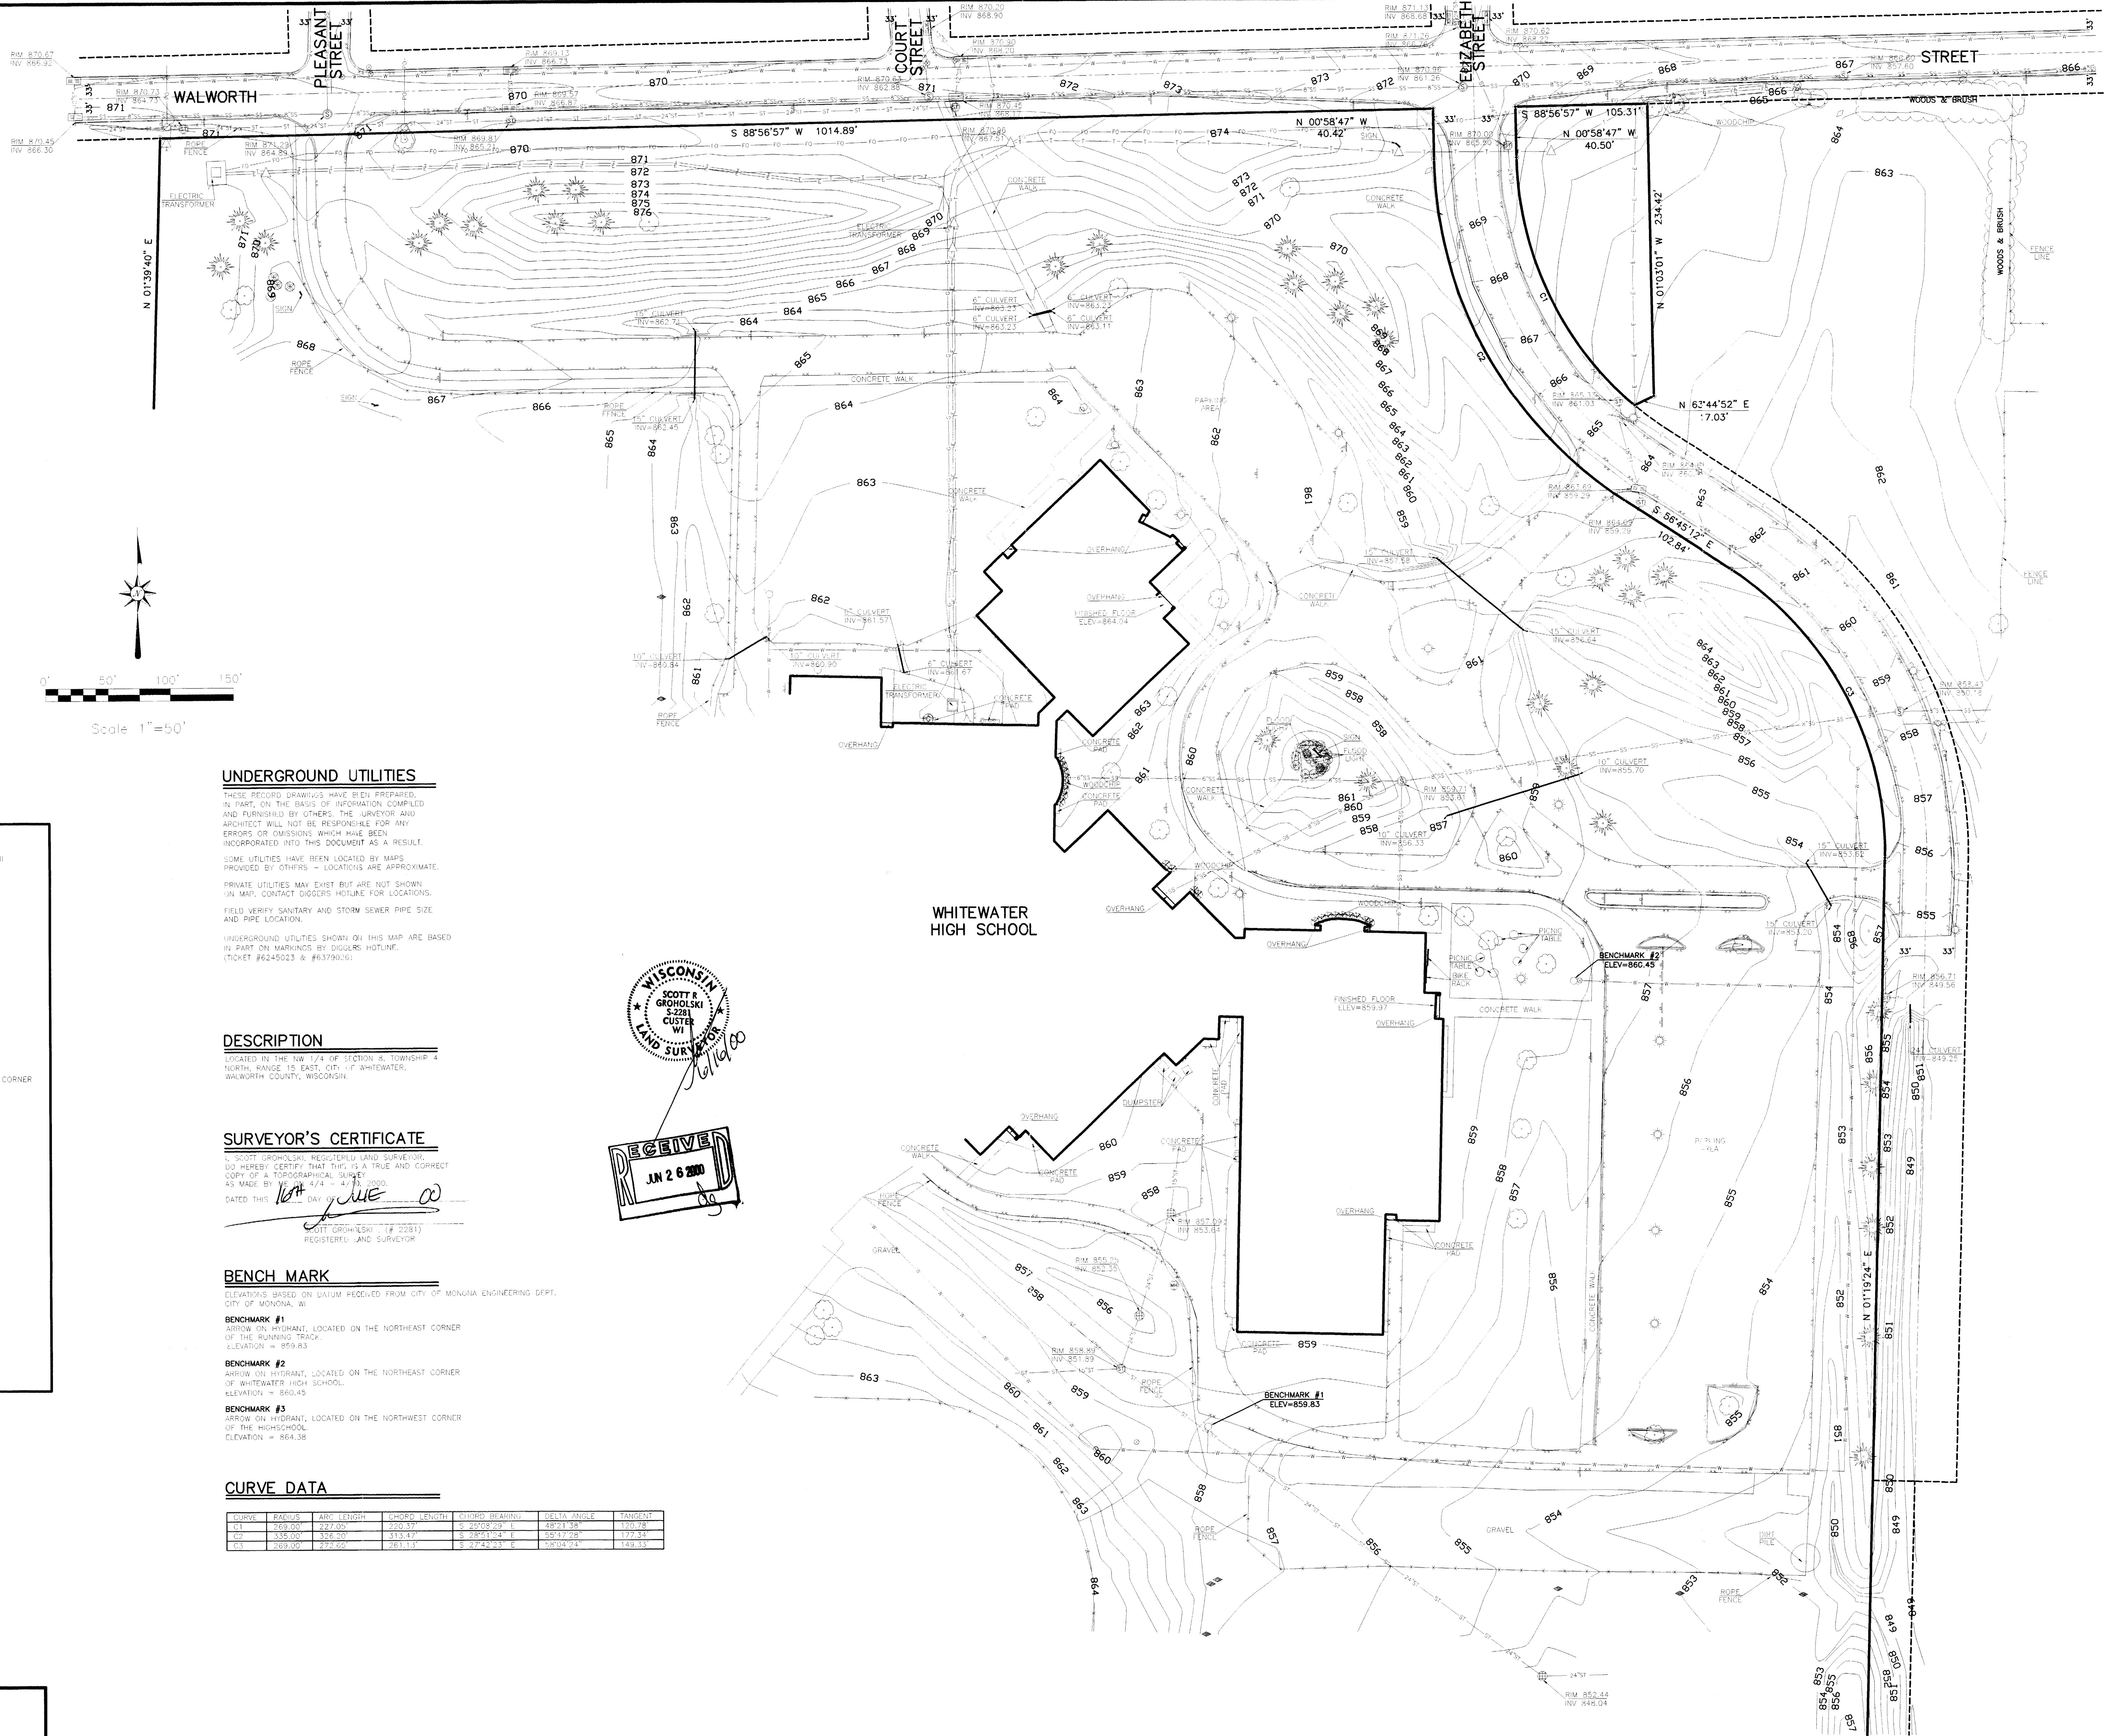

UNDERGROUND UTILITIES

THESE RECORD DRAWINGS HAVE BEEN PREPARED IN PART ON THE BASIS OF INFORMATION COMPILED AND FURNISHED BY OTHERS. THE SURVEYOR AND ARCHITECT WILL NOT BE RESPONSIBLE FOR ANY ERRORS OR OMISSIONS WHICH HAVE BEEN INCORPORATED INTO THIS DOCUMENT AS A RESULT. SOME UTILITIES HAVE BEEN LOCATED BY MAPS PROVIDED BY OTHERS - LOCATIONS ARE APPROXIMATE. PRIVATE UTILITIES MAY EXIST BUT ARE NOT SHOWN ON MAP. CONTACT DIGGERS HOTLINE FOR LOCATIONS. FIELD VERIFY SANITARY AND STORM SEWER PIPE SIZE AND PIPE LOCATION. UNDERGROUND UTILITIES SHOWN ON THIS MAP ARE BASED IN PART ON MARKINGS BY DIGGERS HOTLINE. (TICKET #6245023 & #6379000)

DESCRIPTION

LOCATED IN THE NW 1/4 OF SECTION 8, TOWNSHIP 4 NORTH, RANGE 15, EAST, CITY OF WHITEWATER, WAUKESHA COUNTY, WISCONSIN.

SURVEYOR'S CERTIFICATE

I, SCOTT GROHOLSKI, REGISTERED LAND SURVEYOR, DO HEREBY CERTIFY THAT THIS IS A TRUE AND CORRECT COPY OF A TOPOGRAPHICAL SURVEY AS MADE BY ME 1/4 - 4/10/2020. DATED THIS 10th DAY OF JUNE 2020. SCOTT GROHOLSKI (# 2281) REGISTERED LAND SURVEYOR

BENCH MARK

ELEVATIONS BASED ON DATUM PROVIDED FROM CITY OF MONROVIA ENGINEERING DEPT., CITY OF MONROVIA, WI.
BENCHMARK #1
ARROW ON HYDRANT, LOCATED ON THE NORTHEAST CORNER OF THE RUNNING TRACK.
ELEVATION = 859.83
BENCHMARK #2
ARROW ON HYDRANT, LOCATED ON THE NORTHEAST CORNER OF WHITEWATER HIGH SCHOOL.
ELEVATION = 860.45
BENCHMARK #3
ARROW ON HYDRANT, LOCATED ON THE NORTHWEST CORNER OF THE HIGH SCHOOL.
ELEVATION = 864.38

CURVE DATA

CURVE	RADIUS	ARC LENGTH	CHORD LENGTH	CHORD BEARING	DELTA ANGLE	TANGENT
C1	268.00'	227.00'	220.39'	S 22°08'25" E	48°21'32"	130.78'
C2	268.00'	227.00'	220.39'	S 22°08'25" E	48°21'32"	130.78'
C3	268.00'	227.00'	220.39'	S 22°08'25" E	48°21'32"	130.78'

- LEGEND**
- These standard symbols will be found in the drawing.
- LIGHT POLE
 - POWER POLE
 - GUY
 - TELEPHONE PEDESTAL
 - UTILITY MANHOLE
 - SANITARY MANHOLE
 - WATER MANHOLE
 - STORM MANHOLE
 - CATCH BASIN
 - WATER VALVE
 - HYDRANT
 - 1" IRON PIPE FOUND
 - #6 RE-BAR FOUND
 - COMPUTED PROPERTY CORNER
 - TTTNOT
 - SANITARY SEWER
 - STORM SEWER
 - POWER OVERHEAD
 - BURIED ELECTRIC
 - BURIED GAS
 - BURIED TELEPHONE
 - WATERMAIN
 - FIBER OPTICS
 - EDGE OF BITUMINOUS
 - FLAG POLE
 - TREE
 - PINE TREE
 - BUSH/SHRUB
 - ELECTRIC METER
 - GAS METER
 - GAS VALVE
 - CONTOUR LINE
 - SIGN
 - PK. NAIL/SPIKE
 - LOG/HAUL PILE
 - VENT PIPE
 - IRRIGATION BOX
 - TRASH CAN

REVISIONS

1.	6/16/00
----	---------

DATE: 5/16/00

DRAWN: TRAVIS PLANTIC

CHECKED: SCOTT GROHOLSKI

DOCUMENT NO: 00542

LANDSCAPE ARCHITECTURE

ENGINEERING

LAND SURVEYING

SITE MAINTENANCE

SITE CONSTRUCTION MANAGEMENT

SCOTT GROHOLSKI

397 BUSINESS PARK DRIVE - SHEWATER, WI 54481

PHONE: 715 - 241 - 0421 FAX: 715 - 241 - 0421 EMAIL: scott@scottgroholski.com

TOPOGRAPHIC MAP

WHITEWATER SCHOOL DISTRICT

WHITEWATER HIGH SCHOOL

TOPO