


RECORDED RIGHT-OF-WAY WIDTH OF "FONDA STREET" COULD NOT BE DETERMINED BY OLD MAPPING. IF ANY IMPROVEMENTS ARE PROPOSED ALONG "FONDA STREET" CONTACT THE CITY OF WHITEWATER FOR SETBACK INFORMATION.

LEGEND

These standard symbols will be found in the drawing.

- LIGHT POLE
- POWER POLE
- GUY
- TELEPHONE PEDESTAL
- ELECTRICAL BOX
- SANITARY MANHOLE
- ELECTRIC MANHOLE
- STORM MANHOLE
- CATCH BASIN
- WATER VALVE
- HYDRANT
- CHISELED CROSS
- 1" IRON PIPE SET
- FENCE
- SANITARY SEWER
- STORM SEWER
- POWER OVERHEAD
- BURIED ELECTRIC
- BURIED GAS
- BURIED TELEPHONE
- WATERMAIN
- FIBER OPTICS
- EDGE OF BITUMINOUS
- FLAG POLE
- TREE
- PINE TREE
- HEDGE
- ELECTRIC METER
- GAS METER
- GAS VALVE
- CONTOUR LINE
- SIGN
- PK NAIL/SPIKE
- PLAY EQUIPMENT
- GAUZE POST
- VENT PIPE
- BASKETBALL HOOP
- SWING
- ANTENNA

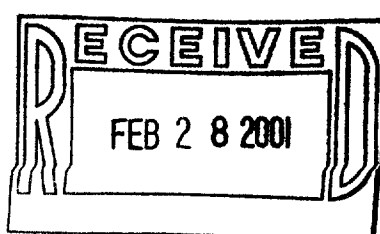

RETAILER CORPORATION, INC. HELPS THE PEOPLE TO COMPARE AND TO
THESE PRINTS, DRAWINGS AND DOCUMENTS NO REPRODUCTION, COPYING,
ALTERATION, MODIFICATION, LAMINATE, REPRODUCTION AND OTHER DOCUMENTS OR
REPRODUCTION OF THE SAME MAY OCCUR WITHOUT THE PRIOR WRITTEN PERMISSION
OF RETAILER CORPORATION, INC.
©1999 RETAILER CORPORATION, INC.

BENCH MARK

ELEVATIONS BASED ON DATA RECEIVED FROM THE CITY
OF WHITEWATER ENGINEERING DEPARTMENT.

TOP NUT ON HYDRANT, LOCATED ON THE NORTHEAST
CORNER OF FONDA STREET AND MAIN STREET.
ELEVATION = 847.88

SURVEYOR'S CERTIFICATE

SCOTT GROHOLSKI, REGISTERED LAND SURVEYOR
DO HEREBY CERTIFY THAT THIS IS A TRUE AND CORRECT
COPY OF A TOPOGRAPHICAL SURVEY
AS MADE BY ME ON 9/27 - 9/28, 1999

DATED THIS _____ DAY OF _____

SCOTT GROHOLSKI, (# 2281)
REGISTERED LAND SURVEYOR



DESCRIPTION

BEING ALL OF LOT 6 AND 7 OF THE TRIPPS ADDITION TO THE CITY
OF WHITEWATER, LOCATED IN PART OF THE SOUTHEAST 1/4 OF THE
NORTHEAST 1/4 OF SECTION 4, TOWN 4 NORTH, RANGE 15 EAST,
CITY OF WHITEWATER, WALWORTH COUNTY, WISCONSIN.


UNDERGROUND UTILITIES

THESE RECORD DRAWINGS HAVE BEEN PREPARED
IN PART, ON THE BASIS OF INFORMATION COMPILED
AND FURNISHED BY OTHERS. THE SURVEYOR AND
ARCHITECT WILL NOT BE RESPONSIBLE FOR ANY
ERRORS OR OMISSIONS WHICH HAVE BEEN
INCORPORATED INTO THIS DOCUMENT AS A RESULT.

SOME UTILITIES HAVE BEEN LOCATED BY MAPS
PROVIDED BY OTHERS - LOCATIONS ARE APPROXIMATE.
PRIVATE UTILITIES MAY EXIST BUT ARE NOT SHOWN
ON MAP. CONTACT DIGGERS HOTLINE FOR LOCATIONS.

FIELD VERIFY SANITARY AND STORM SEWER PIPE SIZE
AND LOCATION.

UNDERGROUND UTILITIES SHOWN ON THIS MAP ARE
BASED IN PART ON MARKINGS BY DIGGERS HOTLINE.
(TICKET # 5869522)

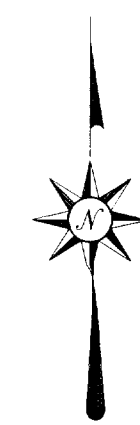


0' 40' 80' 120'

Scale 1"=40'

WHITEWATER
SCHOOL DISTRICT
WASHINGTON
ELEMENTARY SCHOOL

TOPOGRAPHIC MAP

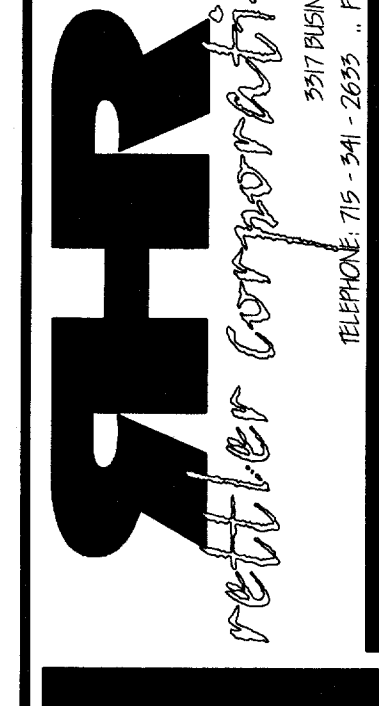

LANDSCAPE ARCHITECTURE
ENGINEERING
LAND SURVEYING
SITE CONSTRUCTION MANAGEMENT
SITE MAINTENANCE
SCOTT GROHOLSKI
5907 BUSINESS PARK DRIVE - STEVENSON, WI 54484
TELEPHONE: 715-541-2825 FAX: 715-541-0451 EMAIL: info@retzler.com

DATE: 9/27/99
DRAWN: TRAVIS PLANTICO
CHECKED: SCOTT GROHOLSKI
DOCUMENT NO.: 99-556

REVISIONS
REV: 10/19/99
CS: 11/17/99
CP: 11/29/99
TP: 1/11/00