

Plat of Survey

Survey For: Verla M. Cullum


Location: #403 South Whiton Street, City of Whitewater, Walworth County

Description: Lot 10 in Block 2 of Birge's Addition to the City of Whitewater, County of Walworth, State of Wisconsin.

Subject to all rights, reservations, restrictive covenants, and easements recorded or unrecorded.



SCALE: 1" = 30'

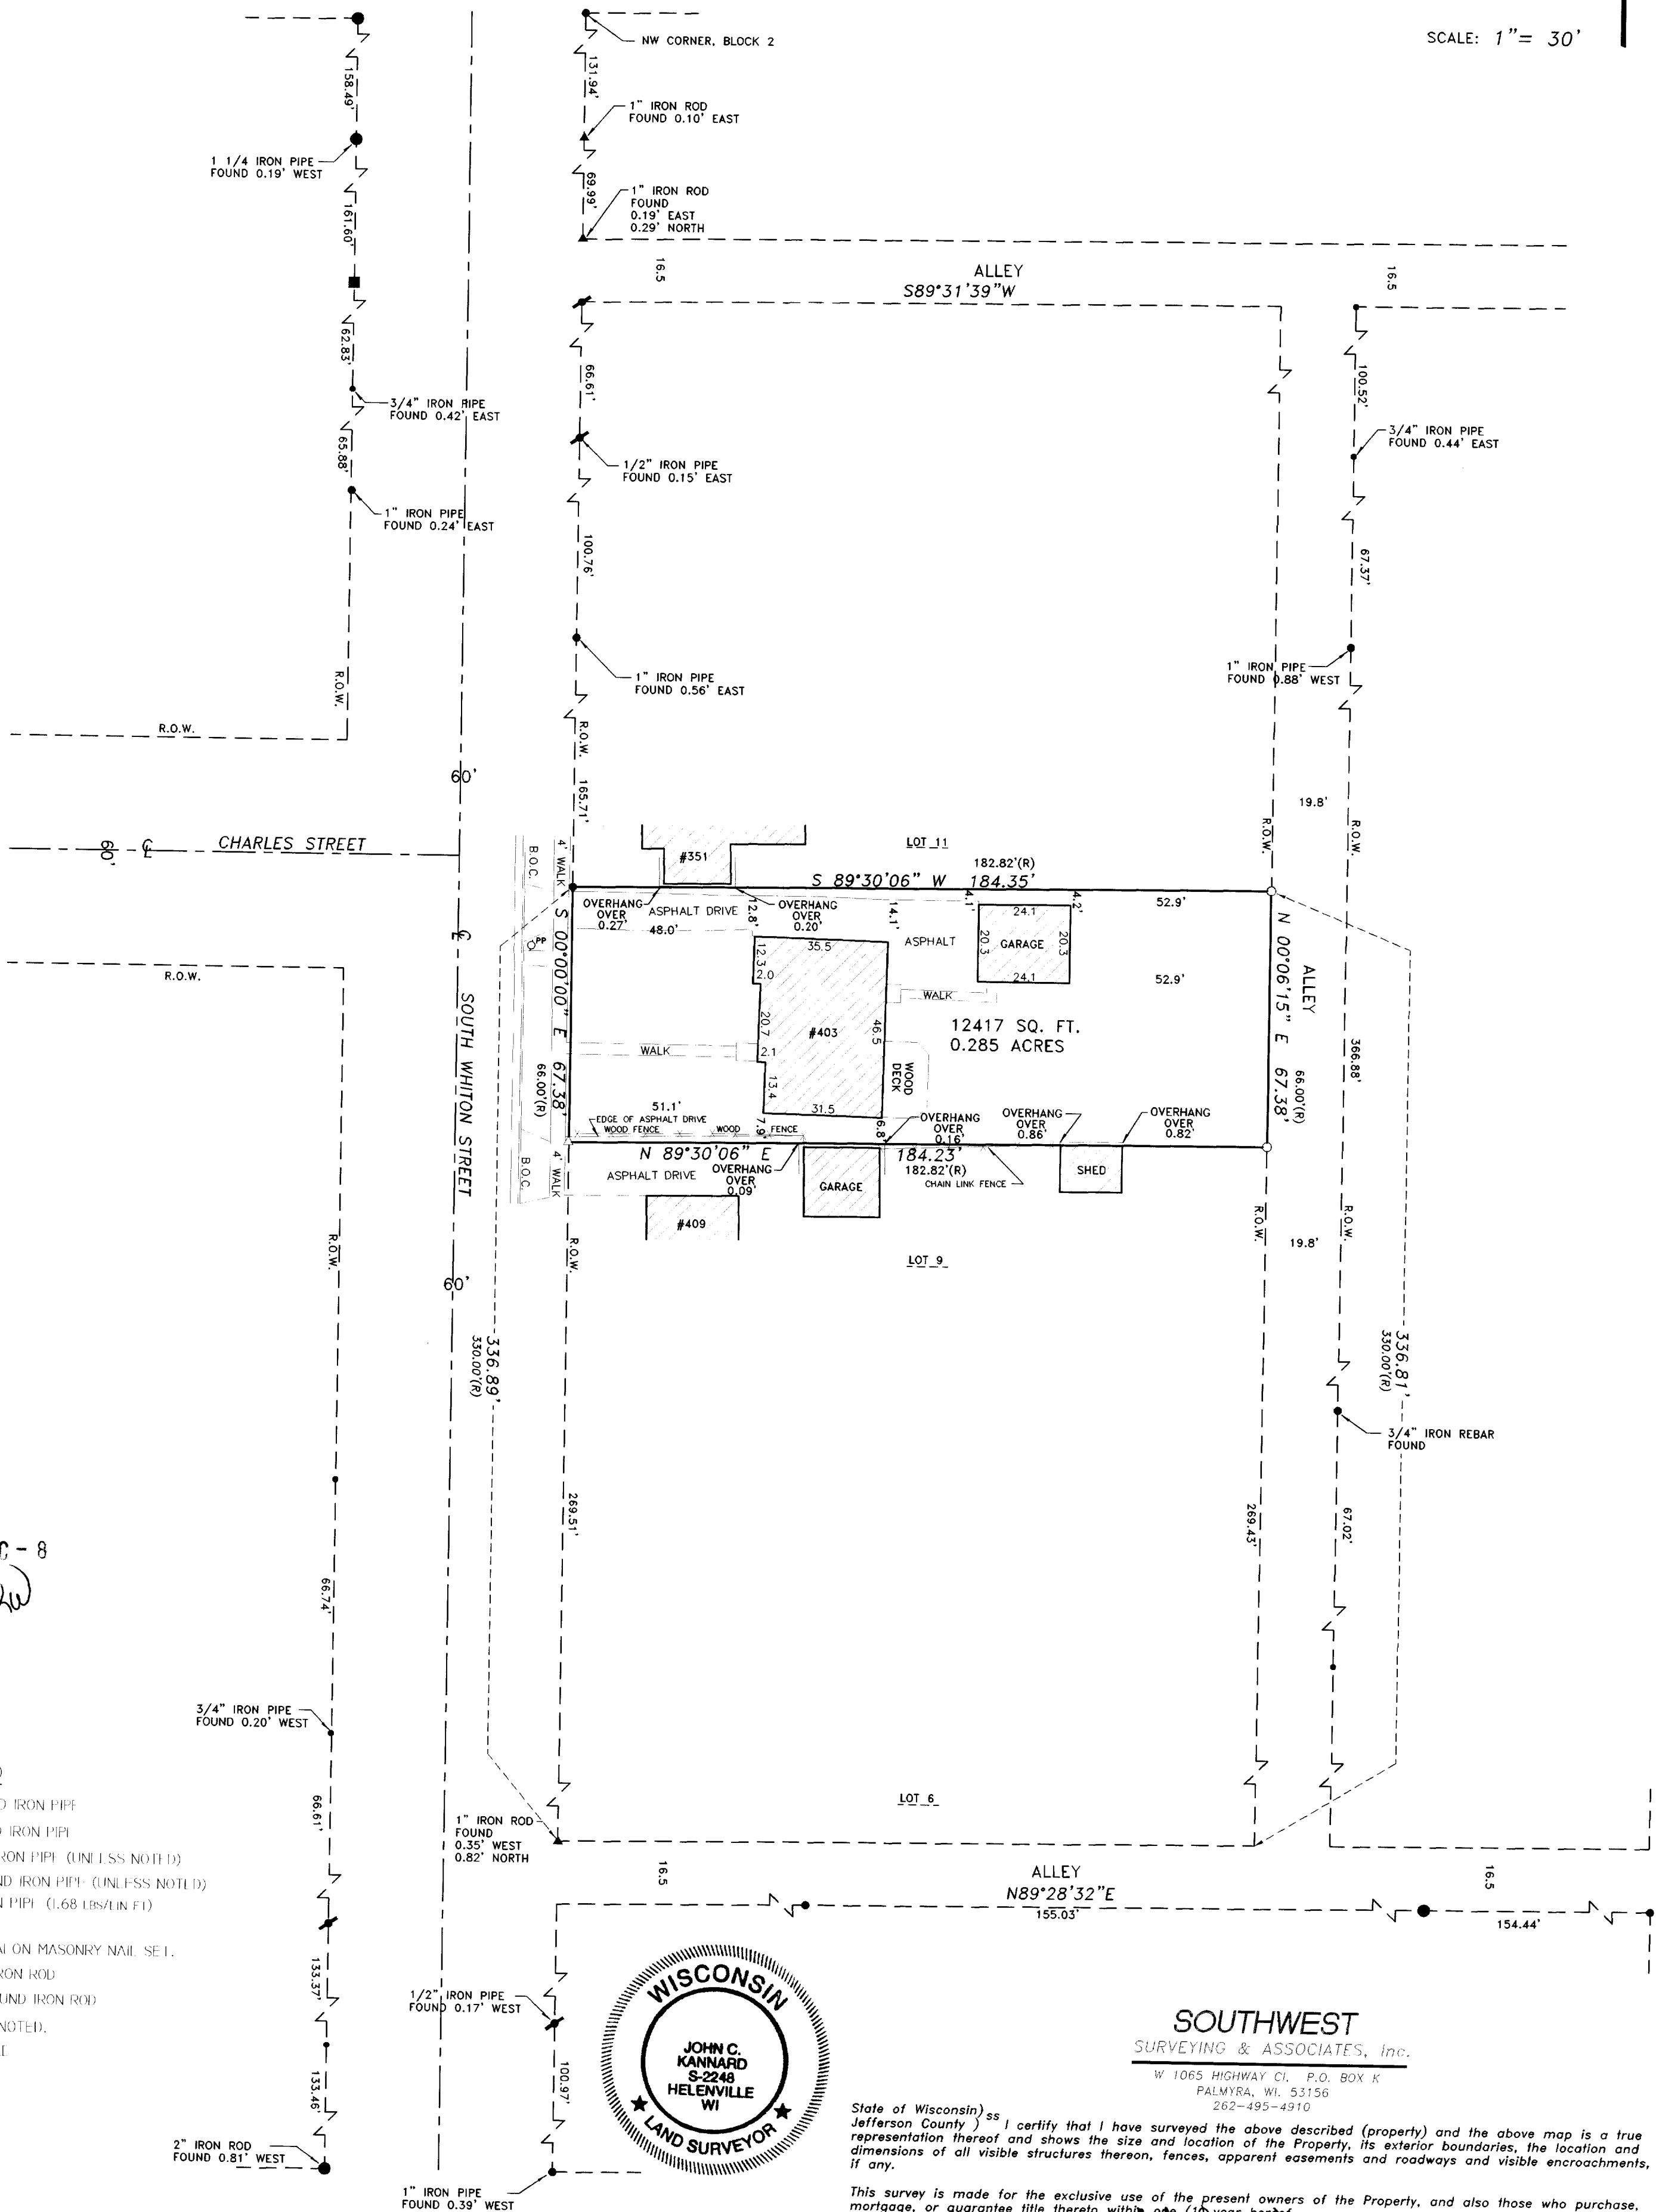


DEC - 8

KW

LEGEND

- 3/4" FOUND IRON PIPE
- ▲ 1/2" FOUND IRON PIPE
- 1" FOUND IRON PIPE (UNLESS NOTED)
- 1 1/4" FOUND IRON PIPE (UNLESS NOTED)
- 1"x24" IRON PIPE (1.68 LBS/LIN FT) SET.
- △ PARKER-KAI ON MASONRY NAIL SET.
- ▲ 1" FOUND IRON ROD
- 1"x1 1/2" FOUND IRON ROD
- FENCE AS NOTED.
- PP POWER POLE

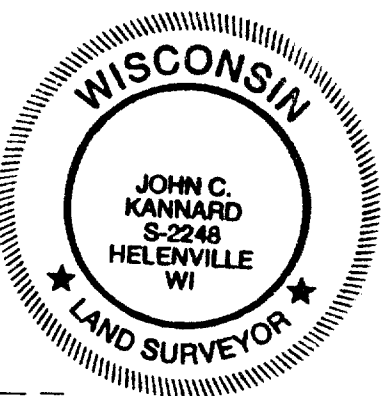

SOUTHWEST
SURVEYING & ASSOCIATES, Inc.

W 1065 HIGHWAY C1, P.O. BOX K
PALMYRA, WI 53156
262-495-4910

I, John C. Kannard, State of Wisconsin ss, I certify that I have surveyed the above described (property) and the above map is a true representation thereof and shows the size and location of the Property, its exterior boundaries, the location and dimensions of all visible structures thereon, fences, apparent easements and roadways and visible encroachments, if any.

This survey is made for the exclusive use of the present owners of the Property, and also those who purchase, mortgage, or guarantee title thereto within one (1) year hereof.

THIS IS A JOHN C. KANNARD AUTHORIZED
PRINT ONLY IF SIGNATURE APPEARS IN
RED INK ON BLACK LINE PRINT.

JOHN C. KANNARD, Registered Land Surveyor

SHEET 1 OF 1
DATE: AUGUST 5, 2003
JOB NO: C-203126

✓BIR-20

010-699