




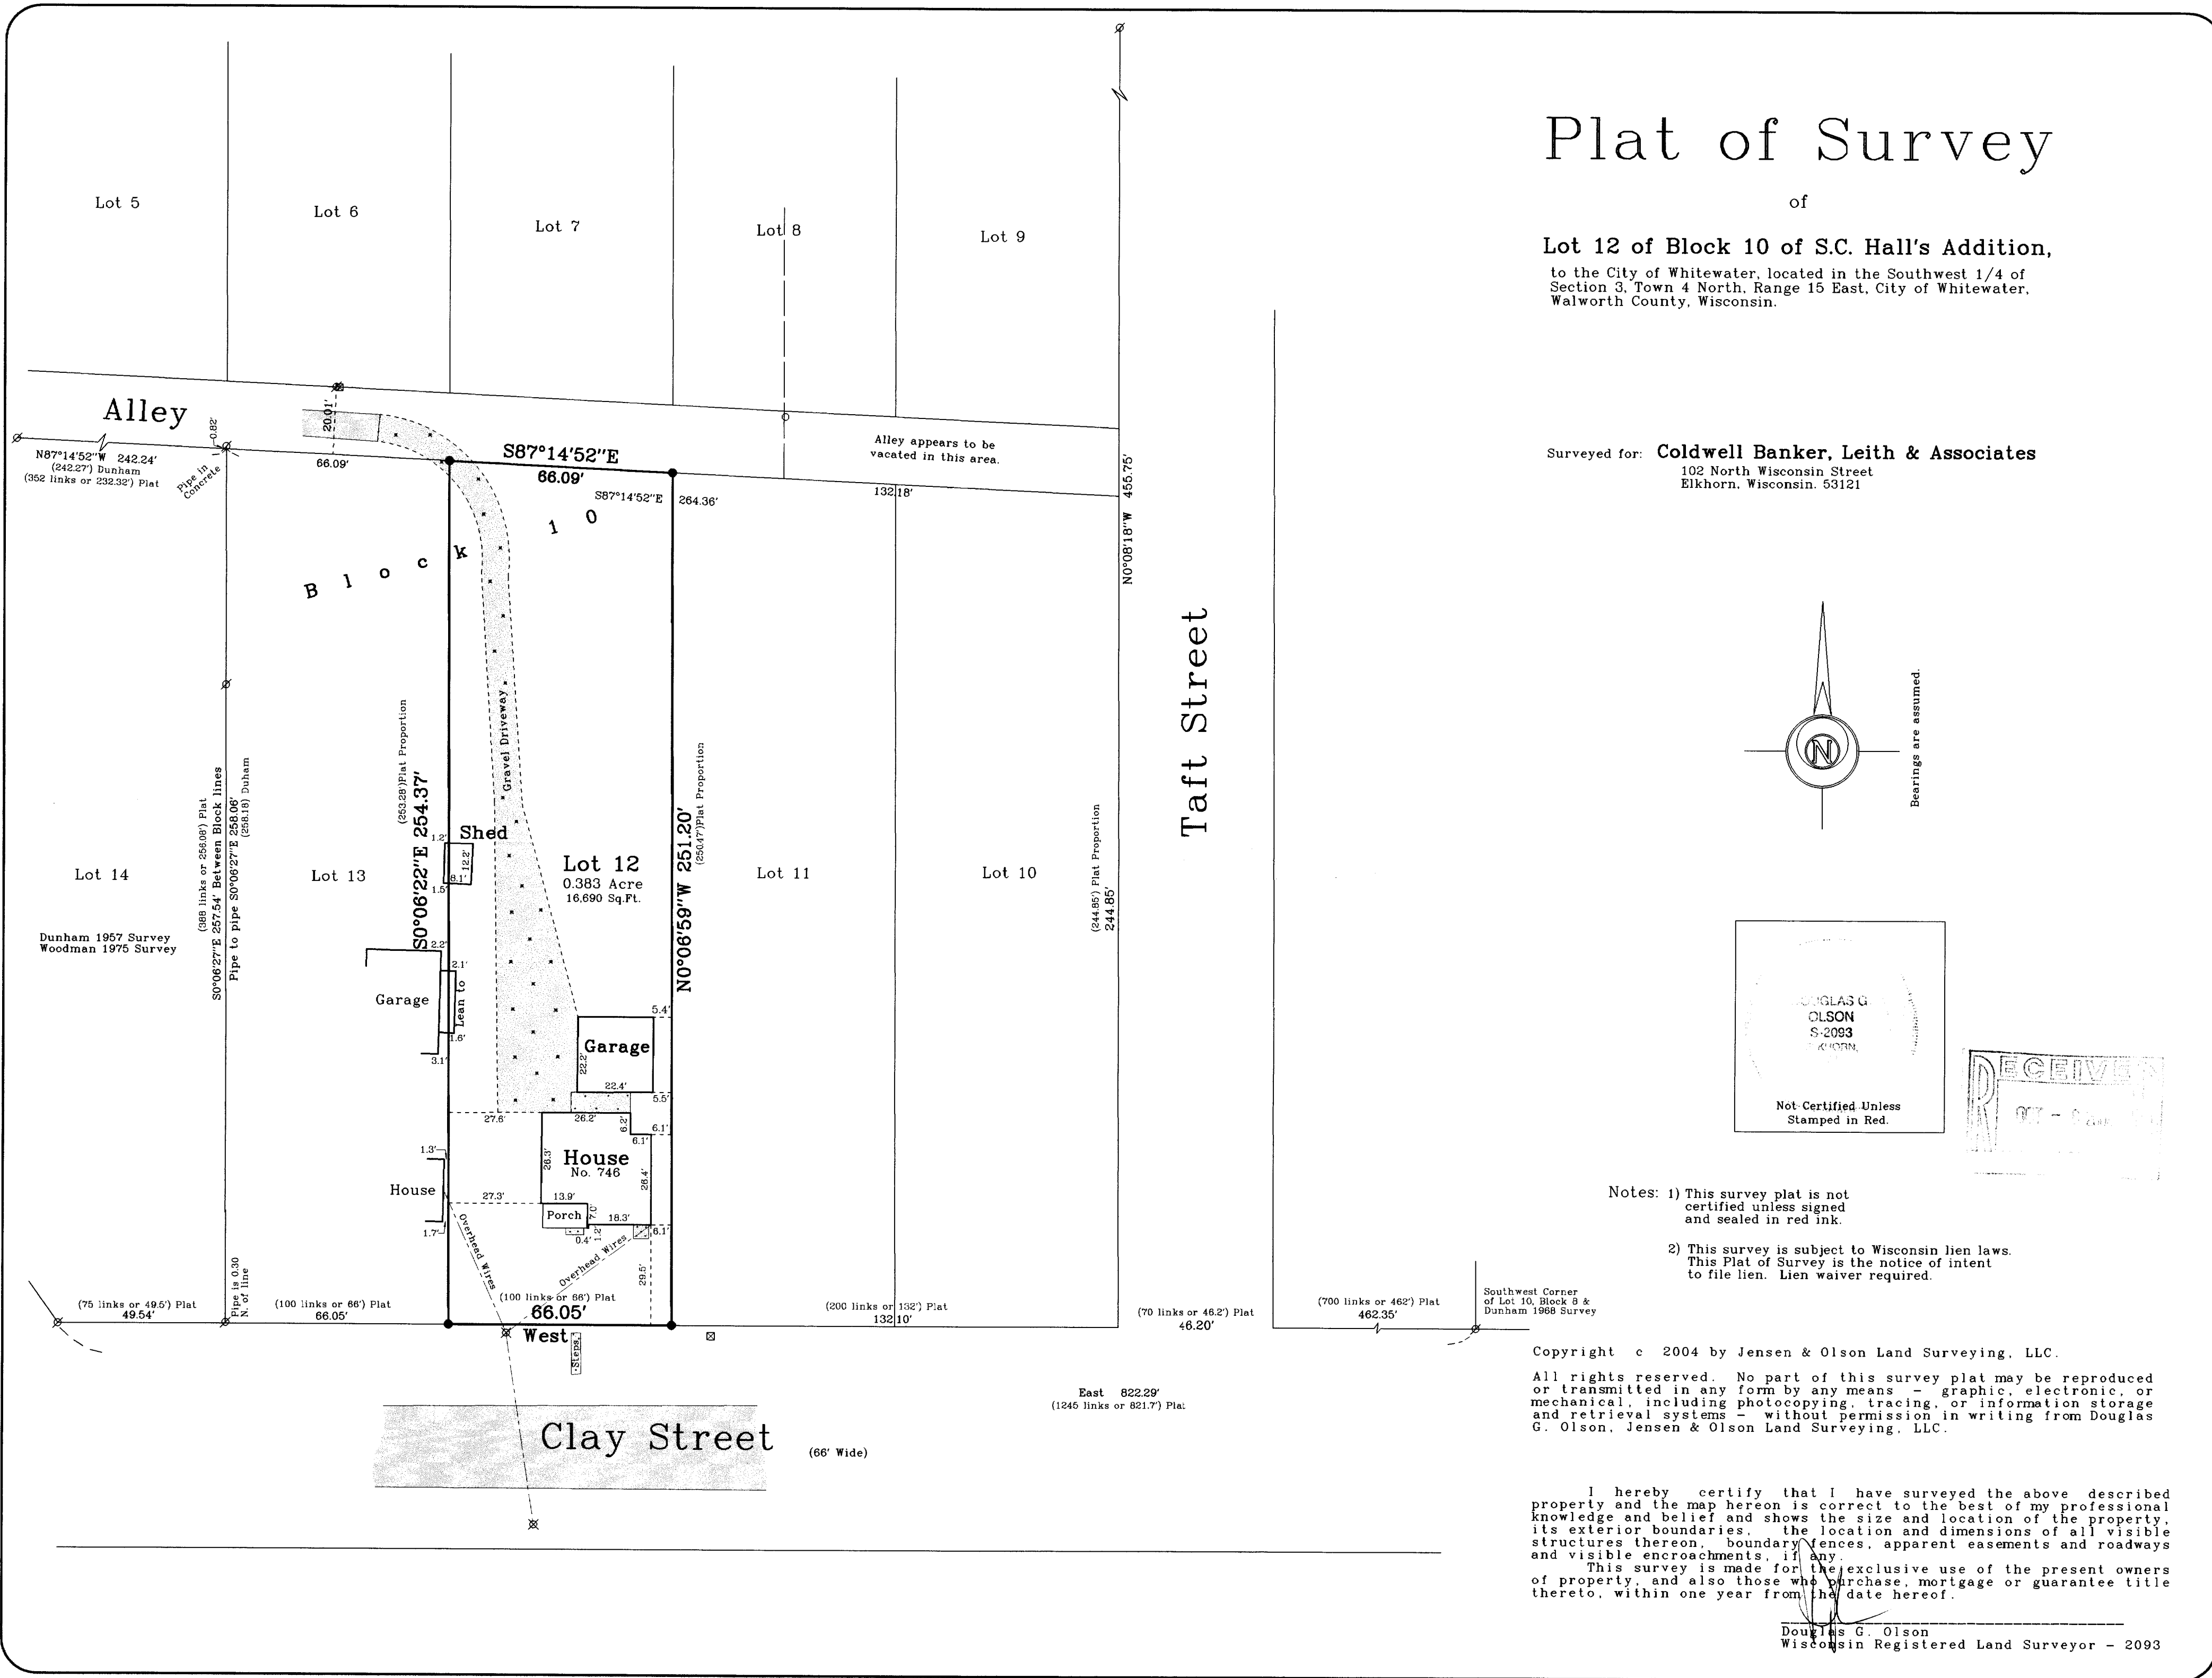


Plat of Survey

of

Lot 12 of Block 10 of S.C. Hall's Addition,
to the City of Whitewater, located in the Southwest 1/4 of
Section 3, Town 4 North, Range 15 East, City of Whitewater,
Walworth County, Wisconsin.

Surveyed for: **Coldwell Banker, Leith & Associates**
102 North Wisconsin Street
Elkhorn, Wisconsin. 53121

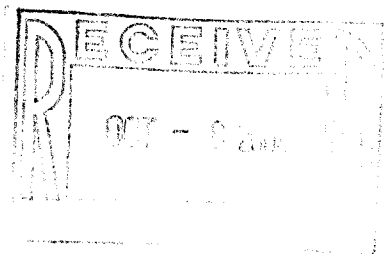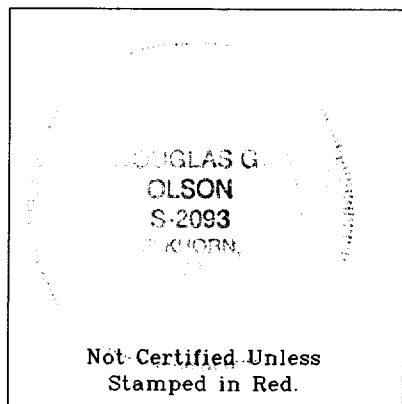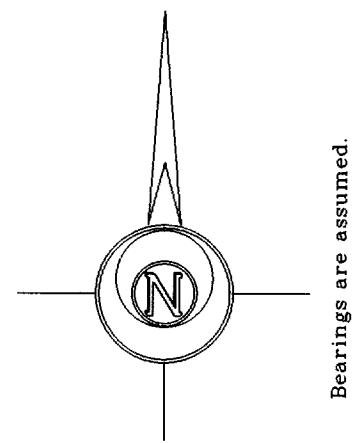

Survey Date: April 1, 2004. Revisions:	
Scale in Feet 1" = 30' 0 15' 30' 60'	
Jensen & Olson Land Surveying, LLC 45 South Wisconsin Street Elkhorn, Wisconsin. 53121 P.O. Box 322 Telephone (262) 723-3434 Facsimile (262) 723-8044	
Sheet 1 of 1 Sheets	Job Reference Number 2004.032
2004.032	

/HAS 00062

010-718