


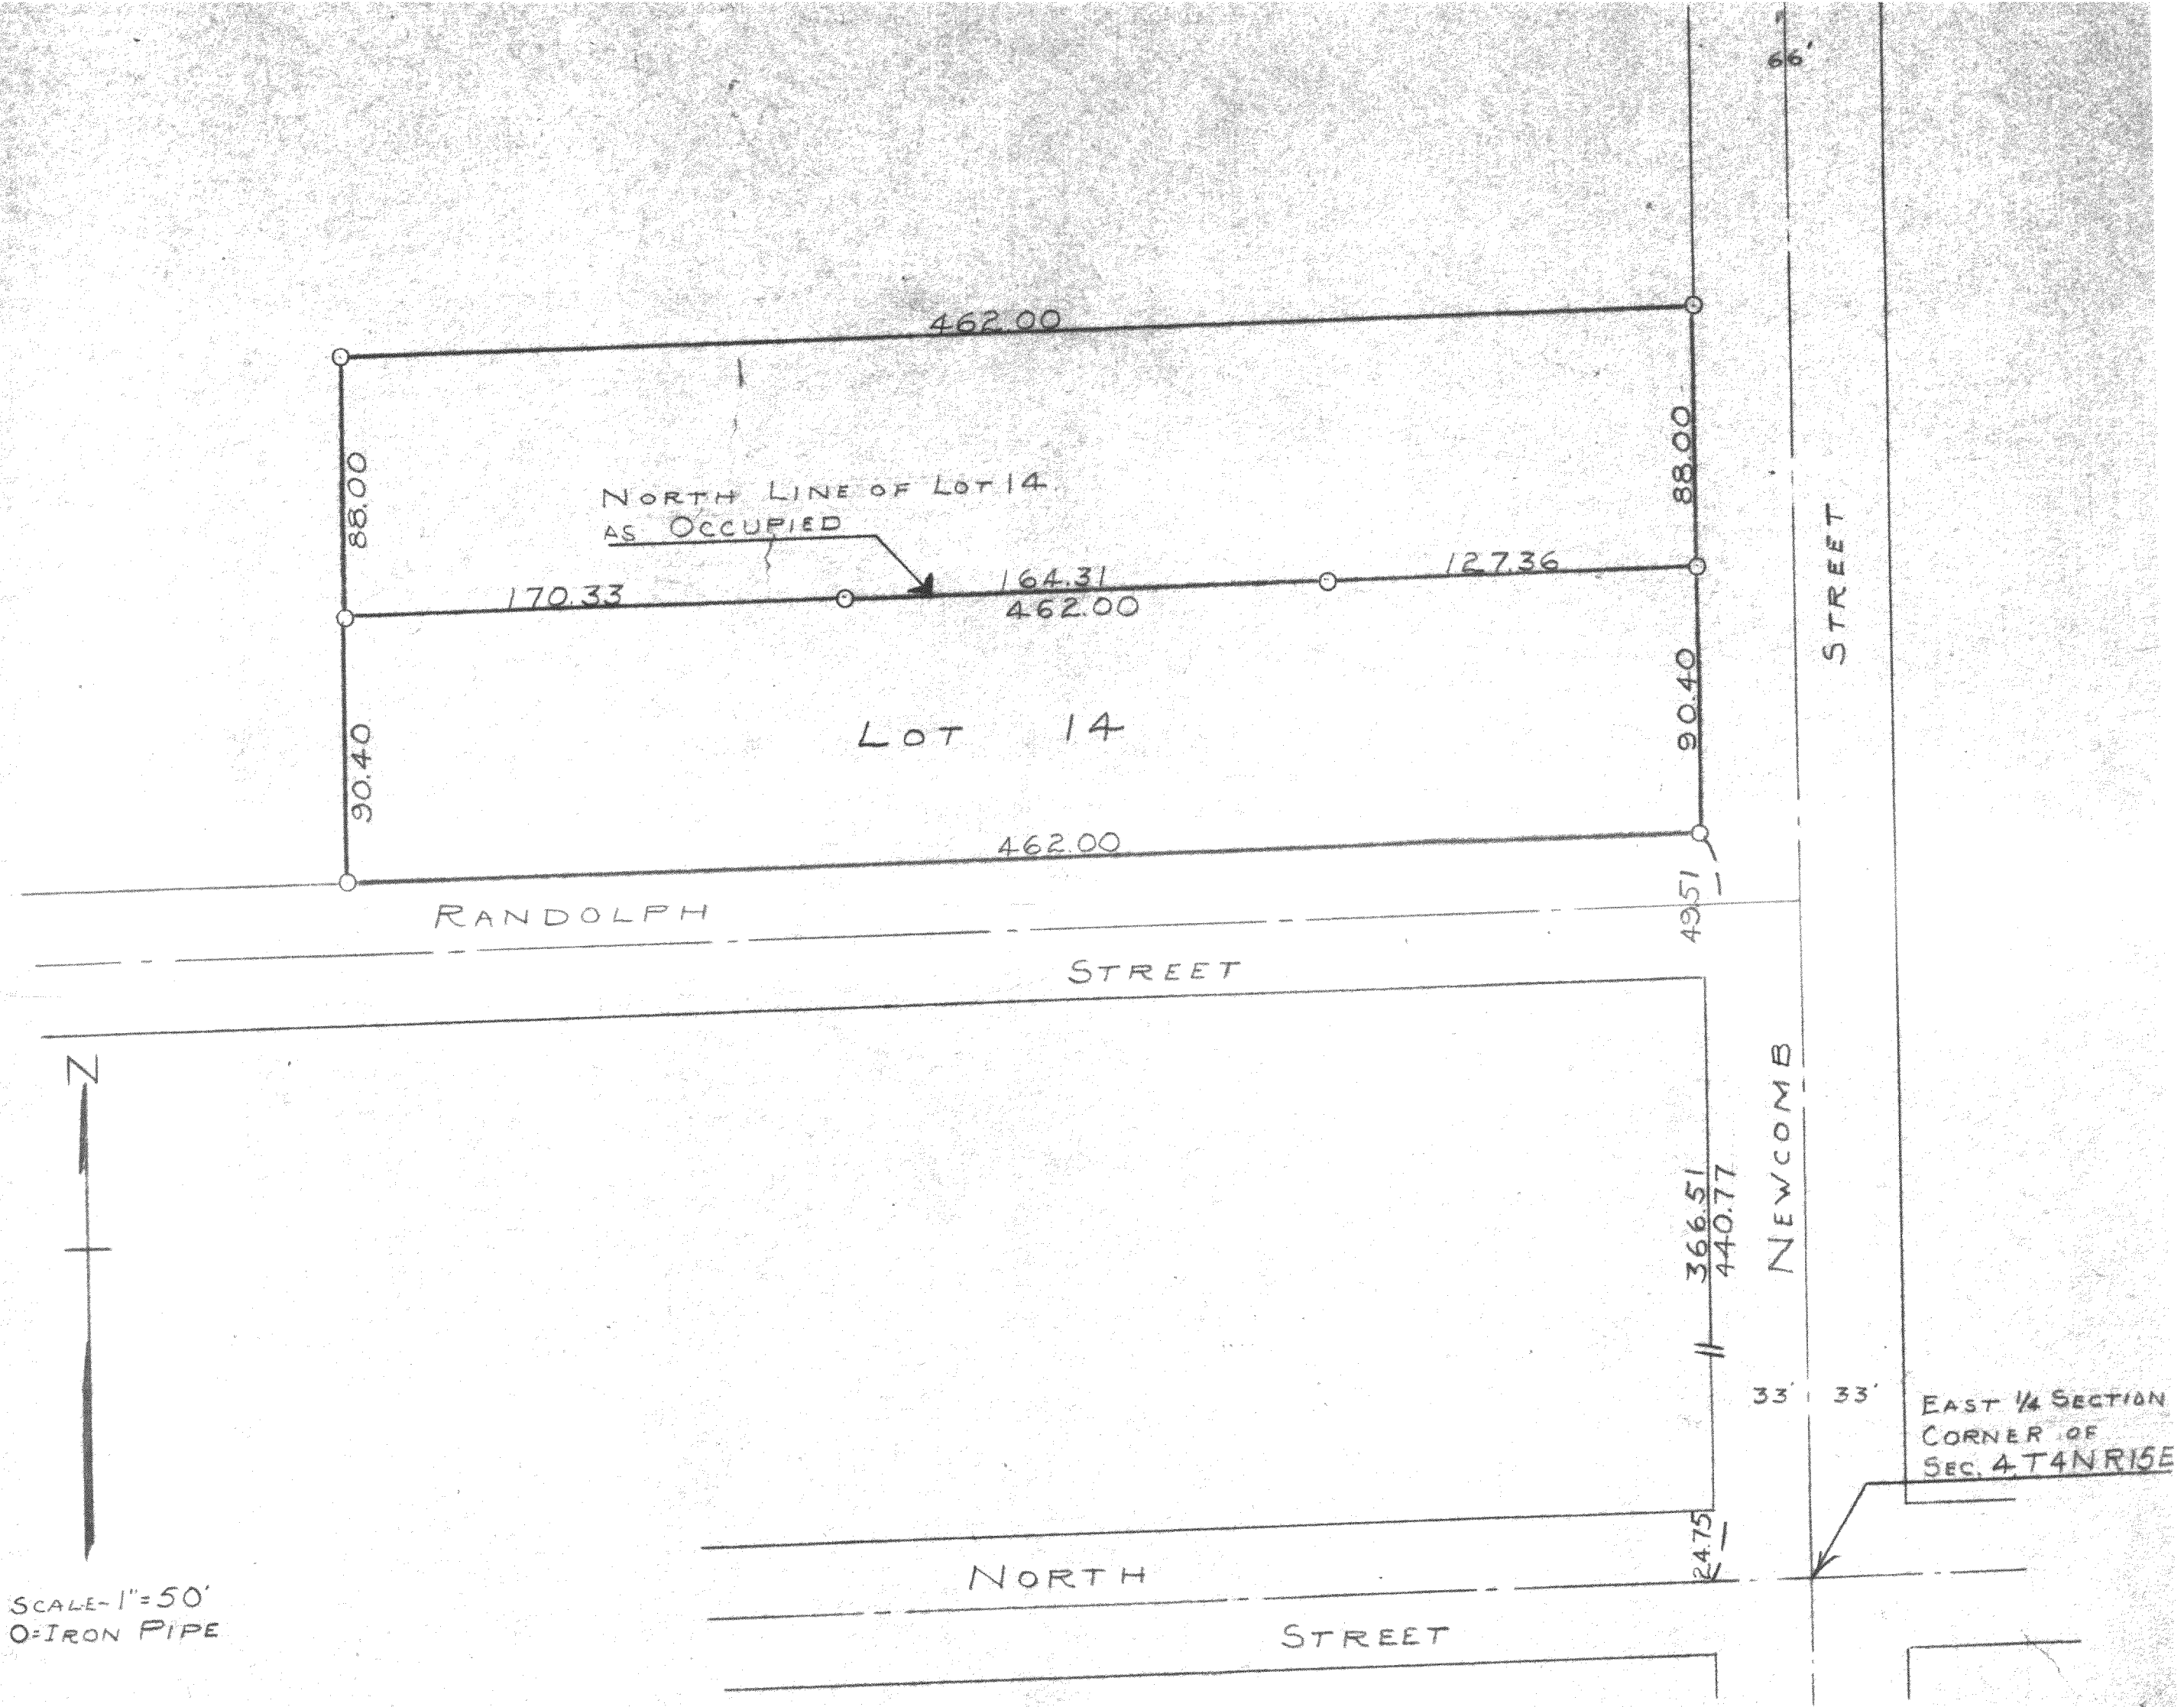

PLAT OF SURVEY OF LOT 14, BELKNAP'S ADDITION AND PARCEL OF LAND NORTH OF LOT 14, LOCATED IN THE CITY OF WHITEWATER, WALWORTH COUNTY, WISCONSIN

NOVEMBER 1950

6535 + 4030

now Cert. Survey 35

Lloyd L. Jensen
COUNTY SURVEYOR

10-71