




1 1/2 30'
PIPE, IRON & O
X IN CONC.

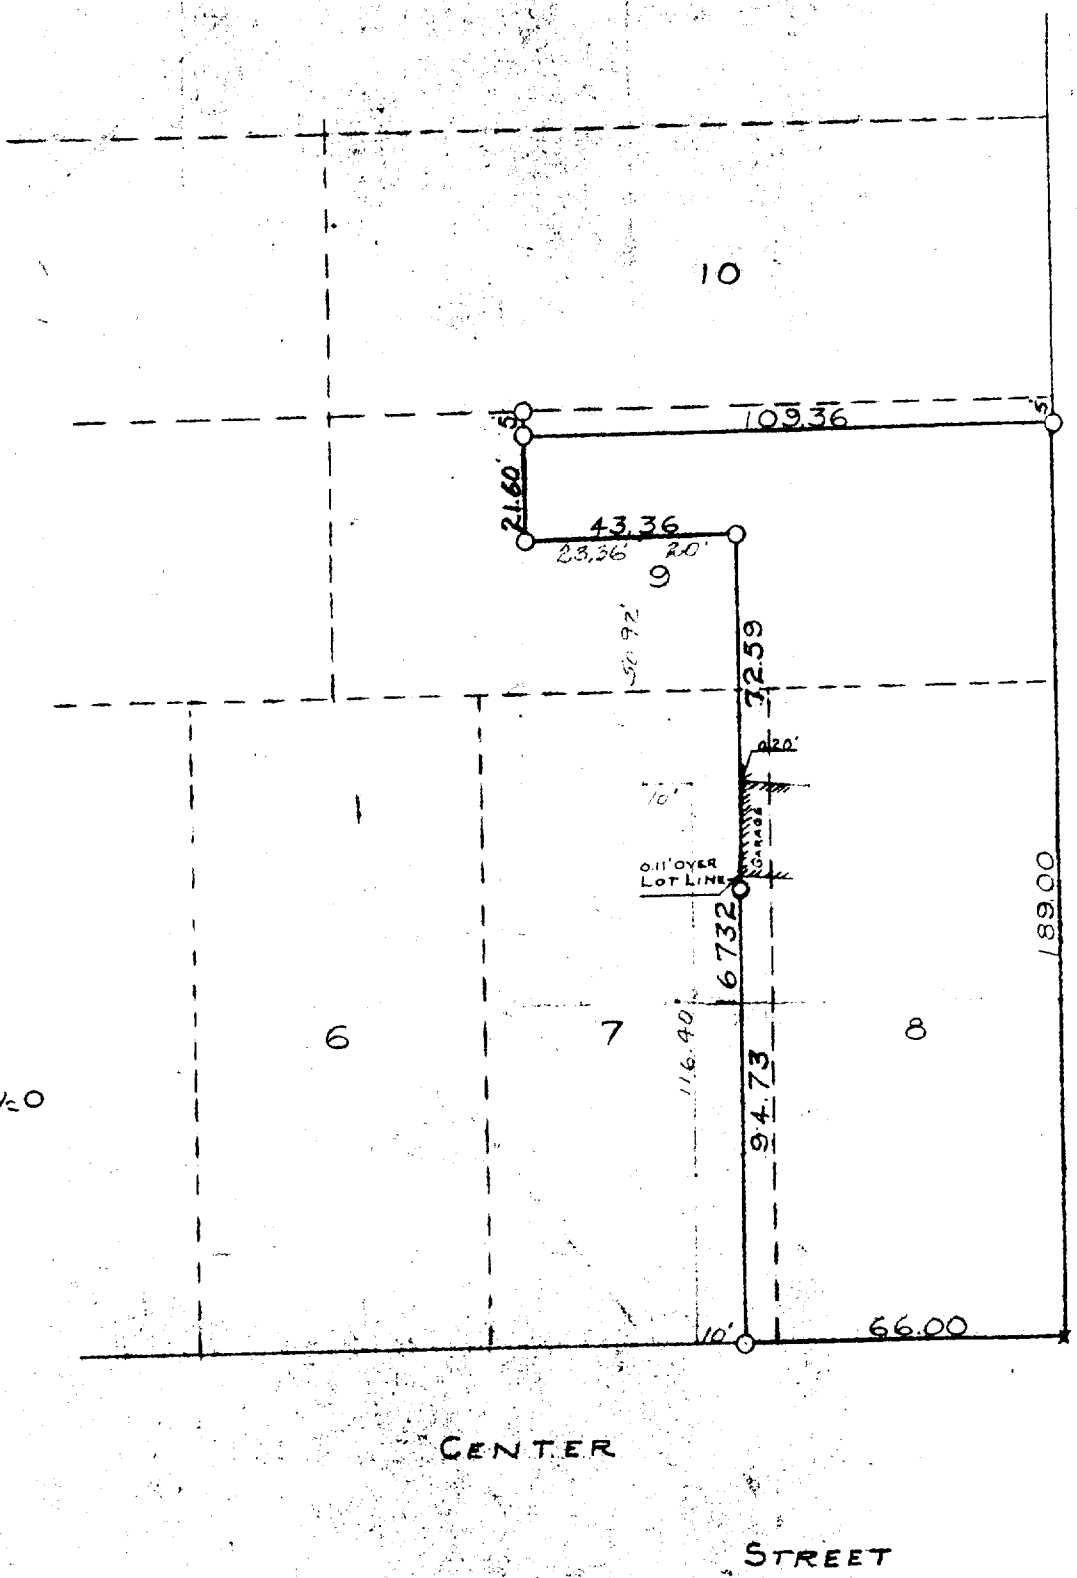


PLAT OF SURVEY OF PART OF LOTS 7, 8, AND 9
BLOCK 17 OF CHAPMAN AND LUDINGTON'S ADDITION
LOCATED IN THE CITY OF WHITEWATER, WALWORTH
COUNTY, WISCONSIN
NOVEMBER 1950

Lloyd L. Fursin



SCALE-1"=30'
O=IRON PIPE
X=CROSS IN CONC.

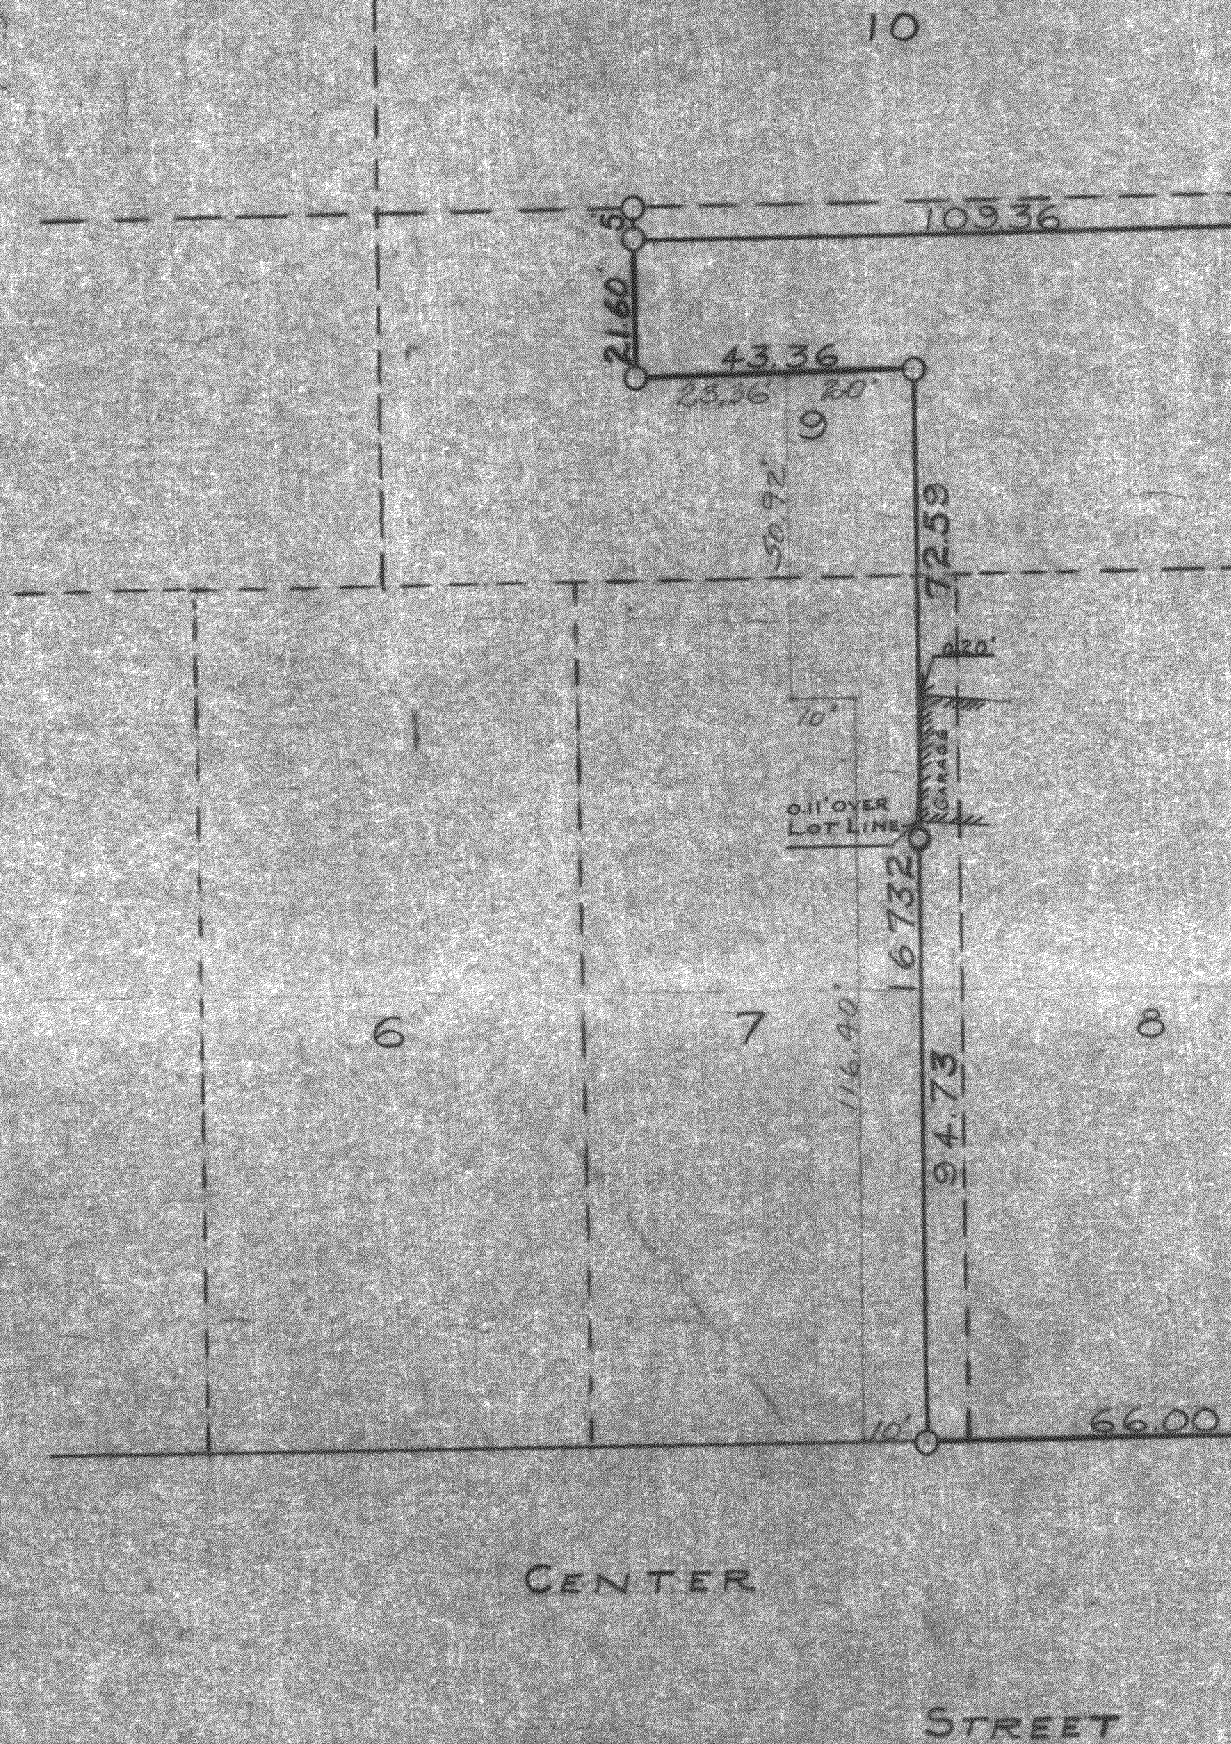

PLAT OF SURVEY OF PART OF LOTS 7, 8,
BLOCK 17 OF CHAPMAN AND LUDINGTONS ADDI
LOCATED IN THE CITY OF WHITEWATER, WALWORT
COUNTY WISCONSIN
NOVEMBER 1950

CL-18

Roy L. Lee
COUNTY SUR