


PLAT OF SURVEY

THE SOUTHEASTERLY 75 FEET OF LOT 1, BLOCK 14, THE SOUTHEASTERLY 75 FEET OF LOT 2, BLOCK 14, THE SOUTHEASTERLY 75 FEET OF THE EASTERLY 22 FEET OF LOT 3, BLOCK 14, ALL IN THE ORIGINAL PLAT OF THE VILLAGE (NOW CITY) OF WHITEWATER, being a part of the Southwest ¼ of Section 4 Town 4 North, Range 15 East, in the City of Whitewater, Walworth County, Wisconsin.

Surveyed for: Ryan Hughes

NOTE: DUE TO LACK OF MONUMENTATION, RETRACEMENT OF A SURVEY PERFORMED OF THE NORTHWESTERLY LINE OF THIS PROPERTY BY RICHARD MAYER ON AUGUST 24, 1964 WAS USED TO PERFORM THIS SURVEY.

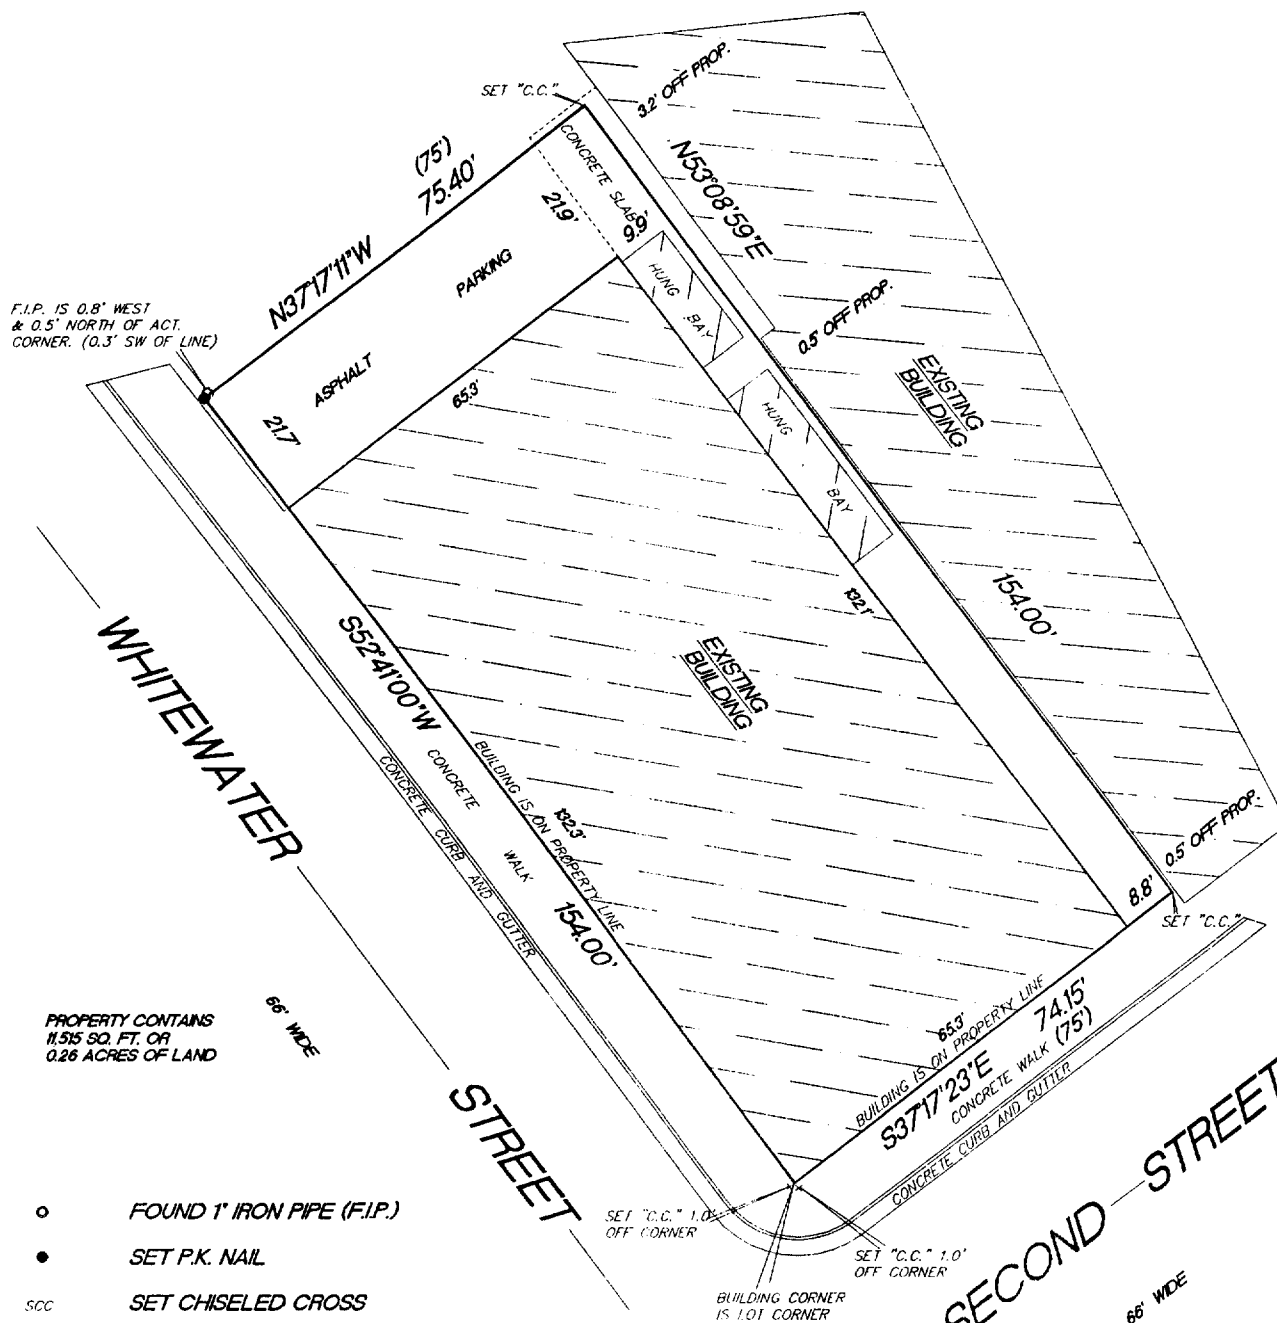


PROPERTY CONTAINS
11,515 SQ. FT. OR
0.26 ACRES OF LAND

- FOUND 1" IRON PIPE (F.I.P.)
- SET P.K. NAIL
- SCC SET CHISELED CROSS
- () RECORDED AS DIMENSIONS

"I hereby certify that I have surveyed the above described property and that the above map is a true representation thereof and shows the size and location of the property, its exterior boundaries, the location of all visible structures and dimension of all principal buildings thereon, boundary fences, apparent easements, roadways and encroachments if any."

"This survey is made for the use of the present owners of the property, and also those who purchase, mortgage or guarantee the title thereto within one year from date hereof."

KETTLE MORaine SURVEYING, INC.
W356 S9050 Godfrey Lane
Eagle Wisconsin 53119
P.O. Box 357
(262) 594-3484
Terrance E. Pisarek R.L.S.

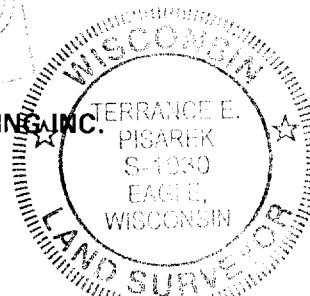

THIS IS NOT AN ORIGINAL SURVEY UNLESS THE SEAL IS RED.

4/20/05
DATE

TEP
FIELD WORK BY

TEP
DRAWN BY

05049
JOB NUMBER

LOT 00144

010-749