


GEORGE T. DUNHAM
SURVEYING & SUBDIVIDING
DELAVER, WISCONSIN

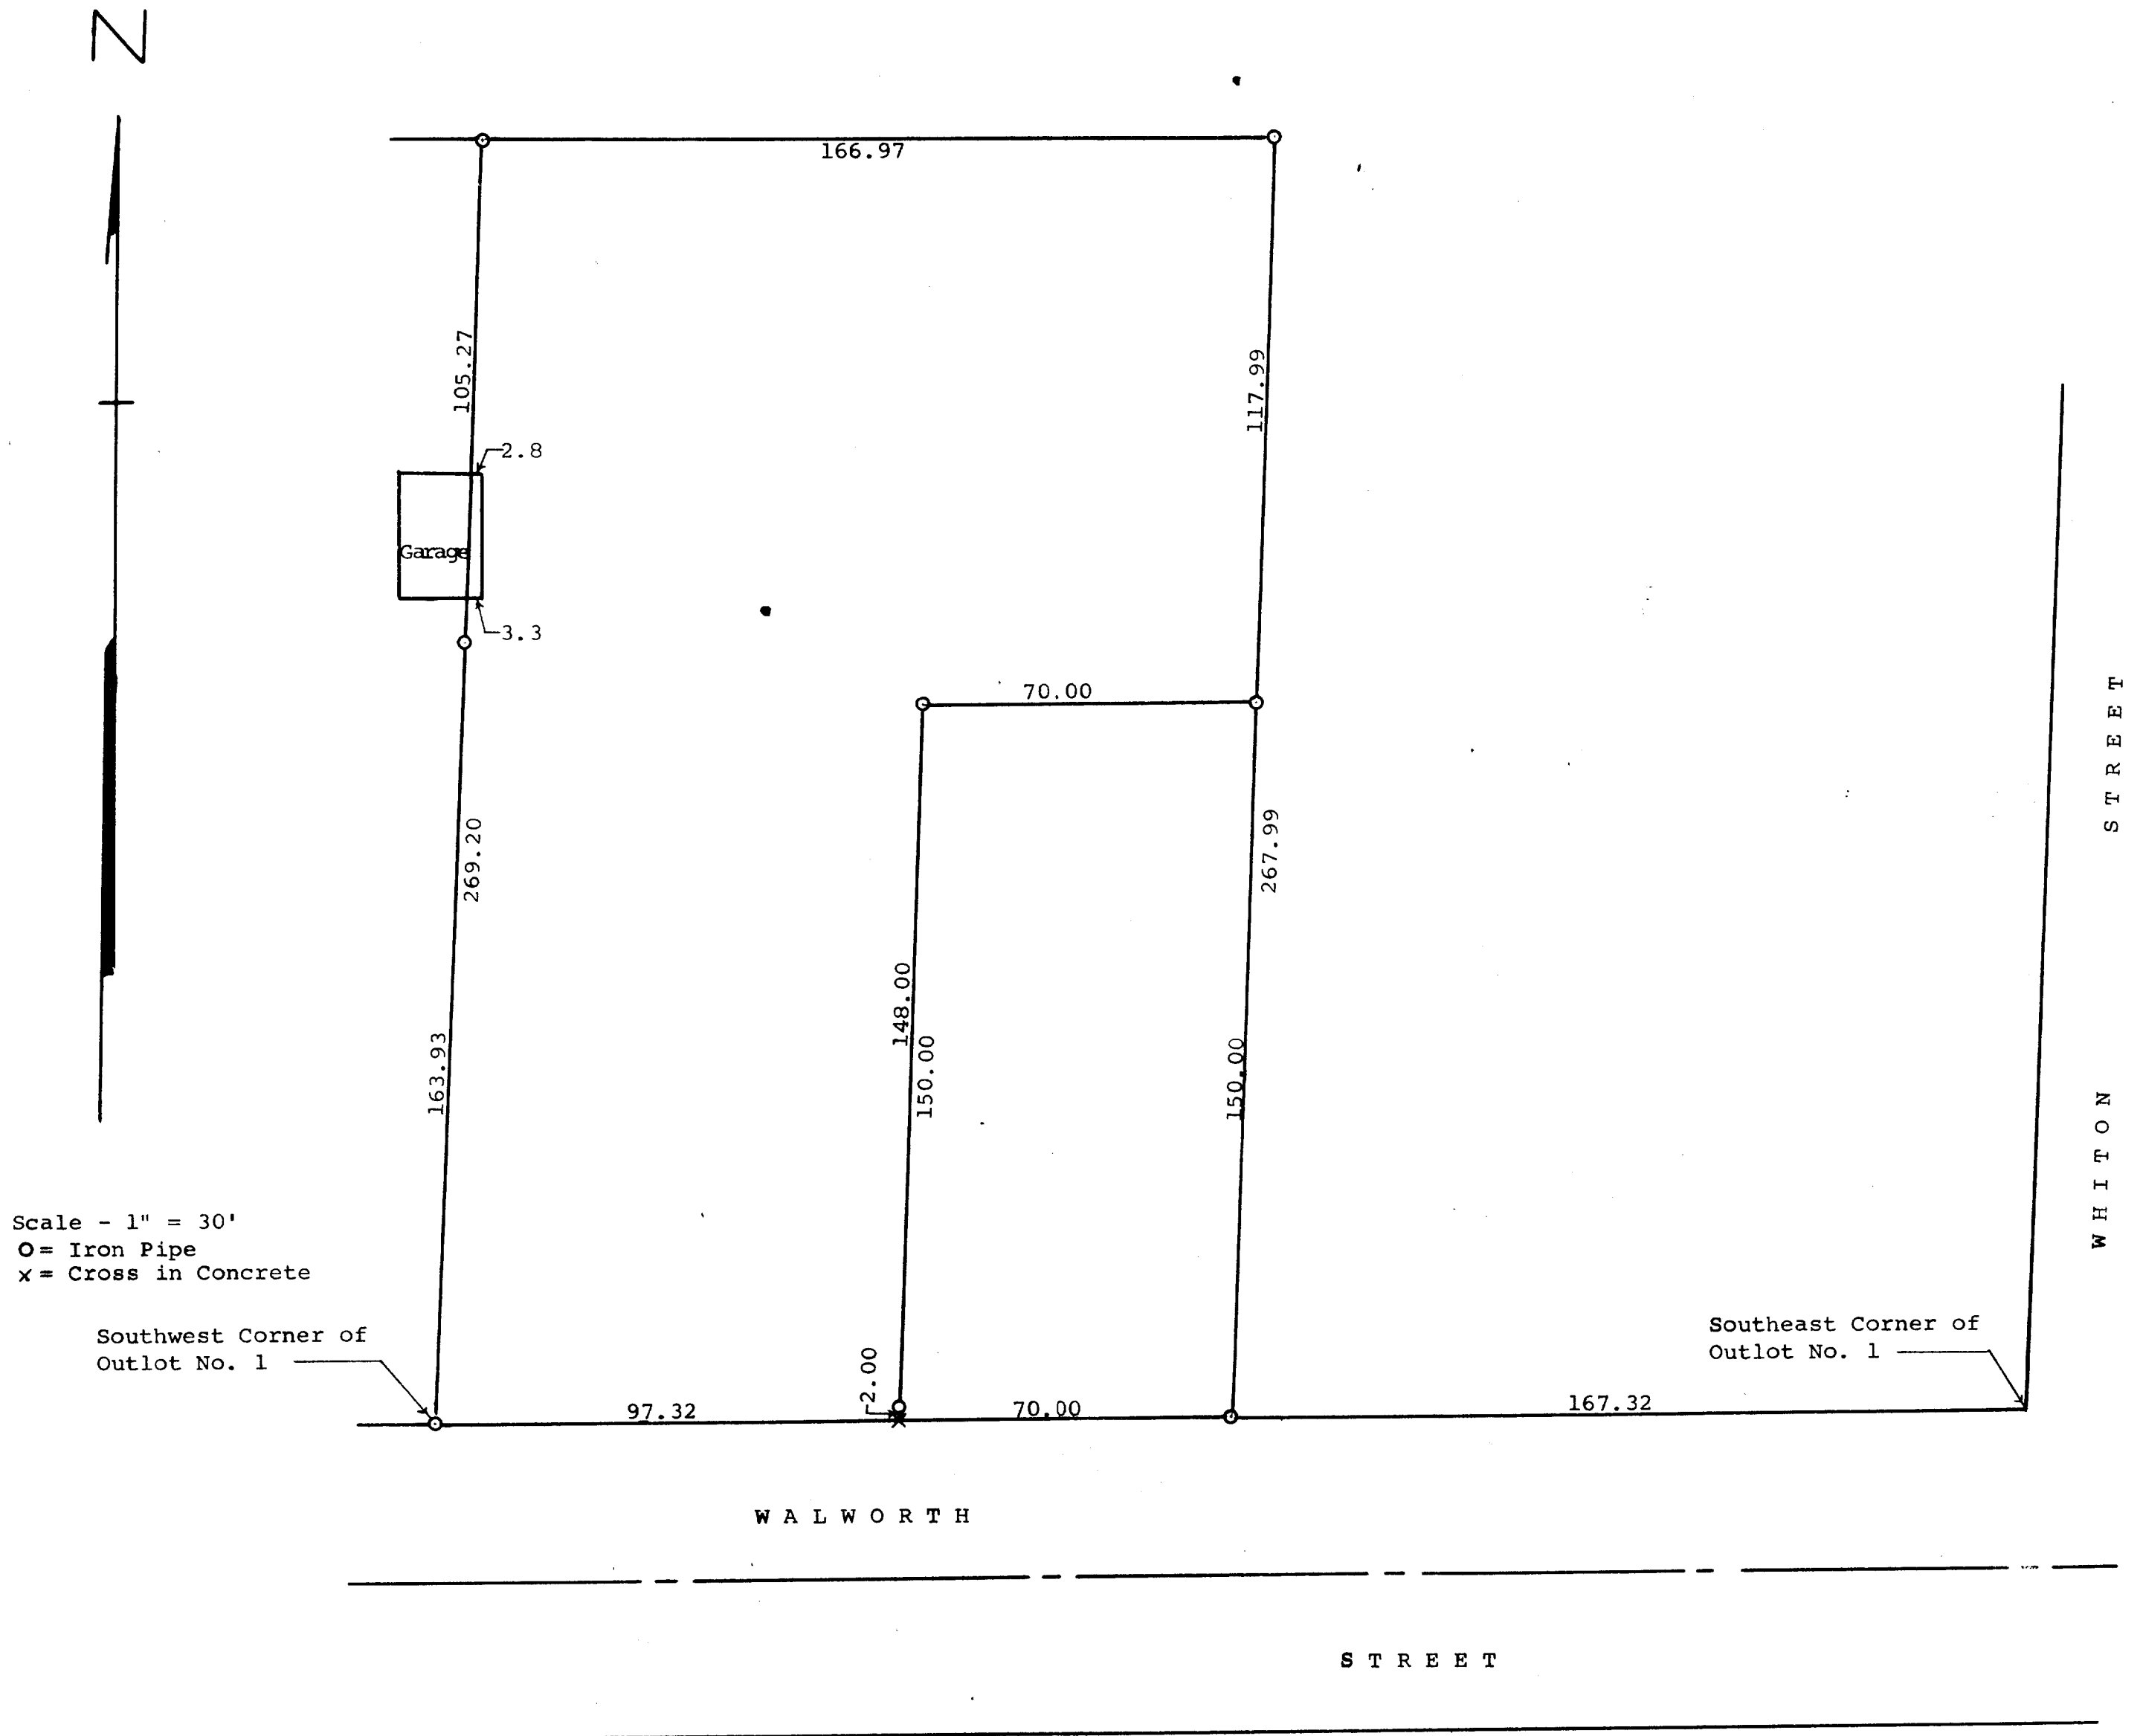

Plat of survey of land located in Outlot No. 1, Birge's Addition
to the City of Whitewater, Walworth County, Wisconsin.
May 28, 1964

George T. Dunham
George T. Dunham, Surveyor