

HOWARD E. HANSEN

Wisconsin Land Surveyor

1632 DOUGLAS AVENUE

RACINE, WISCONSIN

Res. Phone MEIrose 4-0565


Office Phone MEIrose 7-3346

PLAT OF SURVEY

OF PROPERTY OF THRIFTY BUILDERS INC.

described as follows: PART OF THE S. $\frac{1}{2}$ OF THE N.W. $\frac{1}{4}$ OF SEC. 5, T4N

4 N. R. 15 E., CITY OF WHITEWATER, WALWORTH CO., WIS.

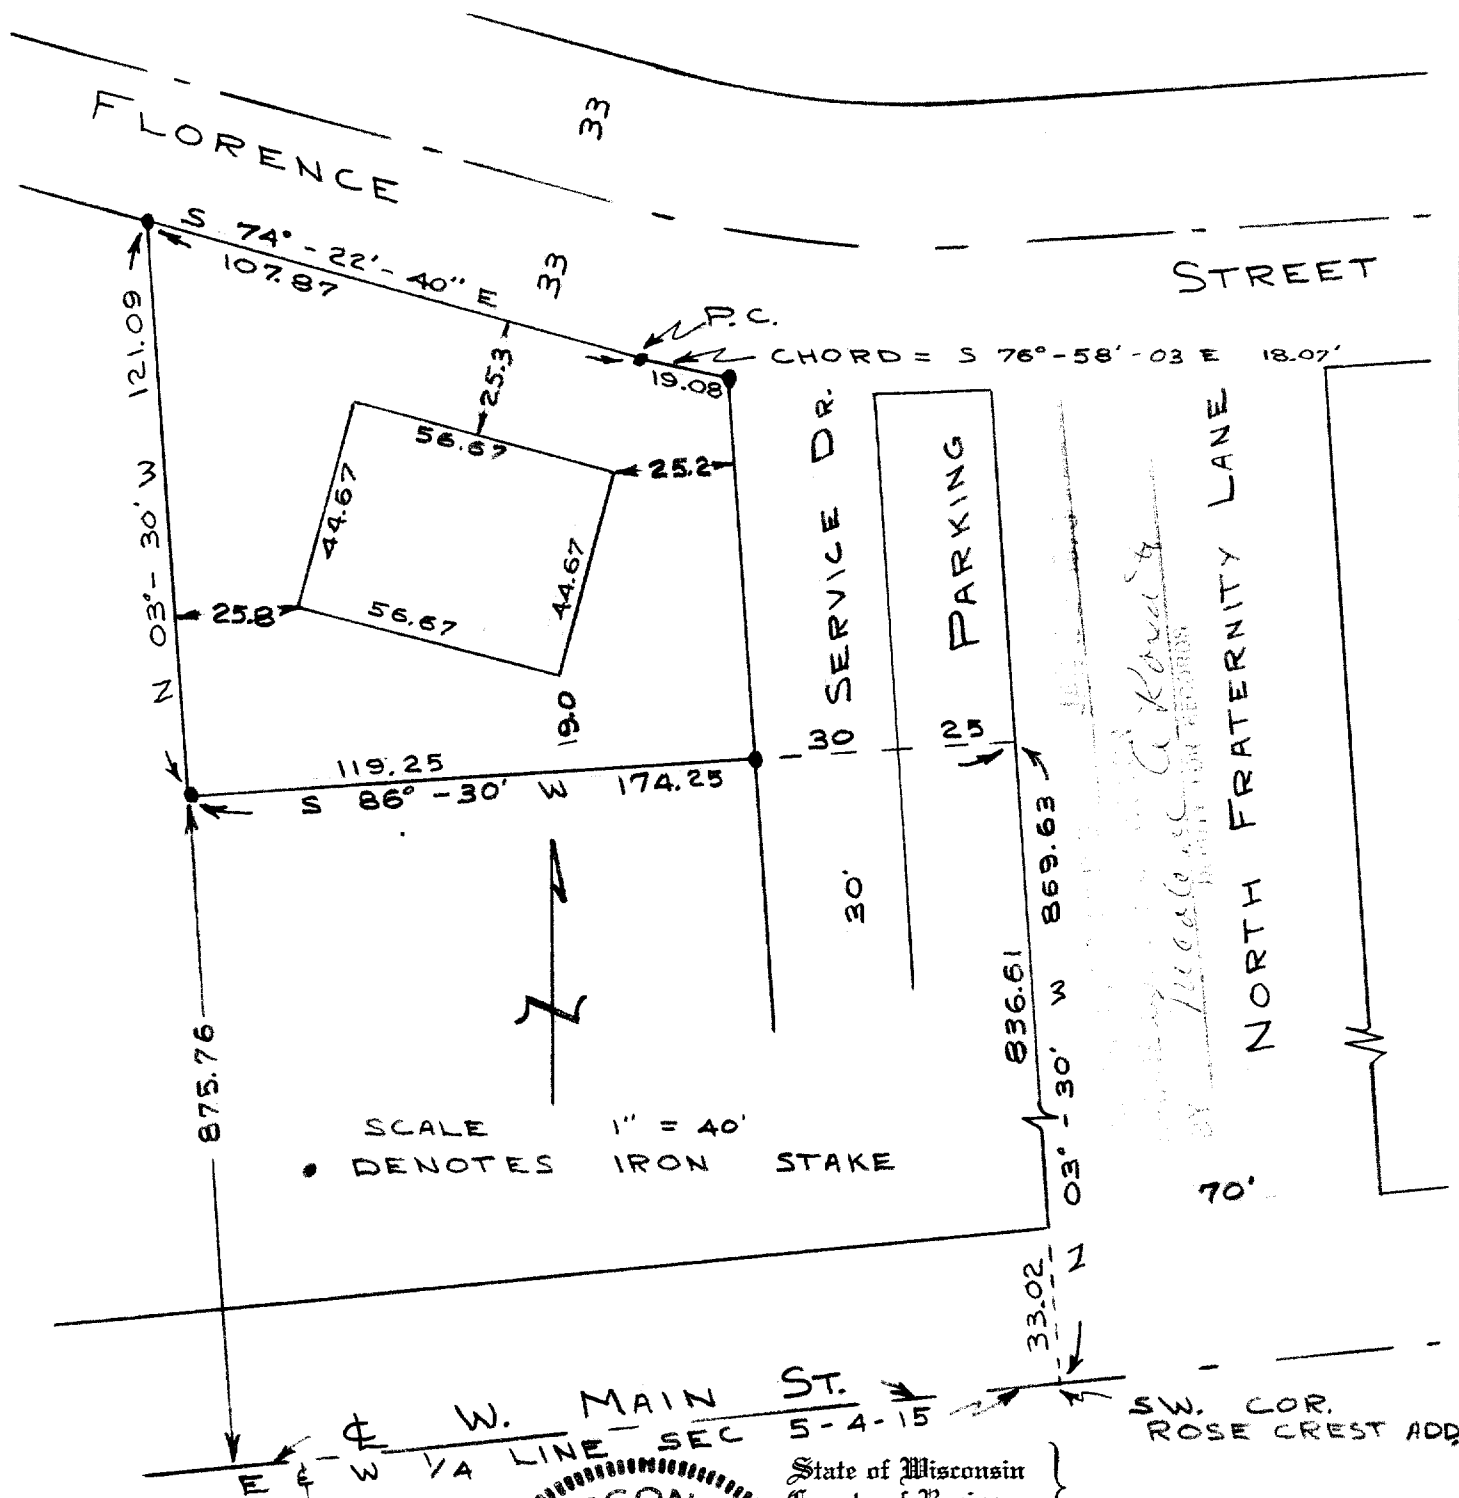

State of Wisconsin
County of Racine

I, H. E. HANSEN, do hereby certify that I have surveyed the property described above according to official records, and that the plat above drawn is a correct representation of said survey.

Racine, Wis., 1/17, 1961

Howard E. Hansen

RACINE COUNTY CLERK FILE NO. 4039

010-780