


CENTER STREET

LOT 2-BLOCK 22 OF CHAPMAN & LUDINGTON'S ADDITION

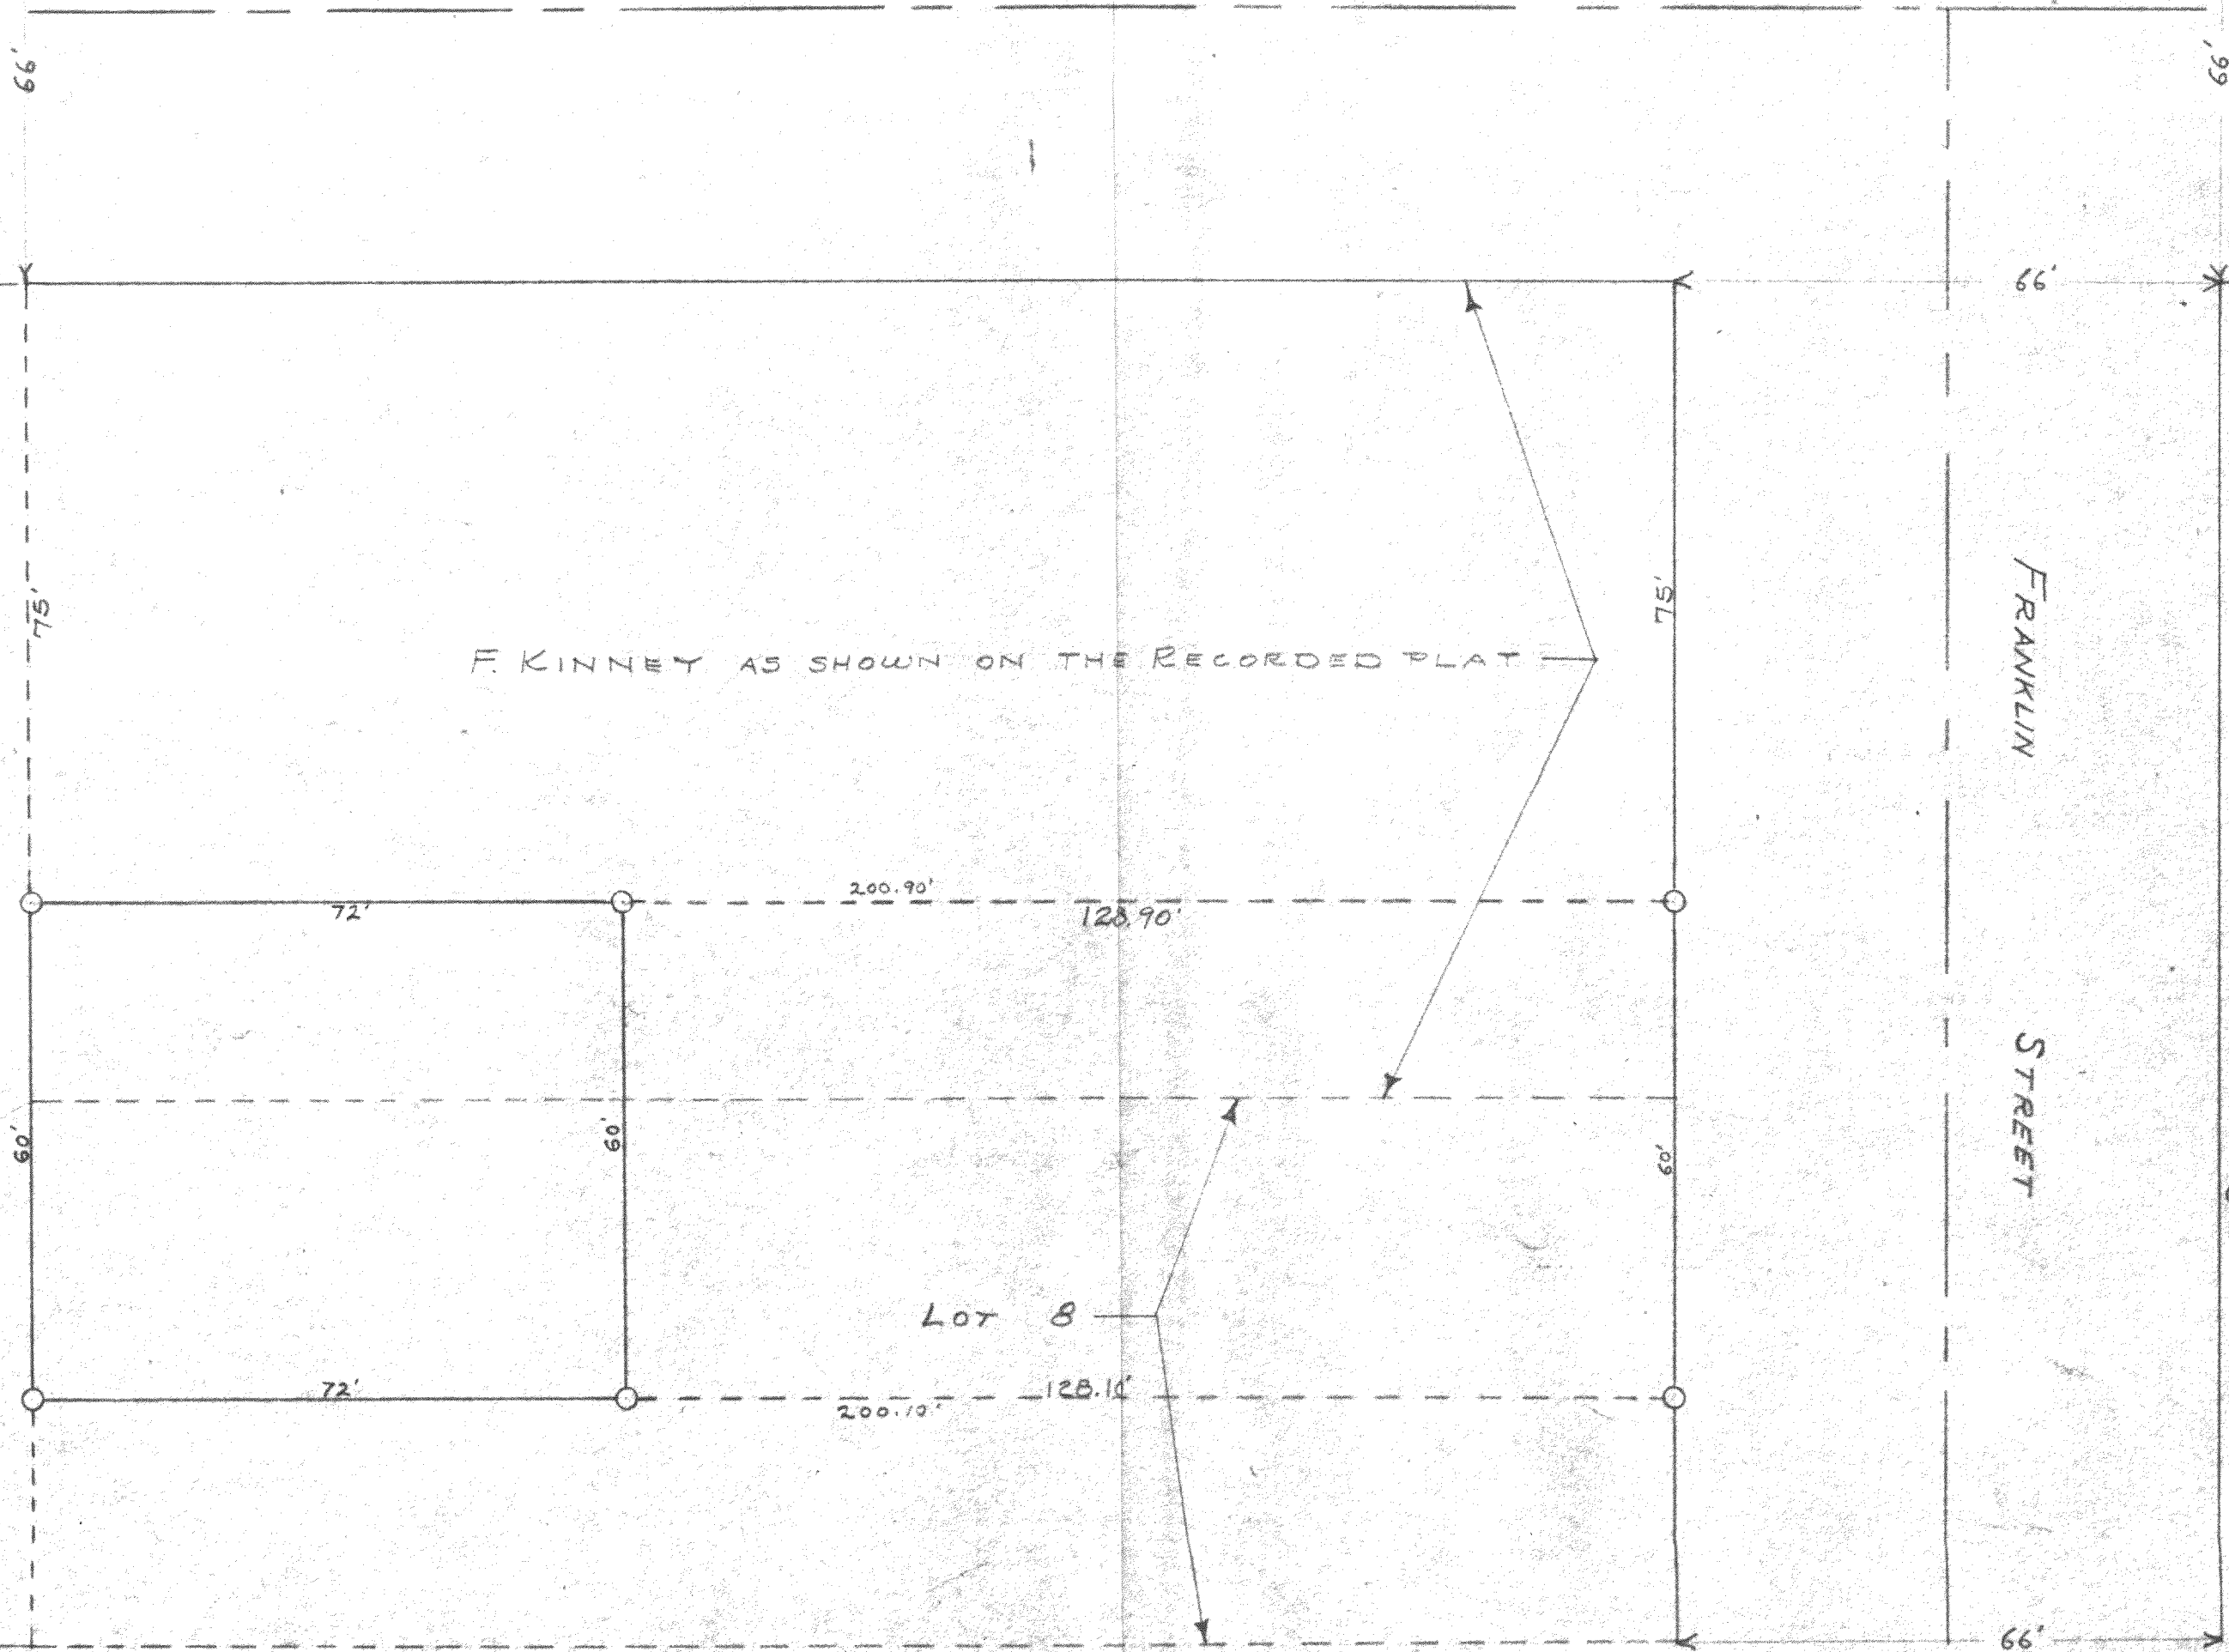

PLAT OF SURVEY OF PART OF LOT 8 OF
BLOCK 22 CHAPMAN + LUDINGTONS ADDITION
IN THE CITY OF WHITEWATER WALWORTH
COUNTY, WISCONSIN, AND PART OF THE F. KINNEY LOT,
SEPTEMBER 20, 1951

Roy L. Jensen
WALWORTH COUNTY SURVEYOR