

LAND-MARK SURVEYING
Mark L. Miritz

Wisconsin Registered Land Surveyor S-2582




N9330 Knuteson Drive
Whitewater, WI 53190
Phone: (262) 495-3284
FAX : (262) 495-8421
LAND-MARKSURVEYING.COM

PLAT OF SURVEY

**LOTS 4 AND 5 OF BLOCK 5 OF TRIPP ADDITION
TO THE VILLAGE (NOW CITY) CITY OF WHITEWATER,
WALWORTH COUNTY, WISCONSIN**

**OWNERS: DALE N. STETTLER TRUST
GAYLE M. STETTLER TRUST
104 BROADWAY ST.
EDGERTON, WI. 53534**

**SUBJECT PROPERTY ADDRESS: 327 WEST ANN ST.
WHITEWATER, WI. 53190**

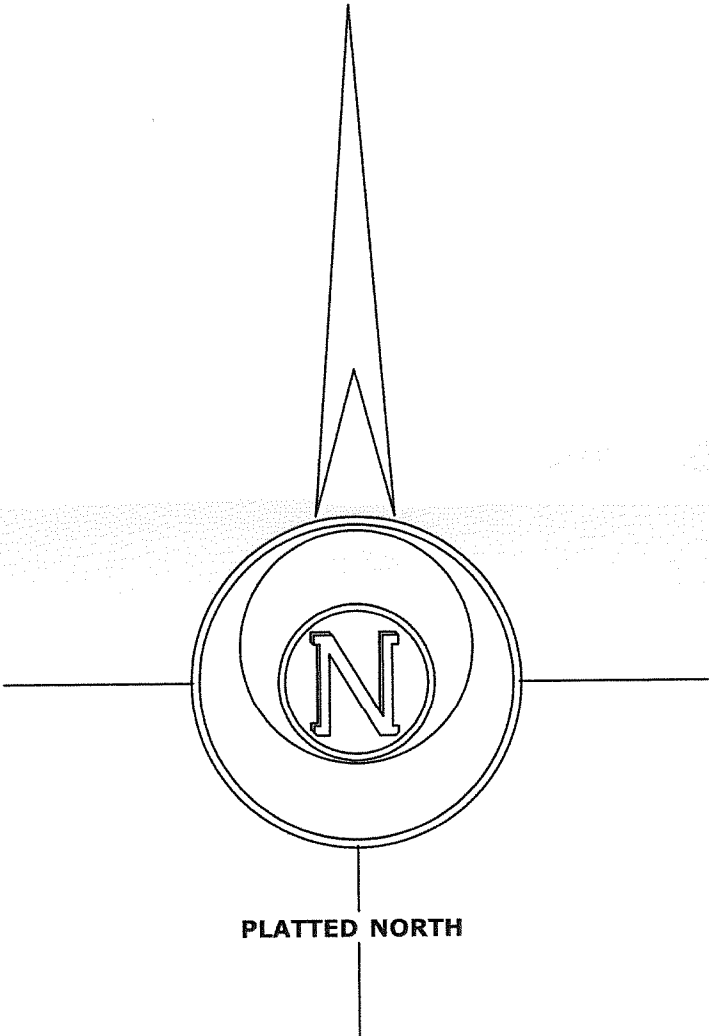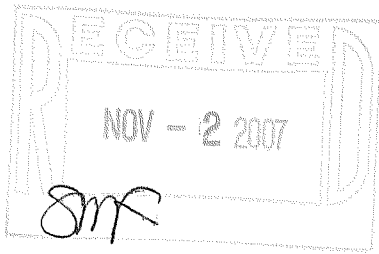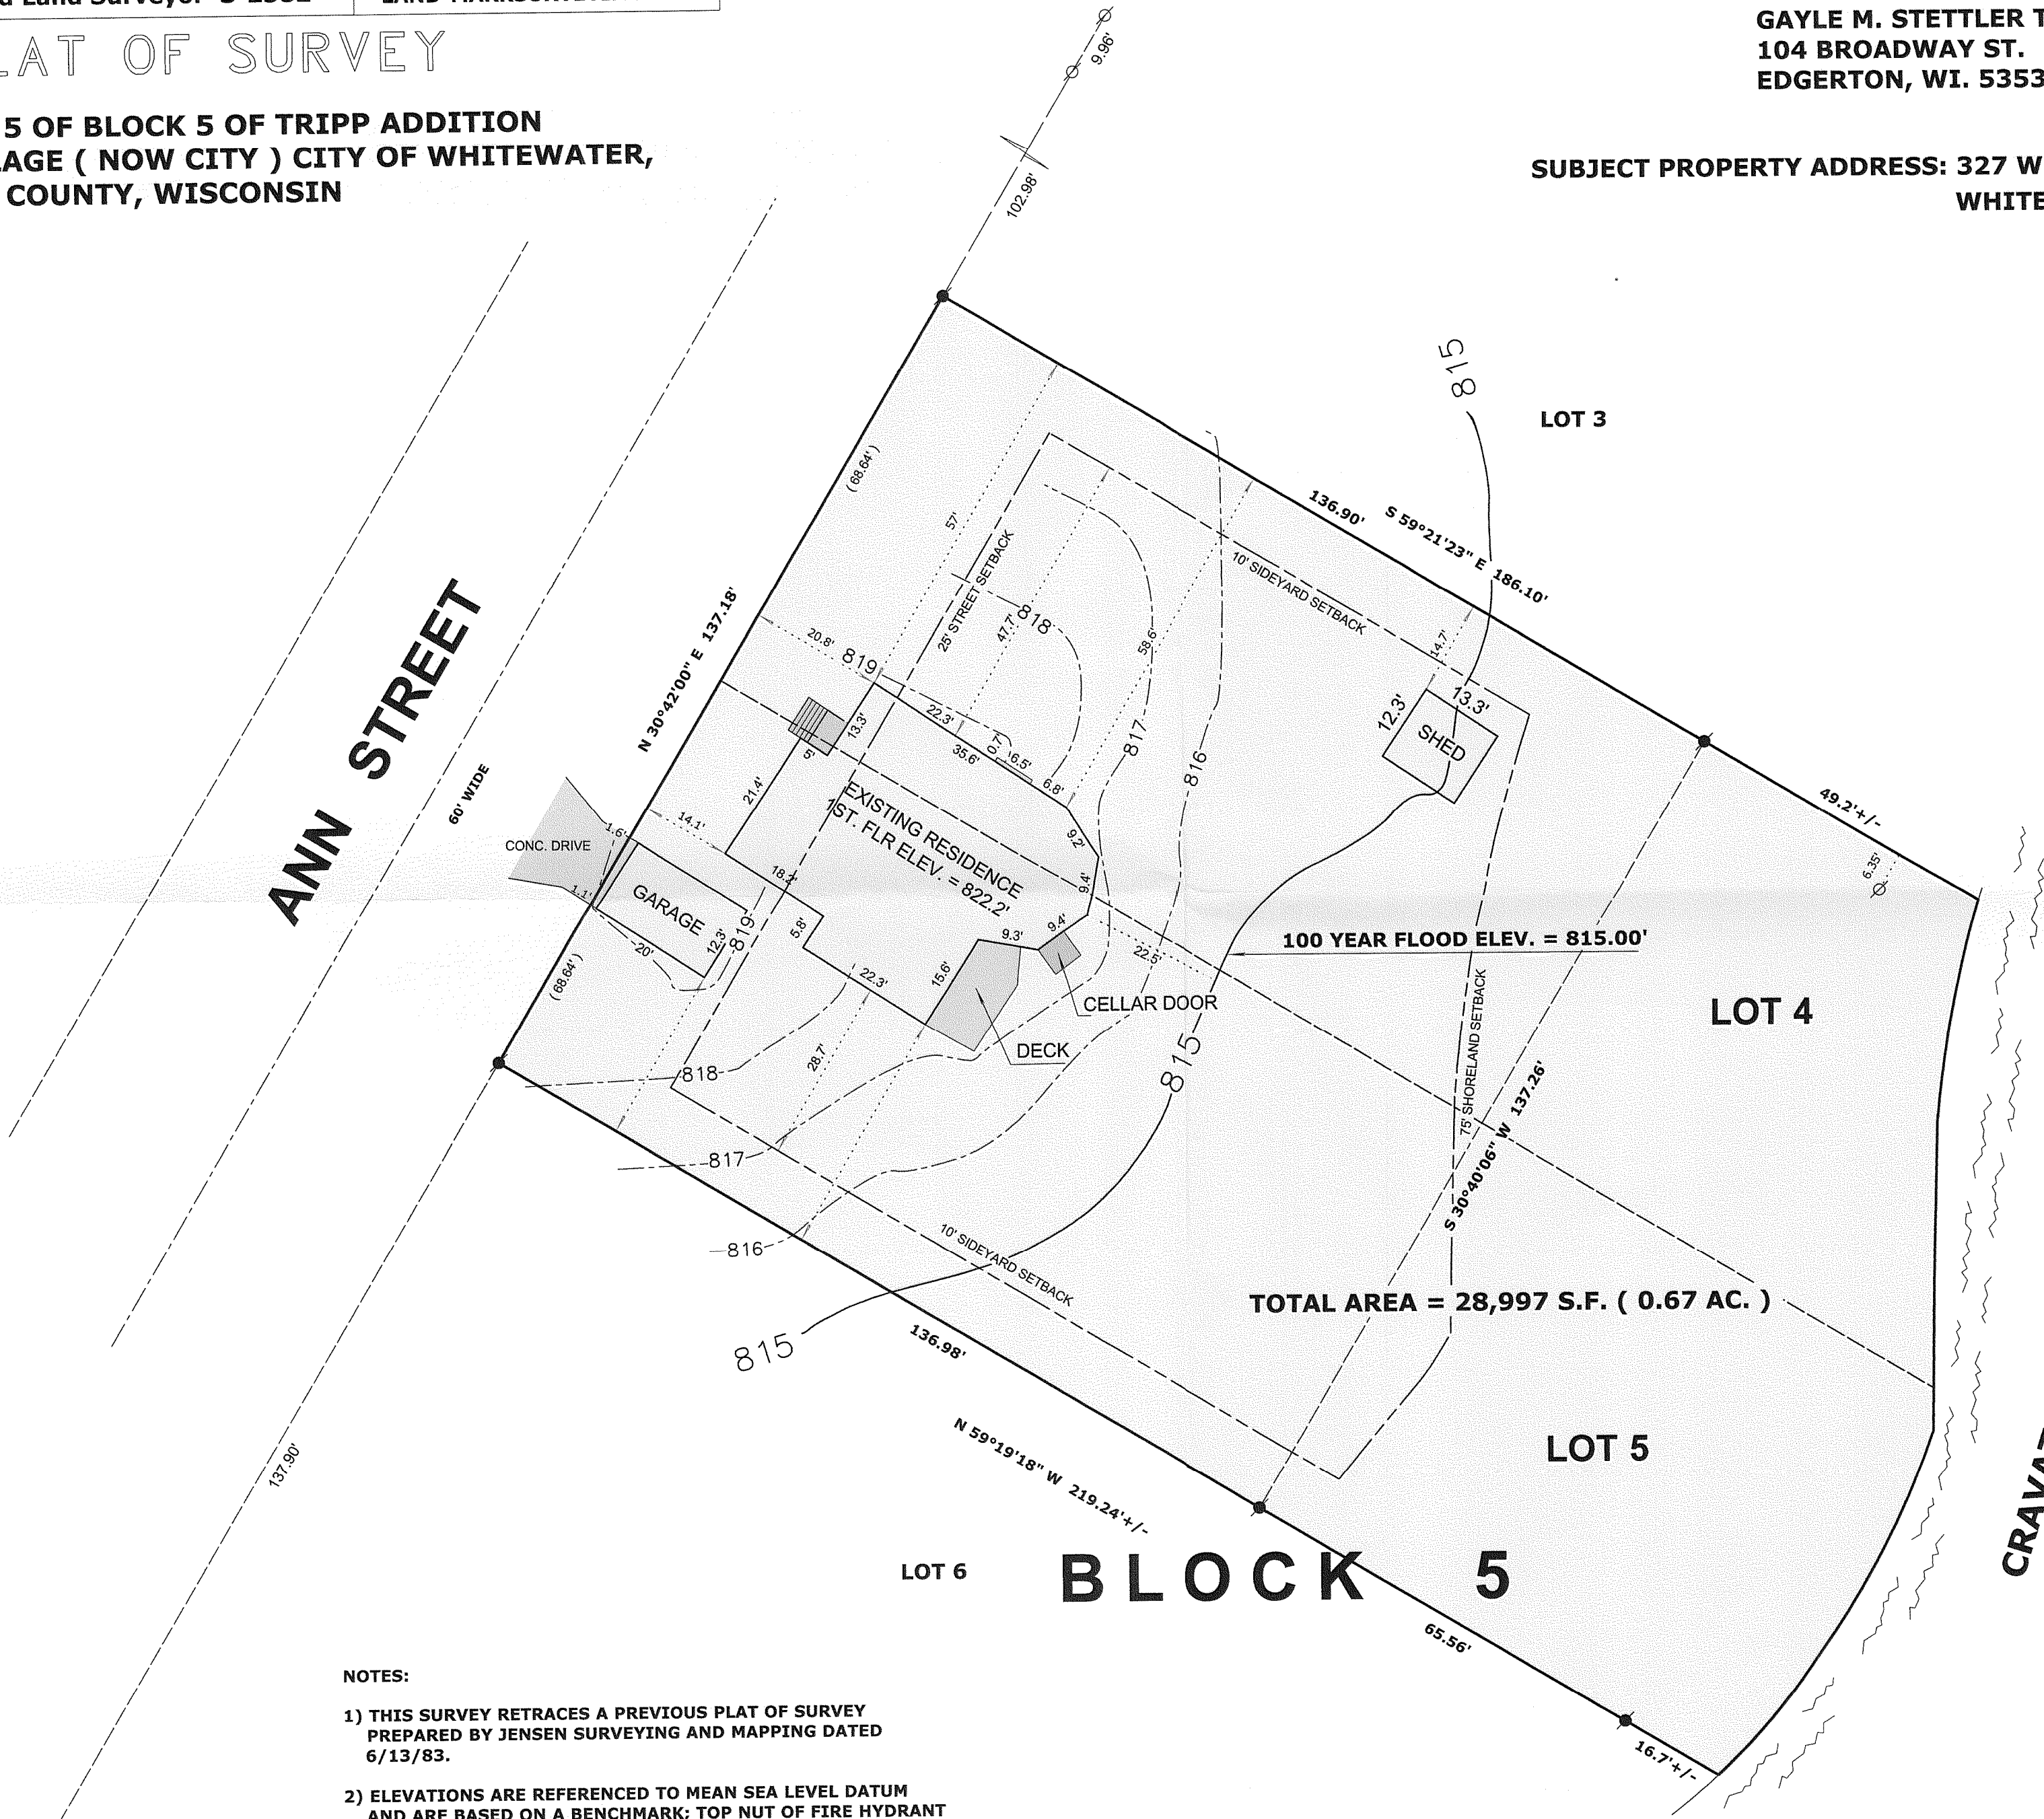

LEGEND

- FOUND IRON PIPE
- FOUND IRON ROD
- FOUND COUNTY MONUMENT
- FOUND CONCRETE MONUMENT
- CHISEL CUT IN CONCRETE
- SET IRON ROD, 24" LONG, WEIGHING 1.5 LBS./LINEAL FT., 3/4" DIA.
- RECORDED AS DIMENSION
- EXISTING FENCE

SCALE: 1" = 20 FEET

"I hereby certify that the above described property has been surveyed by me or under my direction and that the above map is a true representation thereof and shows the size and location of the property, its exterior boundaries, the location of all visible structures and dimensions of all principal buildings thereon, boundary fences, apparent easements, roadways and visible encroachments, if any."
"This survey is made for the use of the present owners of the property, and also those who purchase, mortgage, or guarantee the title thereto within one year from date hereof."

Mark L. Miritz
**MARK L. MIRITZ
S-2582
LAND SURVEYOR S-2582
DATE: OCT. 24, 2007 JOB NO. 07.1005**



NOTES:

- 1) THIS SURVEY RETRACES A PREVIOUS PLAT OF SURVEY PREPARED BY JENSEN SURVEYING AND MAPPING DATED 6/13/83.
- 2) ELEVATIONS ARE REFERENCED TO MEAN SEA LEVEL DATUM AND ARE BASED ON A BENCHMARK; TOP NUT OF FIRE HYDRANT AT CORNER OF FREMONT AND WHITEWATER ELEV. = 825.96'
- 3) 100 YEAR FLOOD ELEVATION OF 815.0' FROM FEMA MAP PANEL NO. 550200 004 B - ZONE A4