



PLAT OF SURVEY
LOT 40 IN HANFORD A. CONGER'S SUBDIVISION OF BLOCK 6 OF BIRGE'S ADDITION TO THE VILLAGE NOW
CITY OF WHITEWATER, Walworth County, Wisconsin.

Surveyed for: Murn and Martin S.C.

Survey Address: 936 Highland Street

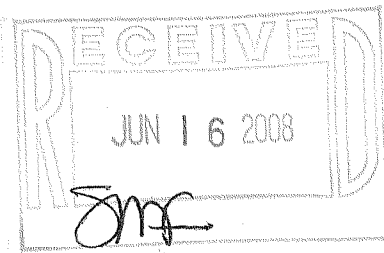

SCALE 1"=30'

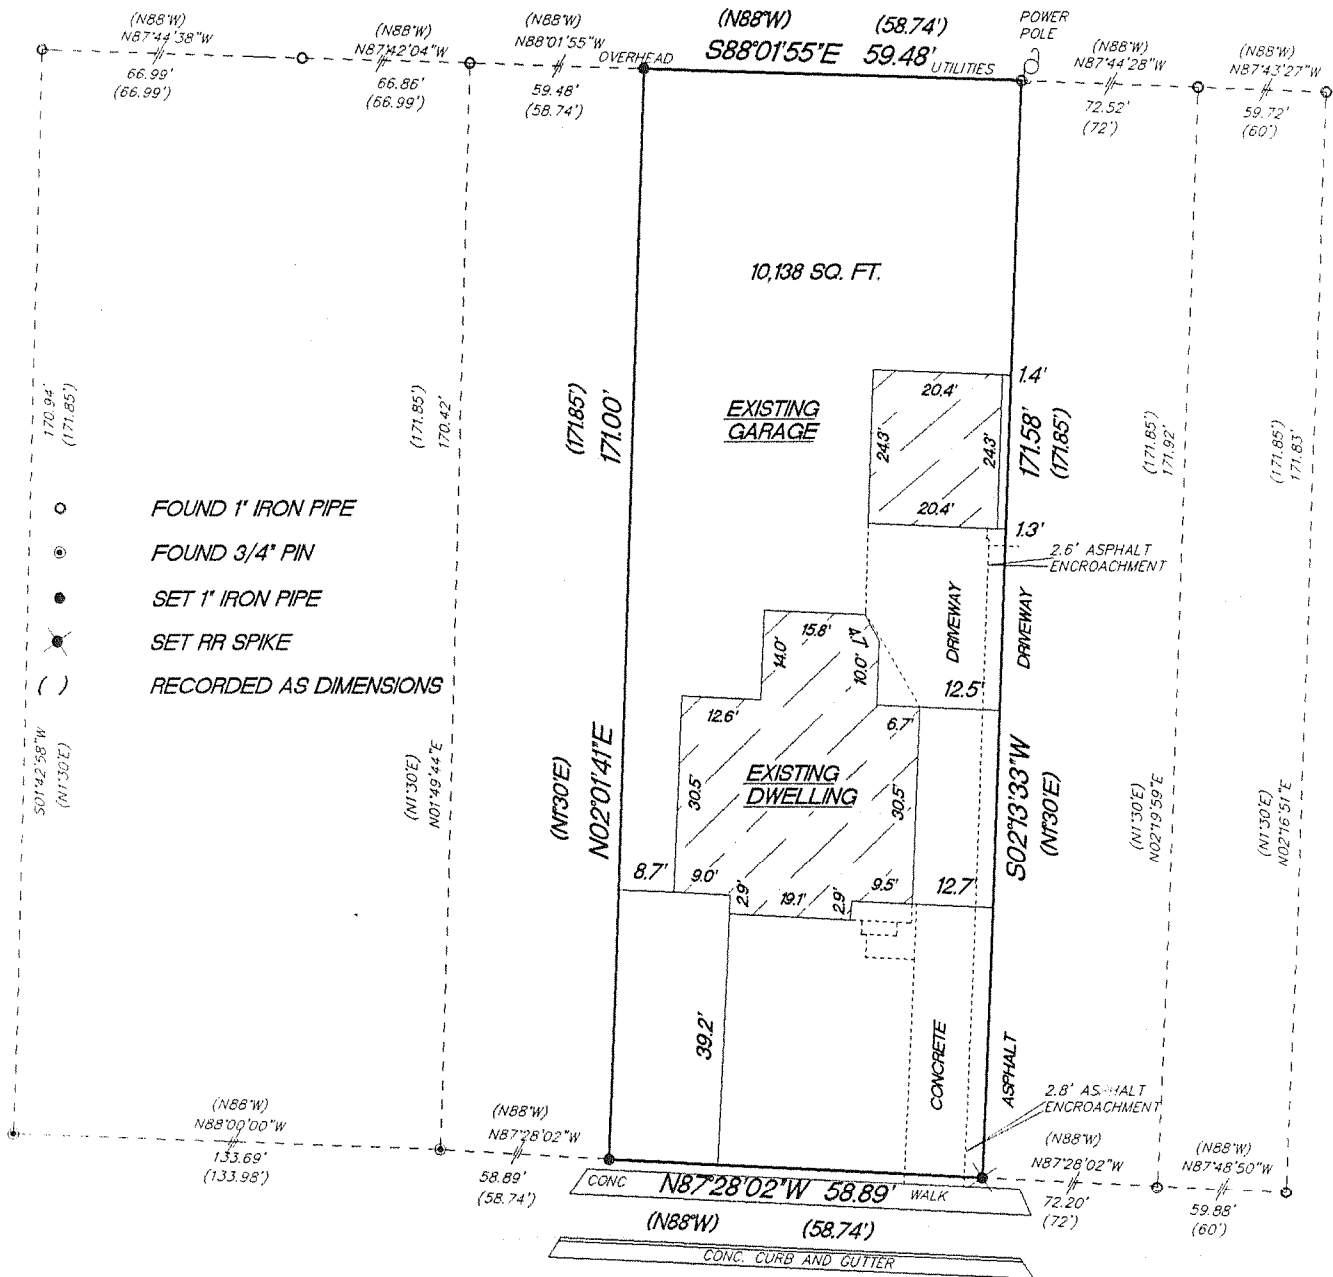

HIGHLAND STREET


60' WIDE

"I hereby certify that I have surveyed the above described property and that the above map is a true representation thereof and shows the size and location of the property, its exterior boundaries, the location of all visible structures and dimension of all principal buildings thereon, boundary fences, apparent easements, roadways and encroachments if any."

"This survey is made for the use of the present owners of the property, and also those who purchase, mortgage or guarantee the title thereto within one year from date hereof."

KETTLE MORaine SURVEYING INC.
575 W36245 Wilton Road
Eagle Wisconsin 53119
P.O. Box 357
(262) 594-3484

Terrance E. Pisarek R.L.S.

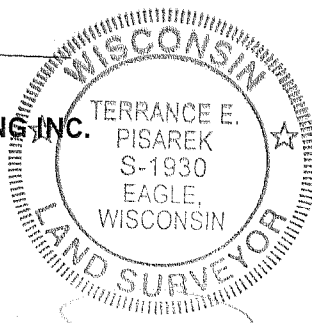

THIS IS NOT AN ORIGINAL SURVEY UNLESS THE SEAL IS RED.

5/9/08

DATE

TEP

FIELD WORK BY

TEP

DRAWN BY

08033

JOB NUMBER

1CON-28A

010-850