

GEORGE T. DUNHAM
SURVEYING & SUBDIVIDING
DELAVER, WISCONSIN




Scale - 1" = 20'

● = Iron Pipe or Stake

X = Cross in Concrete

QUEEN STREET

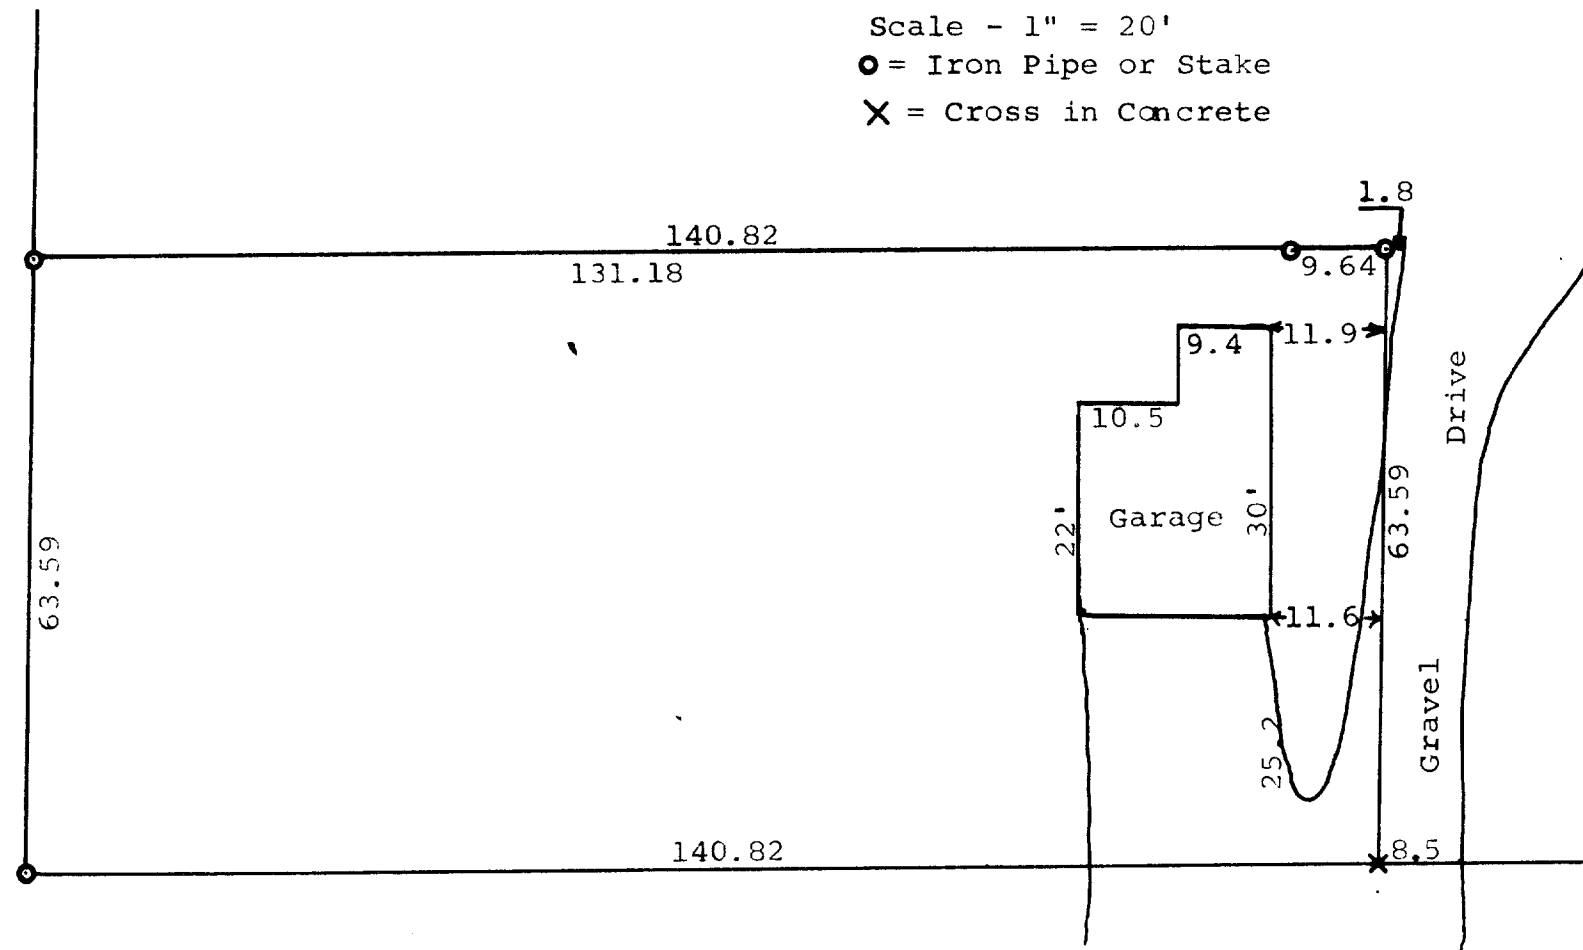

NORTH

STREET

Plat of survey of the South $\frac{1}{2}$ of the West $\frac{1}{2}$ of Lot 7,
Block 2, Corydon Pratts Addition to the Village (now City)
of Whitewater, Walworth County, Wisconsin.
December 31, 1965

George T. Dunham
George T. Dunham, Surveyor

10-88

PC-19