


PLAT OF SURVEY

FOR THE WEST HALF OF LOT 9, THE EAST HALF OF LOT 10 AND THE NORTH HALF OF THE WEST HALF OF LOT 10, ALL IN BLOCK 1, OF "S. C. HALL'S ADDITION TO THE VILLAGE OF WHITEWATER", AND BEING A PART OF THE NW 1/4 OF THE SOUTHWEST QUARTER OF SECTION 3, TOWN 4 NORTH, RANGE 15 EAST, CITY OF WHITEWATER, WALWORTH COUNTY, WISCONSIN.

SURVEYOR'S DESCRIPTION:
COMMENCING AT THE NORTHEAST CORNER OF SAID BLOCK 1; THENCE NORTH 86°-17'-45" WEST, ALONG THE NORTH LINE OF SAID BLOCK, 150.01 FEET TO THE POINT OF BEGINNING OF THE PARCEL HEREINAFTER DESCRIBED; THENCE CONTINUING NORTH 86°-17'-45" WEST, ALONG SAID NORTH LINE, 90.00 FEET TO THE NORTHEAST CORNER OF LOT 12 OF SAID BLOCK 1; THENCE SOUTH 01°-03'-26" WEST, ALONG THE EAST LINE OF SAID LOT 12, 90.79 FEET TO THE SOUTHEAST CORNER OF SAID LOT 12; THENCE SOUTH 86°-15'-08" EAST, 30.04 FEET; THENCE SOUTH 01°-01'-54" WEST, 90.82 FEET TO THE NORTH RIGHT-OF-WAY LINE OF THE ALLEY FOR SAID BLOCK 1; THENCE SOUTH 86°-12'-34" EAST, ALONG SAID NORTH RIGHT-OF-WAY LINE, 60.16 FEET; THENCE NORTH 00°-58'-59" EAST, 181.73 FEET TO THE POINT OF BEGINNING.

LEGEND: These standard symbols may be found in the drawing.


- Lot Corner (Found) w/desc.
- Lot Corner (Set) w/desc.
- ⊕ Man Hole
- ⊗ Utility Pole

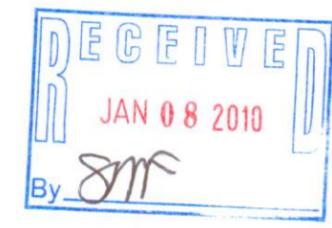

IF THE SURVEYOR'S SEAL IS NOT RED, THE PLAN IS A COPY THAT SHOULD BE ASSUMED TO CONTAIN UNAUTHORIZED ALTERATIONS. THE CERTIFICATION CONTAINED ON THIS DOCUMENT DOES NOT APPLY TO COPIES UNLESS THEY TOO HAVE A RED STAMP OVER THE PHOTOCOPIED STAMP BY SAME SURVEYOR.

OWNER: Barbara Fritzsching
717 E. Chicago St.
Whitewater, WI 53190

BEARINGS ARE REFERENCED TO THE SOUTH LINE OF BLOCK 1, SHOWN HEREON, AS FOUND MONUMENTED, WHICH IS ASSUMED TO BEAR S 86°-12'-34" E.

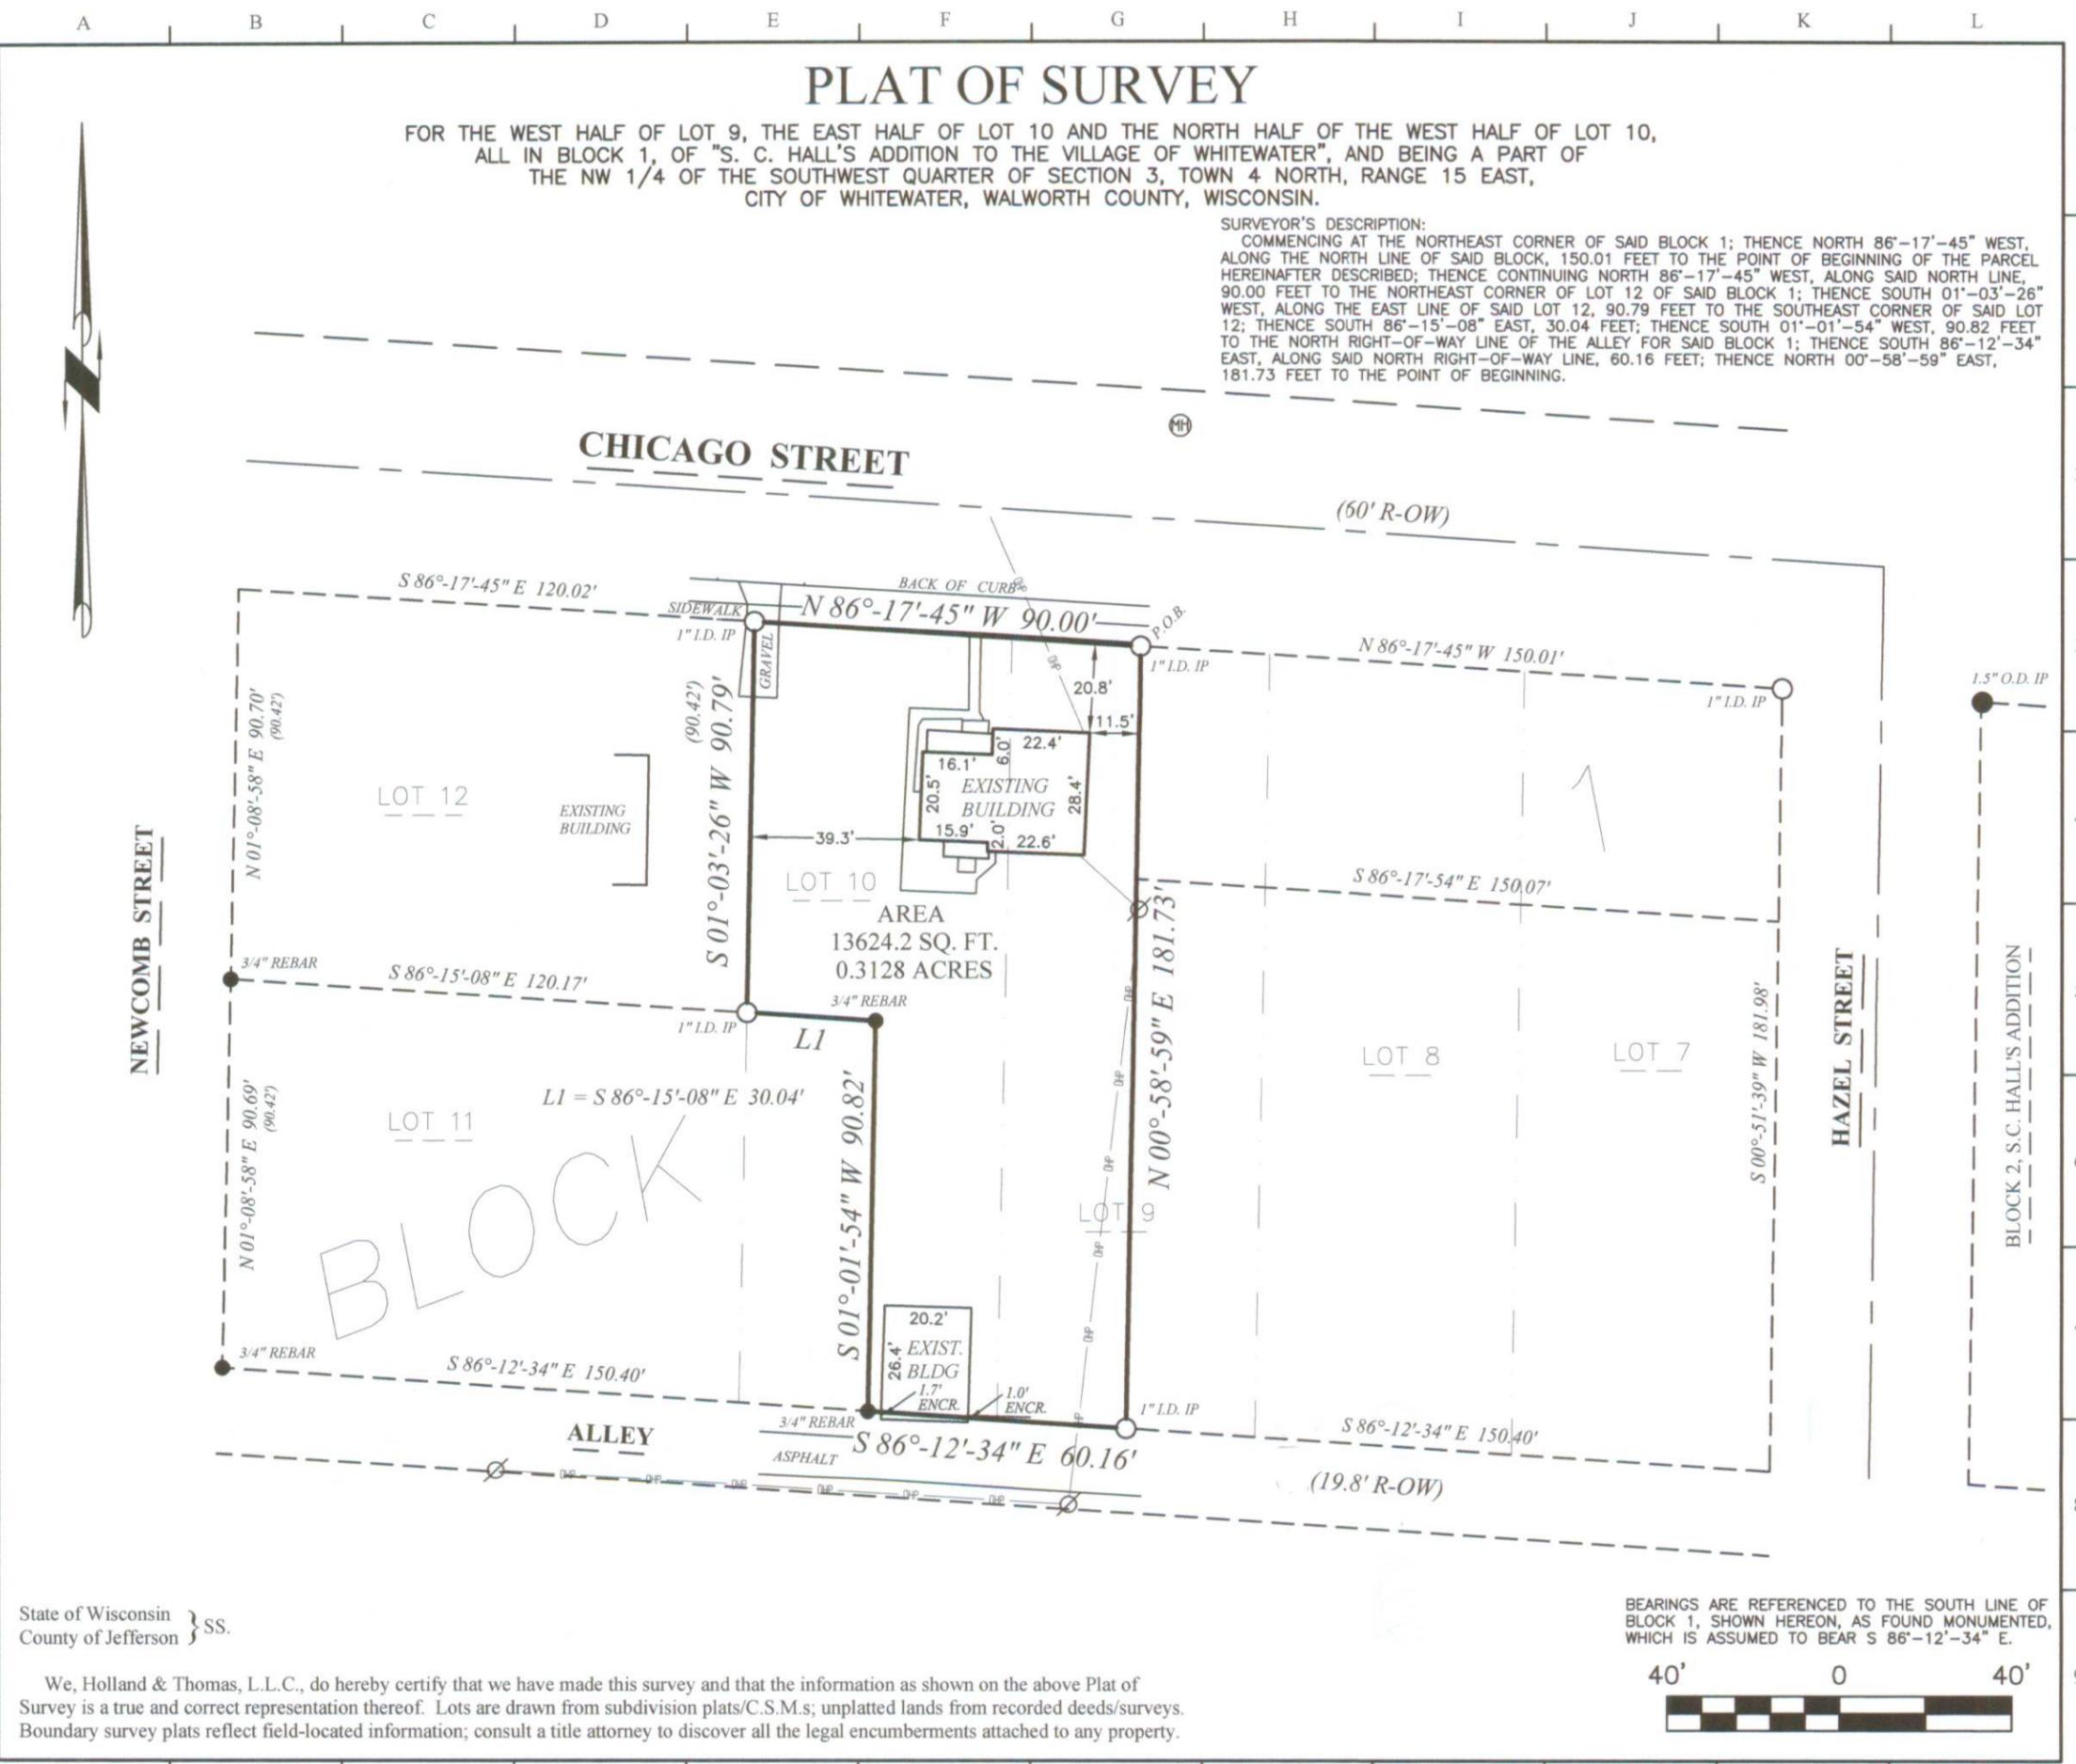

State of Wisconsin }
County of Jefferson } SS.

We, Holland & Thomas, L.L.C., do hereby certify that we have made this survey and that the information as shown on the above Plat of Survey is a true and correct representation thereof. Lots are drawn from subdivision plats/C.S.M.s; unplatted lands from recorded deeds/surveys. Boundary survey plats reflect field-located information; consult a title attorney to discover all the legal encumbrances attached to any property.

1/HAS-9

10-888

C:\Holland&Thomas\2009\0906\090606.dwg; Drawn By: NLH; Checked By: SDT; 07-02-09.